

WW-7
8-30-06

4706101913P



West Virginia Department of Environmental Protection
Office of Oil and Gas

WELL LOCATION FORM: GPS

API: 47-061-30442 WELL NO.: 8239

FARM NAME: J. LIMING

RESPONSIBLE PARTY NAME: WEST VIRGINIA LAND RESOURCES INC.

COUNTY: MONONGALIA DISTRICT: BATTELLE

QUADRANGLE: HUNDRED W.VA, PA

SURFACE OWNER: CAROL A. & KENNETH SENCAJ

ROYALTY OWNER: _____

UTM GPS NORTHING: 4,390,397 m

UTM GPS EASTING: 552,486 m GPS ELEVATION: 424 m

The Responsible Party named above has chosen to submit GPS coordinates in lieu of preparing a new well location plat for a plugging permit or assigned API number on the above well. The Office of Oil and Gas will not accept GPS coordinates that do not meet the following requirements:

1. Datum: NAD 1983, Zone: 17 North, Coordinate Units: meters, Altitude: height above mean sea level (MSL) -- meters.

2. Accuracy to Datum -- 3.05 meters

3. Data Collection Method:

Survey grade GPS _____: Post Processed Differential _____


Real-Time Differential _____

Mapping Grade GPS X: Post Processed Differential X

Real-Time Differential _____

4. Letter size copy of the topography map showing the well location.

I the undersigned, hereby certify this data is correct to the best of my knowledge and belief and shows all the information required by law and the regulations issued and prescribed by the Office of Oil and Gas.

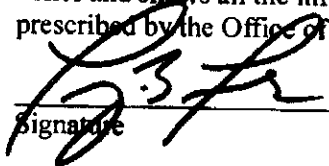
Signature

Professional Surveyor
Title

MARCH 6, 2022
Date


RECEIVED
Office of Oil and Gas

AUG 25 2022

WV Department of
Environmental Protection

09/09/2022

Well# 8239
HUNDRED WV, PA 7.5' Quad
Scale: 1" = 500'

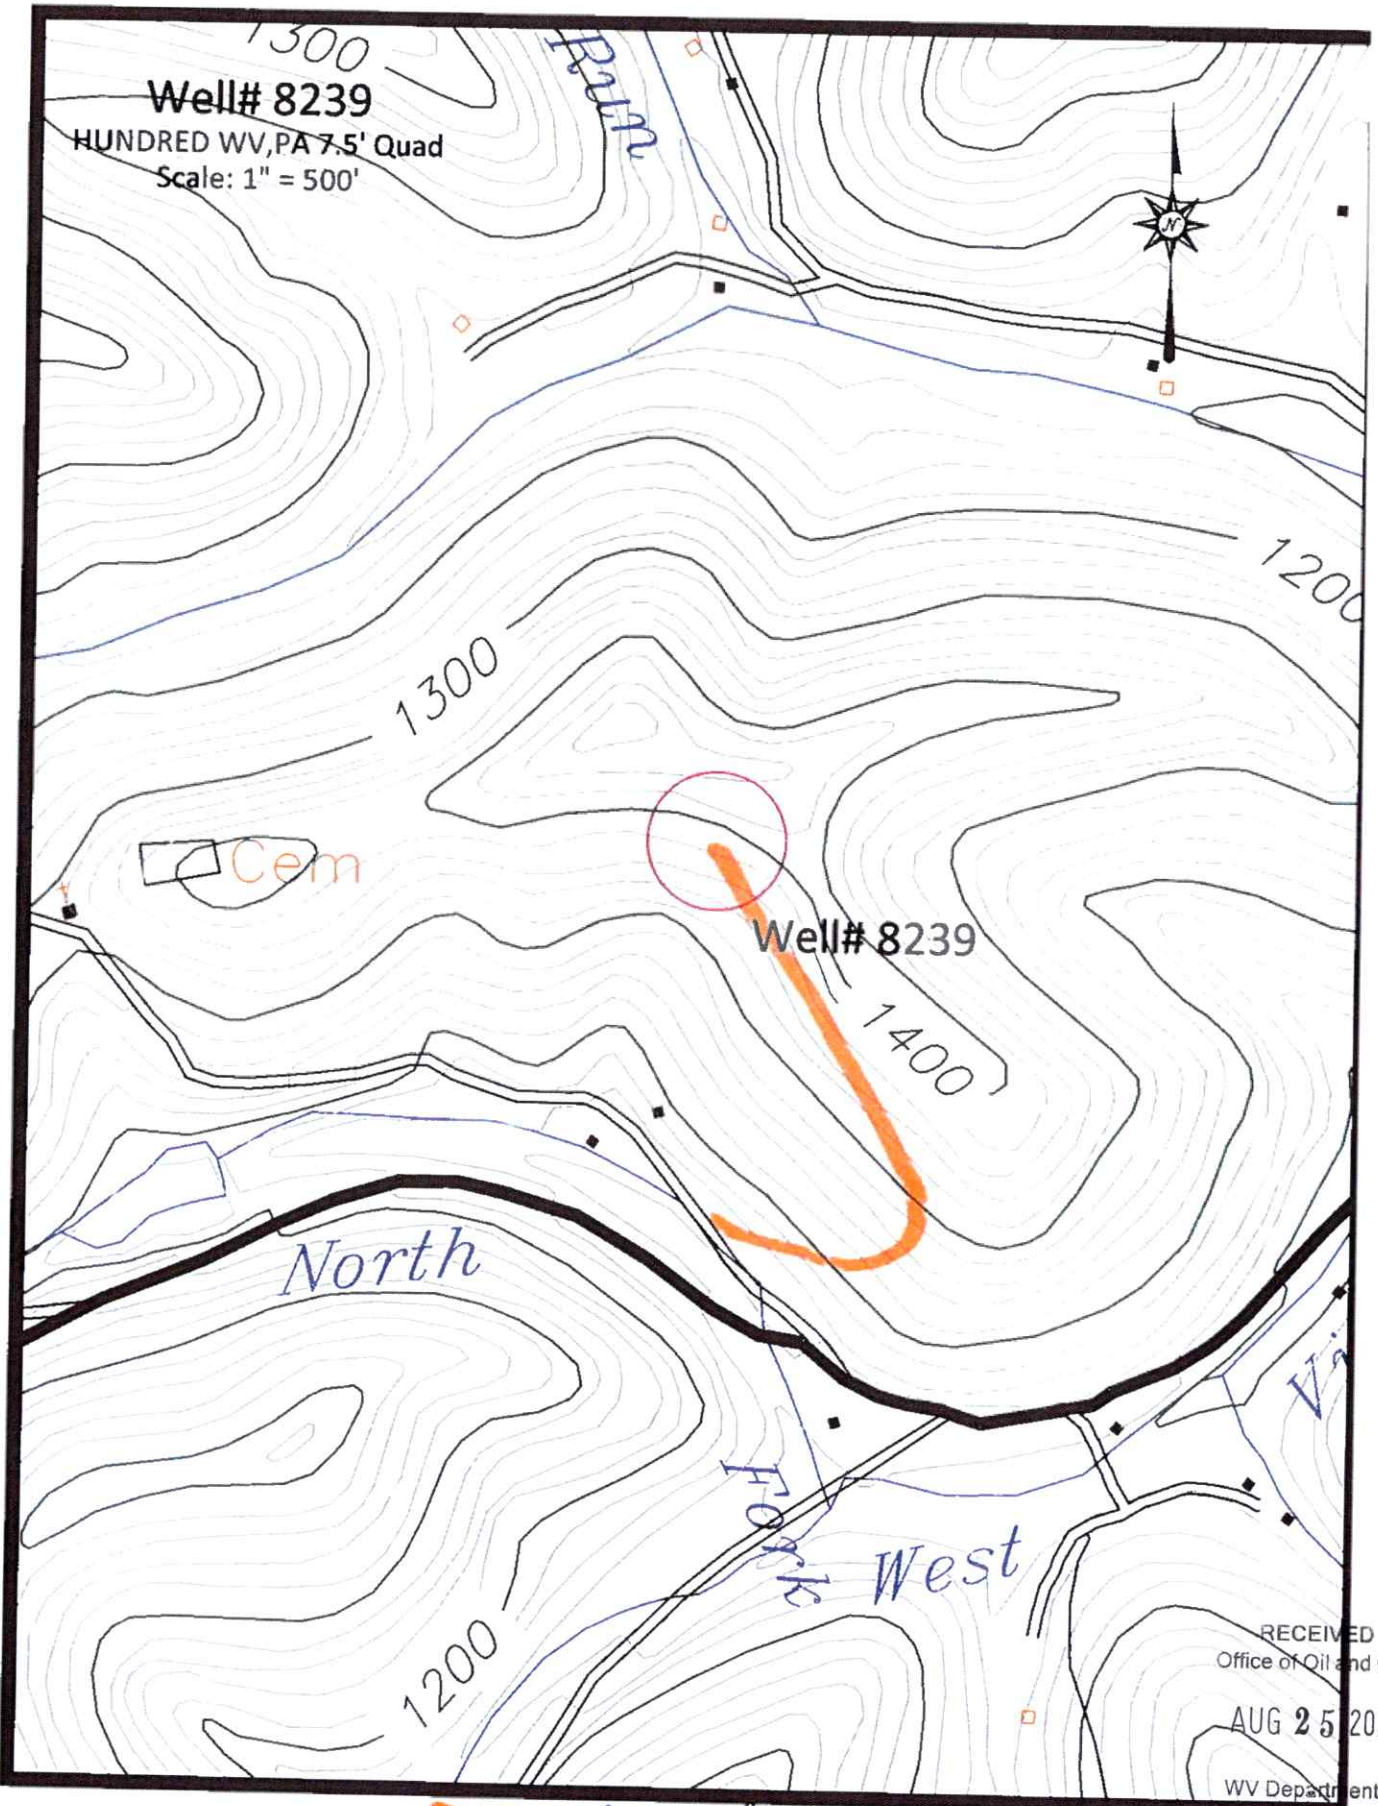

Access Road

RECEIVED
Office of Oil and Gas
AUG 25 2022
WV Department of
Environmental Protection

09/09/2022