



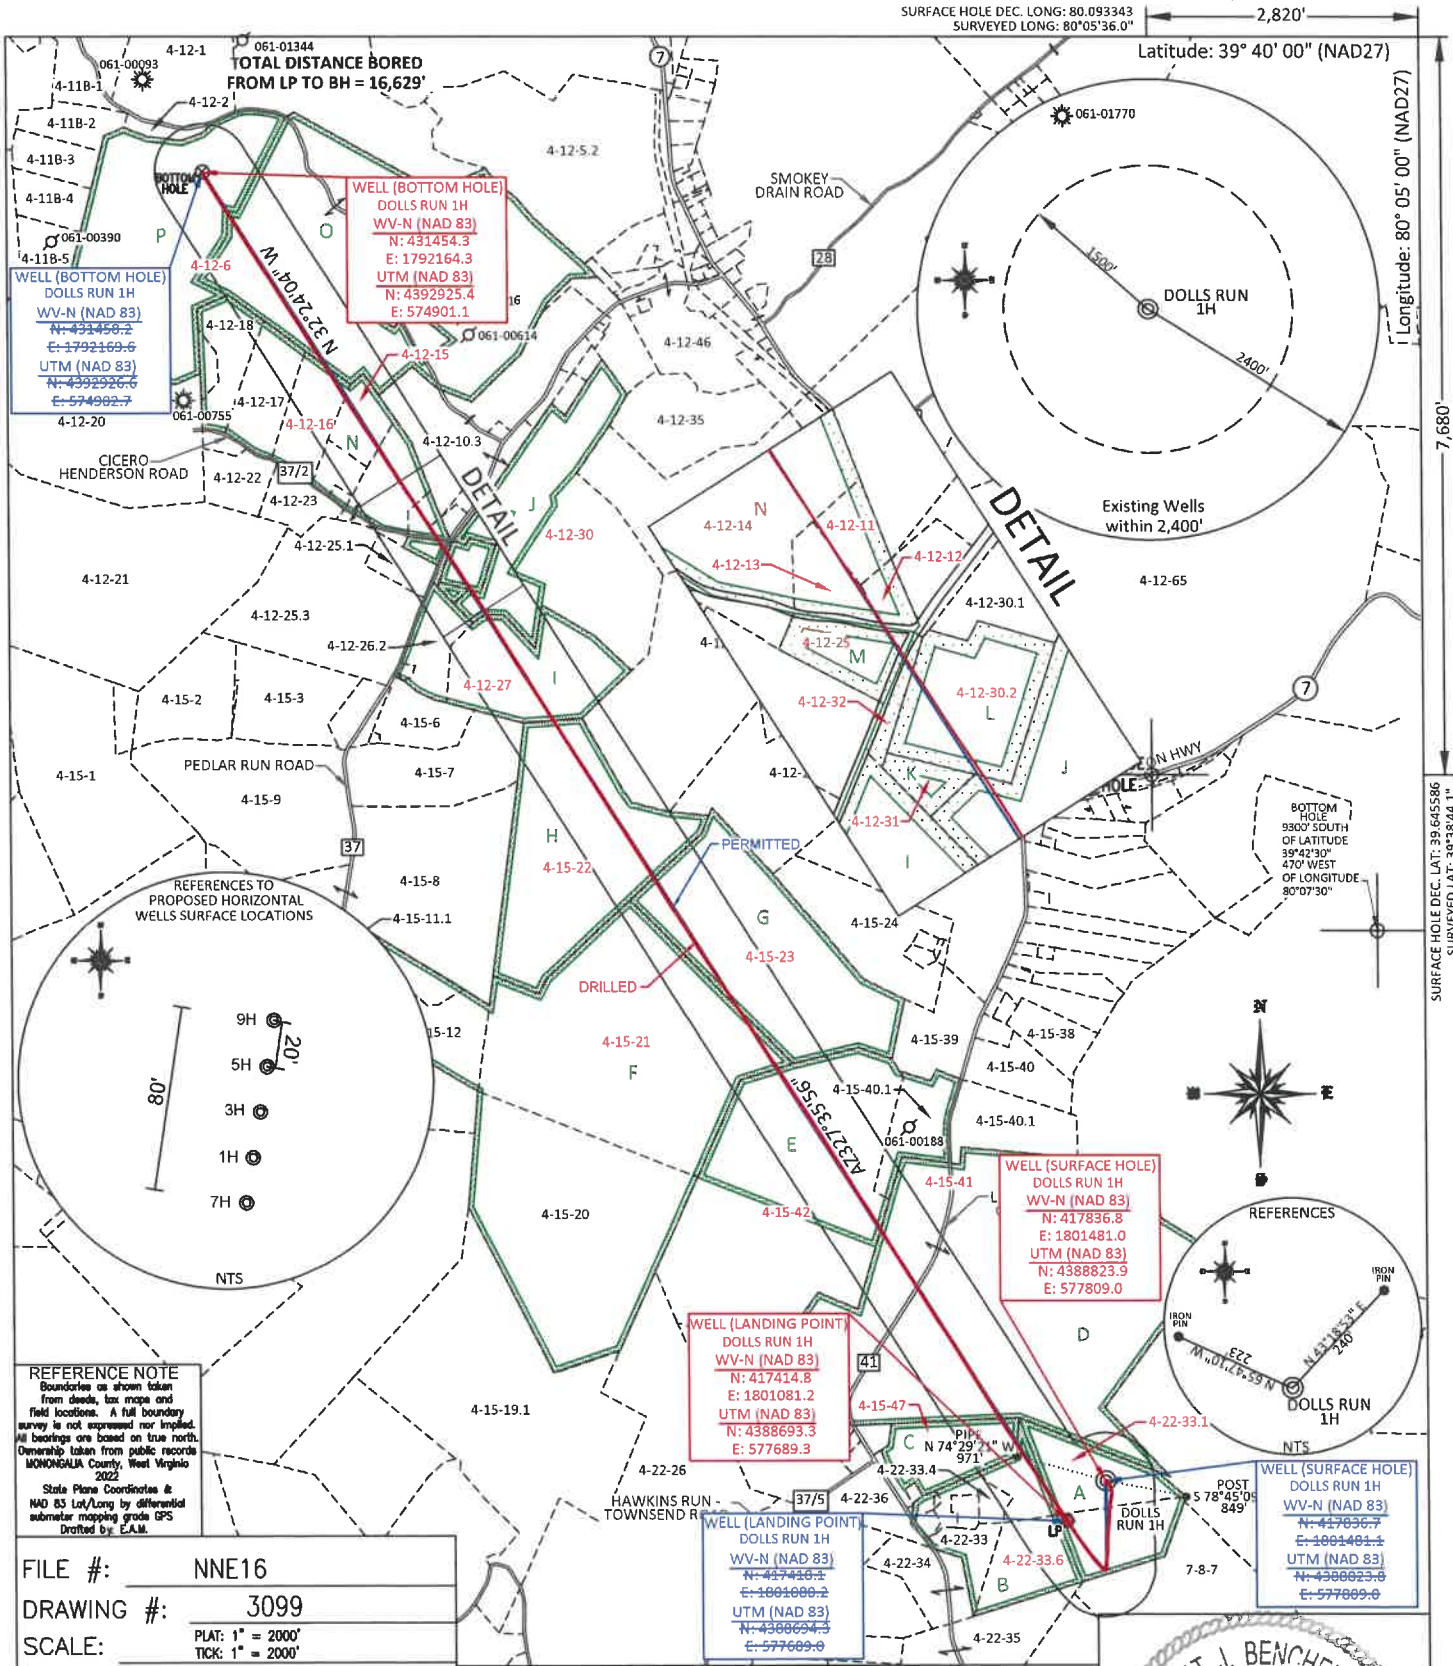

REFERENCE NOTE
Boundaries as shown taken from deeds, tax maps and field locations. A full boundary survey is not expressed nor implied. All bearings are based on true north. Ownership taken from public records MONONGALIA County, West Virginia 2022
State Plane Coordinates at NAD 83 Lat/Long by differential submeter mapping grade GPS Drafted by E.A.M.

FILE #: NNE16
DRAWING #: 3099
SCALE: PLAT: 1" = 2000'
TICK: 1" = 2000'
MINIMUM DEGREE OF ACCURACY: 1/200
PROVEN SOURCE OF ELEVATION: SUBMETER MAPPING GRADE GPS

PLAT IS CORRECT TO THE BEST OF MY KNOWLEDGE AND BELIEF AND SHOWS ALL THE INFORMATION REQUIRED BY LAW AND THE REGULATIONS ISSUED AND PRESCRIBED BY THE DEPARTMENT OF ENVIRONMENTAL PROTECTION.
Signed:
L.L.S. #2124 : Ernest J. Benchek III

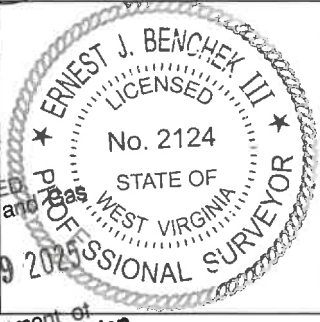

(+) DENOTES LOCATION OF WELL ON UNITED STATES TOPOGRAPHIC MAPS
WVDEP

OFFICE OF OIL & GAS
601 57TH STREET
CHARLESTON, WV 25304
Well Type: ☐ Oil ☐ Waste Diposal ☐ Production ☐ Deep
☒ Gas ☐ Liquid Injection ☐ Storage ☒ Shallow
WATERSHED: DUNKARD CREEK
COUNTY/DISTRICT: MONONGALIA / CLAY
SURFACE OWNER: BRYAN & SIERRA VANNORMAN
OIL & GAS ROYALTY OWNER: MARK V EDDY
LEASE NUMBERS:

DATE: FEBRUARY 2024
OPERATOR'S WELL #: DOLLS RUN 1H
API WELL #: 47 61 01914
STATE COUNTY PERMIT
AS-BUILT ELEVATION: 1,522.6'
QUADRANGLE: OSAGE
ACREAGE: 27.74
ACREAGE: 1,211.22+/-

DRILL ☒ CONVERT ☐ DRILL DEEPER ☐ REDRILL ☐ FRACTURE OR STIMULATE ☒
PLUG OFF FORMATION ☐ PERFORATE NEW FORMATION ☐ PLUG & ABANDON ☐
CLEAN OUT & REPLUG ☐ OTHER CHANGE ☐ (SPECIFY):
TARGET FORMATION: MARCELLUS
WELL OPERATOR: NORTHEAST NATURAL ENERGY LLC
ADDRESS: 707 VIRGINIA STREET EAST, SUITE 1200
CITY: CHARLESTON STATE: WV ZIP CODE: 25301
DRILLED DEPTH: TVD: 8,287' TMD: 25,281'
DESIGNATED AGENT: JOHN ADAMS
ADDRESS: 707 VIRGINIA STREET EAST, SUITE 1200
CITY: CHARLESTON STATE: WV ZIP CODE: 25301

	PROPERTY OWNER INDEX
4-22-33.1	BRYAN & SIERRA VANNORMAN
4-22-33.6	DANIEL D. & MARTHA P. SPERANDIO
4-15-47	MARVIN E. MORRIS
4-15-41	DONNA N. & ROBERT ALLEN WRIGHT
4-15-42	STATE OF WEST VIRGINIA BUREAU OF COMMERCE
4-15-21	STATE OF WEST VIRGINIA BUREAU OF COMMERCE
4-15-22	MARK V. & BETTY A. EDDY
4-15-23	STATE OF WEST VIRGINIA BUREAU OF COMMERCE
4-12-27	ROBERT I. JONES
4-12-30	ROBERT C. WALLS FAMILY TRUST
4-12-31	ROBERT C. & DIANA WALLS
4-12-30.2	ROBERT C. WALLS
4-12-32	ROBERT C. & DIANA WALLS
4-12-25	JOY HENDERSON & KIMBERLY SCHNAPP
4-12-12	VICTORIO & PERLA C. CARREON
4-12-13	JOHANNA LEA MULL
4-12-11	JOHANNA LEA MULL
4-12-14	EDWARD F. & CATHY W. JERNELL
4-12-15	JOSHUA MICHAEL SANDONE
4-12-16	HARRY L. CHAMBERS
4-12-6	ALPHEUS MICHAEL HENDERSON

LEASE INDEX			
A	WV-061-004020-000	I	WV-061-005963-003
B	WV-061-004020-000	J	WV-061-006045-001
C	WV-061-005830-001	K	WV-061-006010-001
D	WV-061-005246-002	L	WV-061-005516-002
E	WV-061-004237-001	M	WV-061-003963-001
F	WV-061-004240-001	N	WV-061-003475-015
G	WV-061-001575-014	O	WV-061-004058-000
H	WV-061-004255-001	P	WV-061-004058-000

09/19/2025

FILE #: <u>NEE14</u>	DATE: <u>FEBRUARY 12, 2024</u>
DRAWING #: <u>3099</u>	OPERATOR'S WELL #: <u>DOLLS RUN 1H</u>
SCALE: <u>N/A</u>	API WELL #: <u>47</u> <u>61</u> <u>01914</u> STATE COUNTY PERMIT