

WW-7
8-30-06

4706101915P



West Virginia Department of Environmental Protection
Office of Oil and Gas

WELL LOCATION FORM: GPS

API: 47-061-70175 WELL NO.: 8200

FARM NAME: JOHN S. LEMLEY

RESPONSIBLE PARTY NAME: WEST VIRGINIA LAND RESOURCES INC.

COUNTY: MONONGALIA DISTRICT: BATTELLE

QUADRANGLE: HUNDRED W.VA,PA

SURFACE OWNER: ENVIRO CON LTD. (LIFE ESTHER H. CLARK)

ROYALTY OWNER: _____

UTM GPS NORTHING: 4,389,642 m (1197.2')

UTM GPS EASTING: 552,408 m GPS ELEVATION: 365 m

The Responsible Party named above has chosen to submit GPS coordinates in lieu of preparing a new well location plat for a plugging permit or assigned API number on the above well. The Office of Oil and Gas will not accept GPS coordinates that do not meet the following requirements:

- Datum: NAD 1983, Zone: 17 North, Coordinate Units: meters, Altitude: height above mean sea level (MSL) – meters.
- Accuracy to Datum – 3.05 meters
- Data Collection Method:

Survey grade GPS _____: Post Processed Differential _____
 _____ Real-Time Differential _____
 Mapping Grade GPS X: Post Processed Differential X
 _____ Real-Time Differential _____

RECEIVED
Office of Oil and Gas

OCT 13 2022

WV Department of
Environmental Protection

- Letter size copy of the topography map showing the well location.

I the undersigned, hereby certify this data is correct to the best of my knowledge and belief and shows all the information required by law and the regulations issued and prescribed by the Office of Oil and Gas.

Professional Surveyor

SEPTEMBER 20, 2022


Signature

Title

Date

12/09/2022

4706101915P

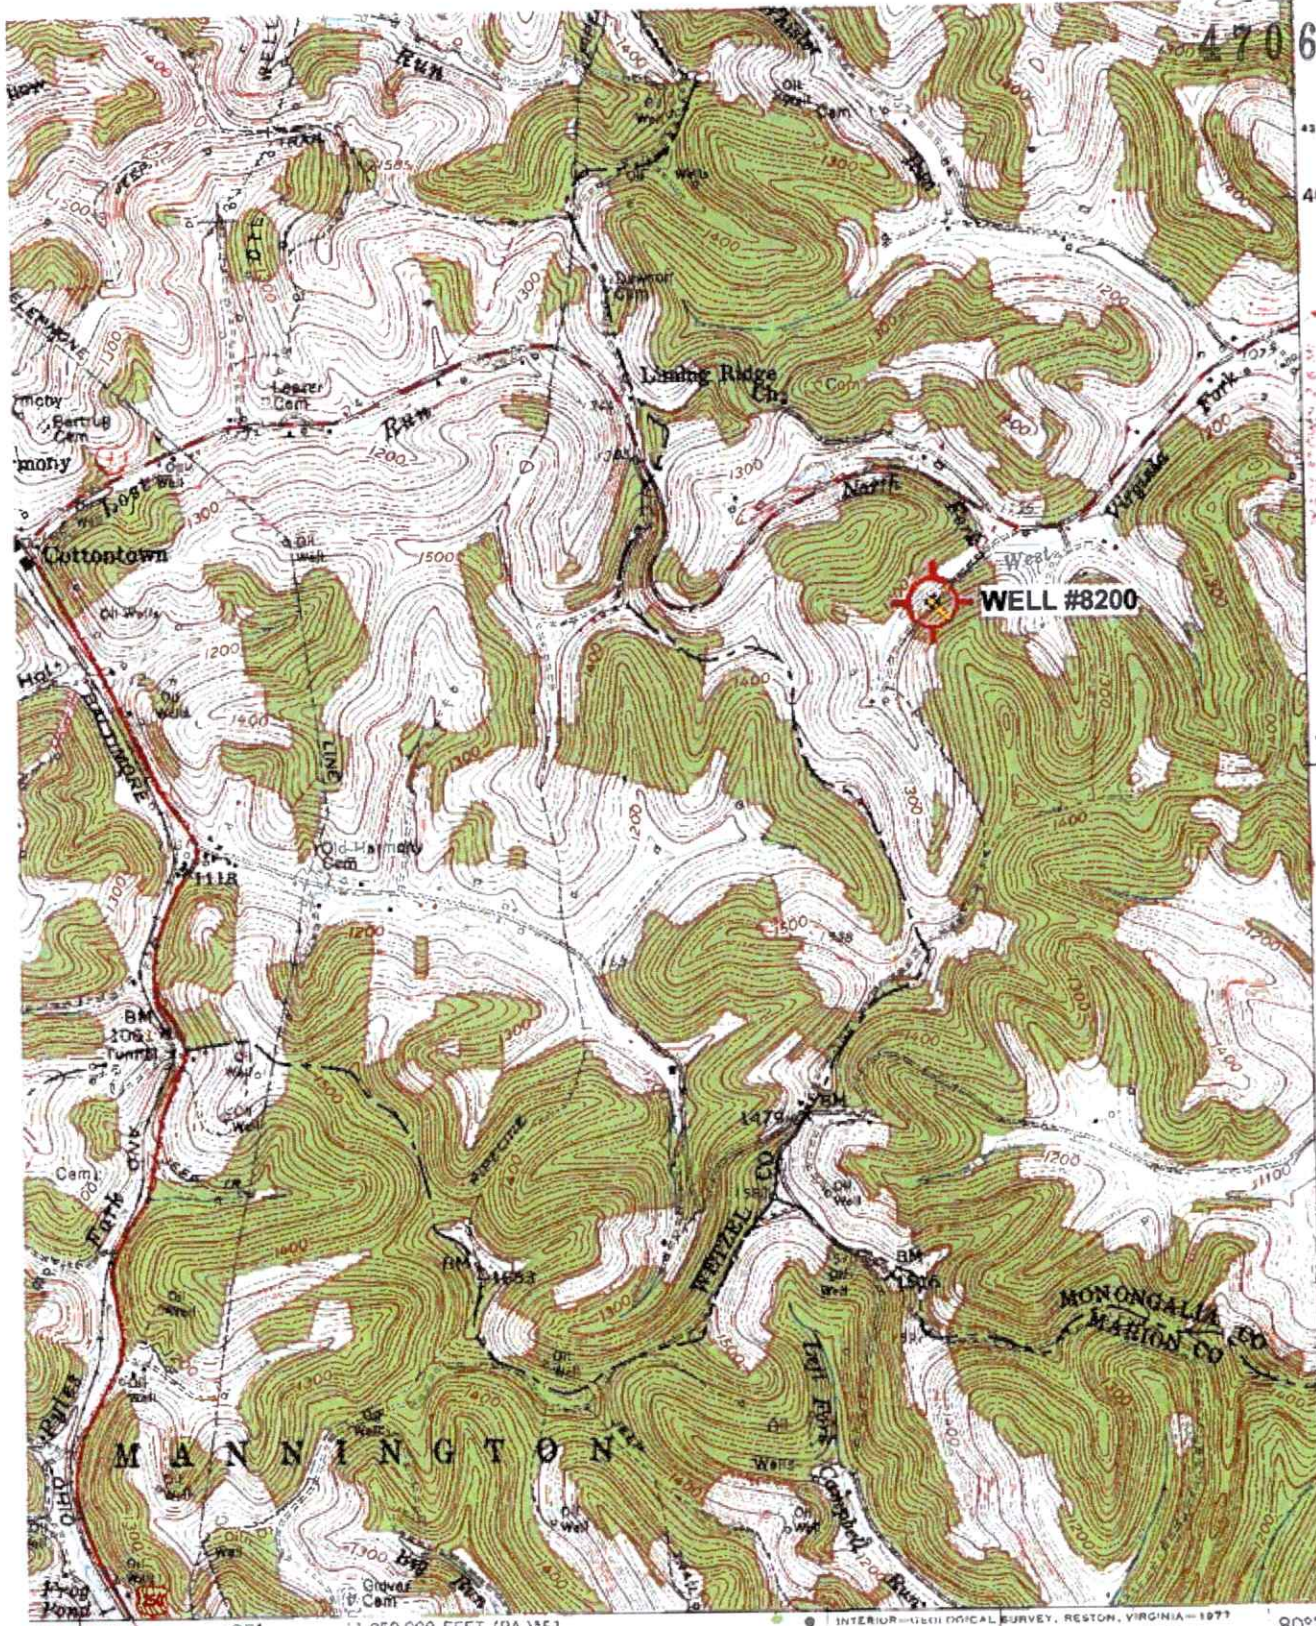

4391
40'

4389

4388000mN

120 000 FEET (PA.)

39°31'30"
80°22'30"

GAP 15 MI.
ONT 23 MI.

25' 1:125 000 FEET (PA.)#51

INTERIOR GEOLOGICAL SURVEY, RESTON, VIRGINIA—1977
852

RECEIVED
Office of Oil and Gas
OCT 13 2022
(MANNINGTON)
4563 III SE



| ROAD CLASSIFICATION | |
|---------------------|-----------------|
| Heavy duty | Light duty |
| Medium-duty | Unimproved dirt |
| U.S. Route | State Route |

WV Department of Environmental Protection



HUNDRED, W. VA.—PA.
NW/4 MANNINGTON 15' QUADRANGLE
N 3937.5—W 8022.5/7.5

12/09/2022

'Hundred; WV,PA' Scale: 1" = 0.379Mi 610Mt 2,000Ft, 1 Mi = 2.640" , 1 cm = 240Mt