


FILE #: NNE20
 DRAWING #: 3048
 SCALE: PLAT: 1" = 2000'
TICK: 1" = 2000'
 MINIMUM DEGREE OF ACCURACY: 1/200
 PROVEN SOURCE OF ELEVATION: SUBMETER MAPPING GRADE GPS

I, THE UNDERSIGNED, HEREBY CERTIFY THAT THIS PLAT IS CORRECT TO THE BEST OF MY KNOWLEDGE AND BELIEF AND SHOWS ALL THE INFORMATION REQUIRED BY LAW AND THE REGULATIONS ISSUED AND PRESCRIBED BY THE DEPARTMENT OF ENVIRONMENTAL PROTECTION.

Signed: [Signature]
 L.L.S. #2124 : Ernest J. Benchek III

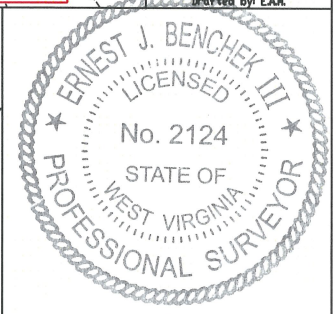

(+) DENOTES LOCATION OF WELL ON UNITED STATES TOPOGRAPHIC MAPS
WVDEP
OFFICE OF OIL & GAS
 601 57TH STREET
 CHARLESTON, WV 25304

Well Type: Oil Waste Diposal Production Deep
 Gas Liquid Injection Storage Shallow

WATERSHED: UPPER MONONGAHELA RIVER AS-BUILT ELEVATION: 1,476'

COUNTY/DISTRICT: MONONGALIA / CLAY QUADRANGLE: GRANT TOWN

SURFACE OWNER: ALAN SULLIVAN ACREAGE: 1,124.250 +/-

OIL & GAS ROYALTY OWNER: ALAN SULLIVAN ACREAGE: 25.870 02/23/2024

LEASE NUMBERS: _____

DRILL CONVERT DRILL DEEPER REDRILL FRACTURE OR STIMULATE
 PLUG OFF FORMATION PERFORATE NEW FORMATION PLUG & ABANDON
 CLEAN OUT & REPLUG OTHER CHANGE (SPECIFY): _____

TARGET FORMATION: MARCELLUS DRILLED DEPTH: TVD: 8,172' TMD: 20,963'

WELL OPERATOR: NORTHEAST NATURAL ENERGY LLC DESIGNATED AGENT: JOHN ADAMS
 ADDRESS: 707 VIRGINIA STREET EAST, SUITE 1200 ADDRESS: 707 VIRGINIA STREET EAST, SUITE 1200
 CITY: CHARLESTON STATE: WV ZIP CODE: 25301 CITY: CHARLESTON STATE: WV ZIP CODE: 25301

4-26-35	RANDY LEE & TRINA TENNANT
4-19-30	BILLIE & JEFFERSON PRICE
4-19-27	JAMES TENNANT
4-19-31	JIMMY R & PAMELA K TENNANT; BILLY RAY & ROXANA CAHILL
4-19-48	JAMES F & LINDA KARUS
4-26-38	ADAM CLAY DARRAH
4-19-49	MICHAEL J LATOCHA
4-26-21	MARVIN L WILSON II
4-26-22	LINDA KAY FOGT
4-26-19	LINDA R PARKER
4-26-19.1	SANDRA L LONG
4-19-24	EDITH L DARRAH
4-26-27	NNE MIDSTREAM LLC
4-26-12	KENNETH W & RUTH E ALBERT
4-26-35.1	ALAN SULLIVAN
4-26-26	NNE MIDSTREAM LLC
4-26-20	KENNETH W & RUTH E ALBERT
4-19-6	JIMMY R & PAMELA K TENNANT; RAY & ROXANA CAHILL
4-19-7	STEPHEN R WILSON, ET AL
4-19-4.1	KEMBLE D TATE

LEASE INDEX			
A	WV-061-000160-001-ACT	K	WV-061-003931-001
B	WV-061-000160-001-ACT	L	WV-061-003931-011
C	WV-061-005448-002	M	WV-061-003931-011
D	WV-061-000160-001-ACT	N	WV-061-006350-001
E	WV-061-000160-001-ACT	O	WV-061-003931-011
F	WV-061-005998-001	P	WV-061-003931-011
G	WV-061-000160-001-ACT	Q	WV-061-005906-004
H	WV-061-000160-001-ACT	R	WV-061-005906-004
I	WV-061-000160-001-ACT	S	WV-061-005876-002
J	WV-061-001851-0014		

02/23/2024

FILE #: NEE20

DRAWING #: 3048

SCALE: N/A

DATE: FEBRUARY 5, 2024

OPERATOR'S WELL #: SULLIVAN 5H AS-DRILLED

API WELL #: 47 61 01918
STATE COUNTY PERMIT