
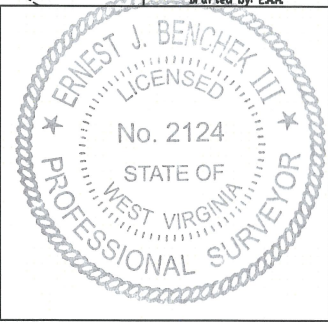


FILE #: NNE20
 DRAWING #: 3051
 SCALE: PLAT: 1" = 2000'
 TICK: 1" = 2000'
 MINIMUM DEGREE OF ACCURACY: 1/200
 PROVEN SOURCE OF ELEVATION: SUBMETER MAPPING GRADE GPS

I, THE UNDERSIGNED, HEREBY CERTIFY THAT THIS PLAT IS CORRECT TO THE BEST OF MY KNOWLEDGE AND BELIEF AND SHOWS ALL THE INFORMATION REQUIRED BY LAW AND THE REGULATIONS ISSUED AND PRESCRIBED BY THE DEPARTMENT OF ENVIRONMENTAL PROTECTION.
 Signed: 
 L.L.S. #2124 : Ernest J. Benchek III



(+) DENOTES LOCATION OF WELL ON UNITED STATES TOPOGRAPHIC MAPS
 WYDEP
 OFFICE OF OIL & GAS
 601 57TH STREET
 CHARLESTON, WV 25304

DATE: FEBRUARY 6, 2024
 OPERATOR'S WELL #: SULLIVAN 7H AS-DRILLED
 API WELL #: 47 61 01919
 STATE COUNTY PERMIT

Well Type: Oil Waste Diposal Production Deep
 Gas Liquid Injection Storage Shallow

WATERSHED: UPPER MONONGAHELA RIVER AS-BUILT ELEVATION: 1,476'
 COUNTY/DISTRICT: MONONGALIA / CLAY QUADRANGLE: GRANT TOWN
 SURFACE OWNER: ALAN SULLIVAN ACREAGE: 843.32 +/-
 OIL & GAS ROYALTY OWNER: ALAN SULLIVAN ACREAGE: 25.870 02/23/2024
 LEASE NUMBERS: _____

DRILL CONVERT DRILL DEEPER REDRILL FRACTURE OR STIMULATE
 PLUG OFF FORMATION PERFORATE NEW FORMATION PLUG & ABANDON
 CLEAN OUT & REPLUG OTHER CHANGE (SPECIFY): _____

TARGET FORMATION: MARCELLUS DRILLED DEPTH: TVD: 8,220' TMD: 21,613'
 WELL OPERATOR: NORTHEAST NATURAL ENERGY LLC DESIGNATED AGENT: JOHN ADAMS
 ADDRESS: 707 VIRGINIA STREET EAST, SUITE 1200 ADDRESS: 707 VIRGINIA STREET EAST, SUITE 1200
 CITY: CHARLESTON STATE: WV ZIP CODE: 25301 CITY: CHARLESTON STATE: WV ZIP CODE: 25301

4-18-12	LEE ANN SHUMILOFF
4-19-33	BRYAN D TENNANT
4-19-32	SHERI K CORDER
4-19-45	ROCKY & CATHY J BARR
4-19-51	AMANDA PAULETTE; LINDA JANE; TERESA DARLENE POLANSKY
4-26-44	RODNEY EDWARD & HEATHER ANNE ROBINSON
4-25-2	ORVILLE W BELL JR & RENEE D LOAR
4-26-36	LARRY NOLAN & LINDA MAE PAYTON
4-26-38	ADAM CLAY DARRAH
4-26-35.1	ALAN SULLIVAN
4-26-26	NNE MIDSTREAM LLC
4-19-32.1	JIMMY R & PAMELA K TENNANT; BILLY RAY & ROXANA CAHILL
4-19-32.2	JIMMY RANDALL TENNANT
4-19-31.4	PAMELA K TENNANT
4-19-42.1	THOMAS J & DIANN M ZYRA
4-19-50	ROCKY & CATHY J BARR
4-26-39	ADAM CLAY DARRAH
4-19-52	LARRY F & BRENDA KAY KUHN

LEASE INDEX			
A	WV-061-000160-001-ACT	H	WV-061-004588-002
B	WV-061-000160-001-ACT	I	WV-061-006016-001
C	WV-061-005448-002	J	WV-061-005475-001
D	WV-061-005961-002	K	WV-061-006016-001
E	WV-061-004442-001	L	WV-061-004519-000
F	WV-061-000171-002		
G	WV-061-003931-010		

02/23/2024

FILE #: <u>NEE20</u>	DATE: <u>FEBRUARY 5, 2024</u>
DRAWING #: <u>3051</u>	OPERATOR'S WELL #: <u>SULLIVAN 7H AS-DRILLED</u>
SCALE: <u>N/A</u>	API WELL #: <u>47</u> <u>61</u> <u>01919</u> STATE COUNTY PERMIT