


FILE #: NNE20
 DRAWING #: 3047
 SCALE: PLAT: 1" = 2000', TICK: 1" = 2000'
 MINIMUM DEGREE OF ACCURACY: 1/200
 PROVEN SOURCE OF ELEVATION: SUBMETER MAPPING GRADE GPS

I, THE UNDERSIGNED, HEREBY CERTIFY THAT THIS PLAT IS CORRECT TO THE BEST OF MY KNOWLEDGE AND BELIEF AND SHOWS ALL THE INFORMATION REQUIRED BY LAW AND THE REGULATIONS ISSUED AND PRESCRIBED BY THE DEPARTMENT OF ENVIRONMENTAL PROTECTION.
 Signed: *[Signature]*
 L.L.S. #2124 : Ernest J. Benchek III

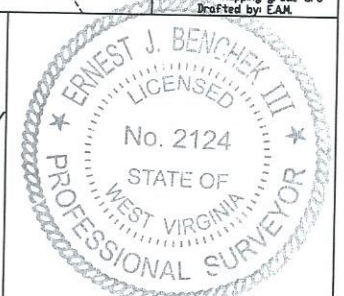

(+) DENOTES LOCATION OF WELL ON UNITED STATES TOPOGRAPHIC MAPS
 WVDEP
 OFFICE OF OIL & GAS
 601 57TH STREET
 CHARLESTON, WV 25304
 Well Type: Oil Waste Diposal Production Deep Gas Liquid Injection Storage Shallow

WATERSHED: UPPER MONONGAHELA RIVER
 COUNTY/DISTRICT: MONONGALIA / CLAY
 SURFACE OWNER: ALAN SULLIVAN
 OIL & GAS ROYALTY OWNER: ALAN SULLIVAN
 LEASE NUMBERS:

DATE: FEBRUARY 6, 2024
 OPERATOR'S WELL #: SULLIVAN 9H AS-DRILLED
 API WELL #: 47 61 01920
 STATE COUNTY PERMIT
 AS-BUILT ELEVATION: 1,476'
 QUADRANGLE: GRANT TOWN
 ACREAGE: 870.94 +/-
 ACREAGE: 25.870 **03/22/2024**

DRILL CONVERT DRILL DEEPER REDRILL FRACTURE OR STIMULATE
 PLUG OFF FORMATION PERFORATE NEW FORMATION PLUG & ABANDON
 CLEAN OUT & REPLUG OTHER CHANGE (SPECIFY):
 TARGET FORMATION: MARCELLUS
 WELL OPERATOR: NORTHEAST NATURAL ENERGY LLC
 ADDRESS: 707 VIRGINIA STREET EAST, SUITE 1200
 CITY: CHARLESTON STATE: WV ZIP CODE: 25301
 DRILLED DEPTH: TVD: 8,200' TMD: 21,813'
 DESIGNATED AGENT: JOHN ADAMS
 ADDRESS: 707 VIRGINIA STREET EAST, SUITE 1200
 CITY: CHARLESTON STATE: WV ZIP CODE: 25301

4-19-14	PENNY S QUICKLE
4-19-23	BOYD & MARY STARKEY ESTATE
4-26-35	RANDY LEE & TRINA TENNANT
4-26-34	SHIRLEY J NEELY, DEANNA M FRAZIER, DONNA J WALDEN & DARRIN NEELY
4-26-18	ROSE MARIE FLUHARTY
4-26-30	THOMAS R & LISA A LUZADER
4-26-38	ADAM CLAY DARRAH
4-26-30.2	WAYNE WHIPKEY
4-26-17	ROSE MARIE FLUHARTY
4-26-29	WAYNE WHIPKEY
4-19-14.2	PENNY S QUICKLE
4-19-26	CHARLES W MOORE; JASON T & KIRSTON KARSON (LIFE)
4-19-24	EDITH L DARRAH
4-19-25	SHIRLEY L MOORE ESTATE
4-19-49	ROCKY & CATHY J BARR
4-26-12	KENNETH W & RUTH E ALBERT
4-26-35.1	ALAN SULLIVAN
4-26-26	NNE MIDSTREAM LLC
4-26-20	KENNETH W & RUTH E ALBERT
4-19-6	JIMMY R & PAMELA K TENNANT; RAY & ROXANA CAHILL
4-19-7	STEPHEN R WILSON, ET AL
4-19-1.1	KEMBLE D TATE

LEASE INDEX			
A	WV-061-000160-001-ACT	I	WV-061-003931-001
B	WV-061-005448-002	J	WV-061-003931-011
C	WV-061-000160-001-ACT	K	WV-061-003931-002
D	WV-061-000165-001 - LA	L	WV-061-000160-001-ACT
E	WV-061-000160-001-ACT	M	WV-061-003931-011
F	WV-061-005998-001	N	WV-061-000160-001-ACT
G	WV-061-004797-039	O	WV-061-004792-004
H	WV-061-000160-001-ACT	P	WV-061-005788-001
		Q	WV-061-005876-002

03/22/2024

FILE #: <u>NEE20</u>	DATE: <u>FEBRUARY 5, 2024</u>
DRAWING #: <u>3047</u>	OPERATOR'S WELL #: <u>SULLIVAN 9H AS-DRILLED</u>
SCALE: <u>N/A</u>	API WELL #: <u>47</u> <u>61</u> <u>01920</u> STATE COUNTY PERMIT