


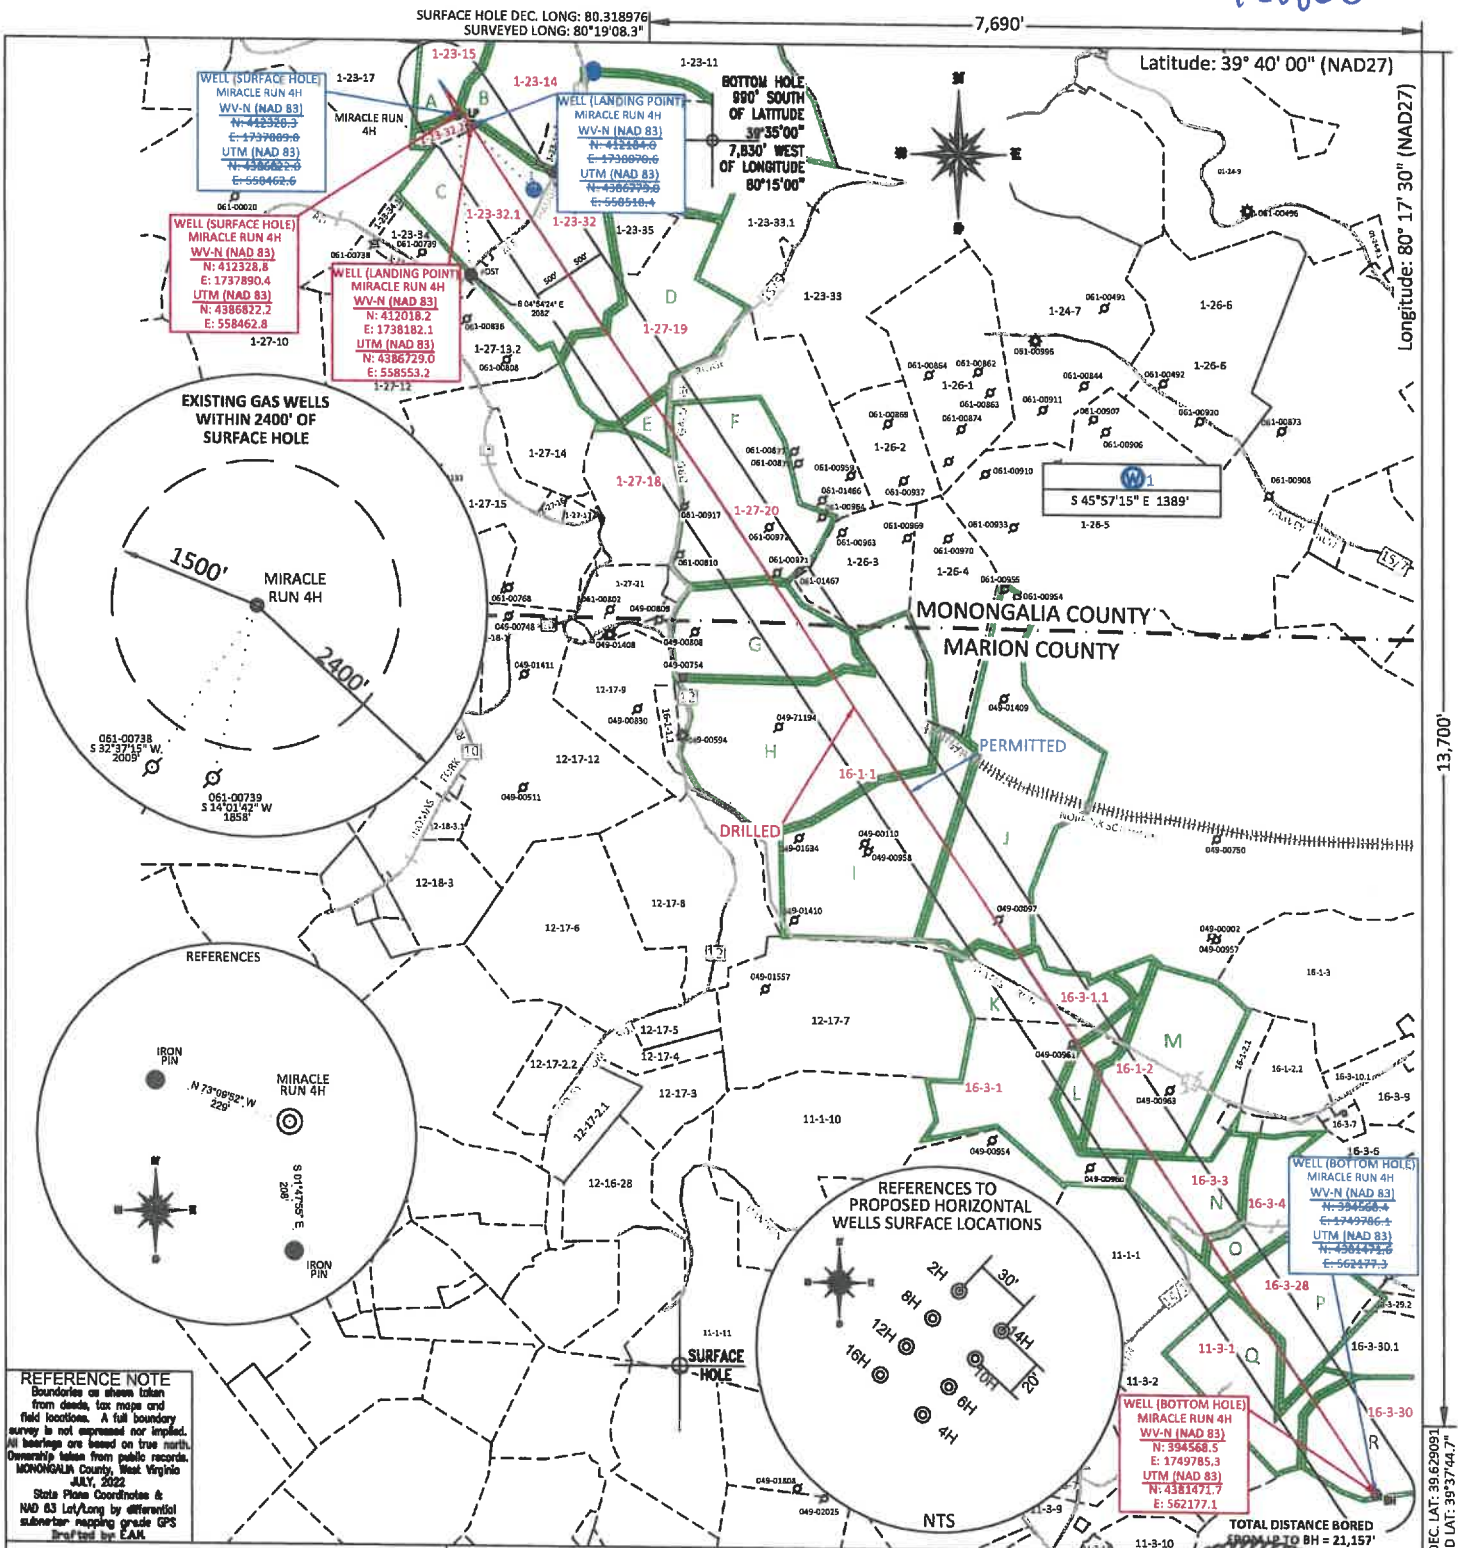

PROPERTY INDEX	
1-23-14	CLAUDE S & JONI L ANDERSON
1-23-15	CLAUDE S & JONI L ANDERSON
1-23-32	BYRON LANE RAPP
1-23-32.2	NORTHEAST NATURAL ENERGY LLC
1-27-19	CNX LAND LLC
1-27-18	SHIRLEY S WALKER
1-27-20	CONSOL MINING COMPANY LLC
16-1-1	MARION COUNTY COAL RESOURCES INC
16-3-1.1	DAVE L & DIANA L MCDOUGAL
16-1-2	JAMES A TENNANT & KIM M DENSON
16-3-1	DAVID P & LINDA M AINSWORTH
16-3-3	RALPH & ZORA SHRIVER
16-3-4	WACO OIL & GAS
16-3-28	CHARLES L & SUSAN L UNDERWOOD ETAL
11-3-1	DENZIL L PARKER; EMMA L & ALLEN L PARKER
16-3-30	CHARLES L & SUSAN L UNDERWOOD ETAL

LEASE INDEX			
A	WV-061-003830-005	J	WV-061-006503-001
B	WV-061-003828-007	K	WV-049-086187-001
C	WV-061-005463-023	L	WV-049-086187-001
D	WV-061-006519-001	M	WV-049-086168-003
E	WV-061-006233-001	N	WV-061-000198-001-LOI
F	WV-061-004692-002	O	WV-049-086145-001
G	WV-049-104625-002	P	WV-049-106192-001
H	WV-061-000198-001-LOI	Q	WV-049-086214-001
I	WV-049-004839-001; WV-049-004839-002	R	WV-049-106399-001

09/19/2025

FILE #: NEE20
DRAWING #: 3092
SCALE: N/A

DATE: MAY 12, 2025
OPERATOR’S WELL #: MIRACLE RUN 4H
API WELL #: 47 61 01923
STATE COUNTY PERMIT