



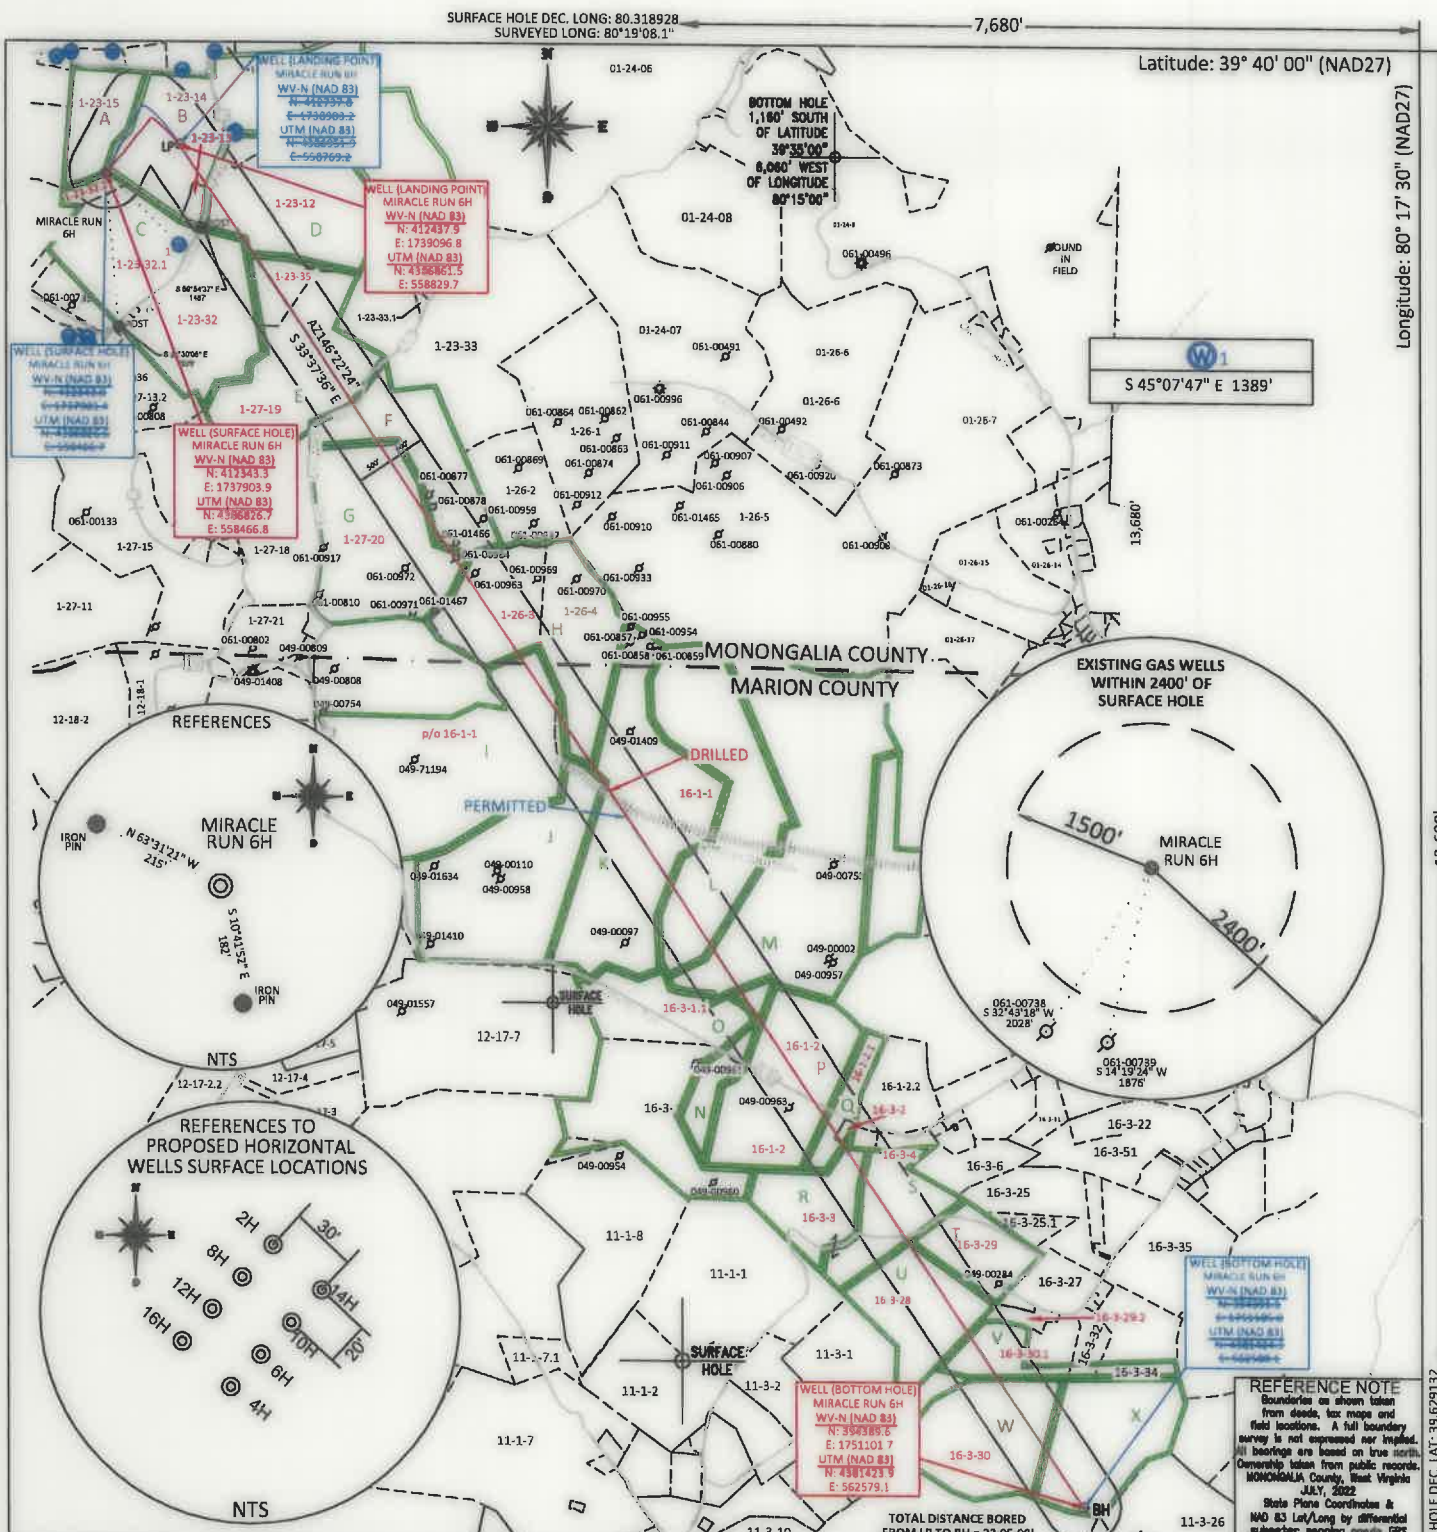

FILE #: NNE20		I, THE UNDERSIGNED, HEREBY CERTIFY THAT THIS PLAT IS CORRECT TO THE BEST OF MY KNOWLEDGE AND BELIEF AND SHOWS ALL THE INFORMATION REQUIRED BY LAW AND THE REGULATIONS ISSUED AND PRESCRIBED BY THE DEPARTMENT OF ENVIRONMENTAL PROTECTION.		
DRAWING #: 3093				
SCALE: PLAT: 1" = 2000' TICK: 1" = 2000'				
MINIMUM DEGREE OF ACCURACY: 1/200		Signed:		
PROVEN SOURCE OF ELEVATION: SUBMETER MAPPING GRADE GPS		L.L.S. #2124: Ernest J. Benchek III		
(+) DENOTES LOCATION OF WELL ON UNITED STATES TOPOGRAPHIC MAPS WVDEP				
OFFICE OF OIL & GAS				
601 57TH STREET				
CHARLESTON, WV 25304				
Well Type: ☐ Oil ☐ Waste Diposal ☐ Production ☐ Deep ☒ Gas ☐ Liquid Injection ☐ Storage ☒ Shallow				
WATERSHED: DUNKARD CREEK				
COUNTY/DISTRICT: MONONGALIA / BATTELLE				
SURFACE OWNER: BYRON LANE RAPP				
OIL & GAS ROYALTY OWNER:				
LEASE NUMBERS:				
DRILL ☒ CONVERT ☐ DRILL DEEPER ☐ REDRILL ☐ FRACTURE OR STIMULATE ☒				
PLUG OFF FORMATION ☐ PERFORATE NEW FORMATION ☐ PLUG & ABANDON ☐				
CLEAN OUT & REPLUG ☐ OTHER CHANGE ☐ (SPECIFY):				
TARGET FORMATION: MARCELLUS				
WELL OPERATOR: NORTHEAST NATURAL ENERGY LLC				
ADDRESS: 707 VIRGINIA STREET EAST, SUITE 1200				
CITY: CHARLESTON STATE: WV ZIP CODE: 25301				
DATE: MAY 5, 2025				
OPERATOR'S WELL #: MIRACLE RUN 6H (AS-DRILLED)				
API WELL #: 47 61 01924				
STATE COUNTY PERMIT				
AS-BUILT ELEVATION: 1,521.56'				
QUADRANGLE: WADESTOWN				
ACREAGE: 1872.25 +/-				
ACREAGE: 56.46				
DRILLED DEPTH: TVD: 8,163' TMD: 30,512'				
DESIGNATED AGENT: JOHN ADAMS				
ADDRESS: 707 VIRGINIA STREET EAST, SUITE 1200				
CITY: CHARLESTON STATE: WV ZIP CODE: 25301				

SURFACE HOLE DEC. LONG: 80.318928 SURVEYED LONG: 80°19'08.1" SURFACE HOLE DEC. LAT: 39.629132 SURVEYED LAT: 39°37'44.9"

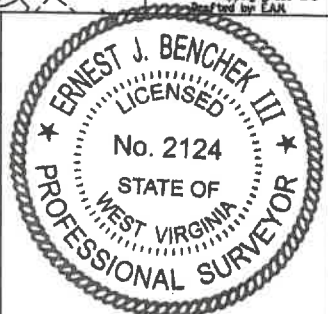

DATE: MAY 5, 2025

OPERATOR'S WELL #: MIRACLE RUN 6H (AS-DRILLED)

API WELL #: 47 61 01924
STATE COUNTY PERMIT

☐ Production ☐ Deep
☐ Storage ☒ Shallow

AS-BUILT
ELEVATION: 1,521.56'

BATTELLE QUADRANGLE: WADESTOWN

BYRON LANE RAPP ACREAGE: 1872.25 +/-
ACREAGE: 56.46 +/-

09/19/2025

WELL HEAD NUMBERS: _____

DRILL ☒ CONVERT ☐ DRILL DEEPER ☐ REDRILL ☐ FRACTURE OR STIMULATE ☒
PLUG OFF FORMATION ☐ PERFORATE NEW FORMATION ☐ PLUG & ABANDON ☐
CLEAN OUT & REPLUG ☐ OTHER CHANGE ☐ (SPECIFY): _____

TARGET FORMATION: MARCELLUS

WELL OPERATOR: NORTHEAST NATURAL ENERGY LLC

ADDRESS: 707 VIRGINIA STREET EAST, SUITE 1200

CITY: CHARLESTON STATE: WV ZIP CODE: 25301

DRILLED DEPTH: TVD: 8,163' TMD: 30,512'

DESIGNATED AGENT: JOHN ADAMS

ADDRESS: 707 VIRGINIA STREET EAST, SUITE 1200

CITY: CHARLESTON STATE: WV ZIP CODE: 25301

	PROPERTY INDEX
1-23-12	CNX LAND LLC
1-23-13	JOHN E BARR SR
1-23-14	CLAUDE S & JONI L ANDERSON
1-23-15	CLAUDE S & JONI L ANDERSON
1-23-32	BYRON LANE RAPP
1-23-32.2	NORTHEAST NATURAL ENERGY LLC
1-23-35	CNX LAND LLC
1-27-19	CNX LAND LLC
1-27-20	CONSOL MINING COMPANY LLC
1-26-3	CONSOL MINING COMPANY LLC
1-26-4	CONSOL MINING COMPANY LLC
16-1-1	MARION COUNTY COAL RESOURCES INC
16-3-1.1	DAVE L & DIANA L MCDOUGAL
16-1-2	JAMES A TENNANT & KIM M DENSON
16-1-2.1	GREGORY N & JULIE A TENNANT
16-3-2	MAYNARD A KNOTTS
16-1-2	JAMES A TENNANT & KIM M DENSON
16-3-4	WACO OIL & GAS
16-3-3	RALPH & ZORA SHRIVER
16-3-28	CHARLES L & SUSAN L UNDERWOOD
16-3-29	CHARLES L & SUSAN L UNDERWOOD
16-3-29.2	MATTHEW PAUL SICKLES
16-3-30.1	CHESTER L & SUSAN L MICHAEL
16-3-30	CHARLES L & SUSAN L UNDERWOOD

LEASE INDEX			
A	WV-061-003830-005	M	WV-049-004839-001
B	WV-061-003828-007	N	WV-049-086187-001
C	WV-061-005463-023	O	WV-049-086187-001
D	WV-061-003829-005	P	WV-049-086168-003
E	WV-061-000198-001-LOI	Q	WV-049-086168-003
F	WV-061-006138-005	R	WV-061-000198-001-LOI
G	WV-061-004692-002	S	WV-049-086145-001
H	WV-061-003844-025	T	WV-049-106399-002
I	WV-061-000198-001-LOI	U	WV-049-106192-001
J	WV-049-004839-001; WV-049-004839-002	V	WV-049-106436-001
		W	WV-049-106399-001
K	WV-061-006503-001	X	WV-049-106399-001
L	WV-049-106389-002		

09/19/2025

FILE #: NEE20
DRAWING #: 3093
SCALE: N/A

DATE: MAY 5, 2025
OPERATOR'S WELL #: MIRACLE RUN 6H
API WELL #: 47 61
STATE COUNTY PERMIT