



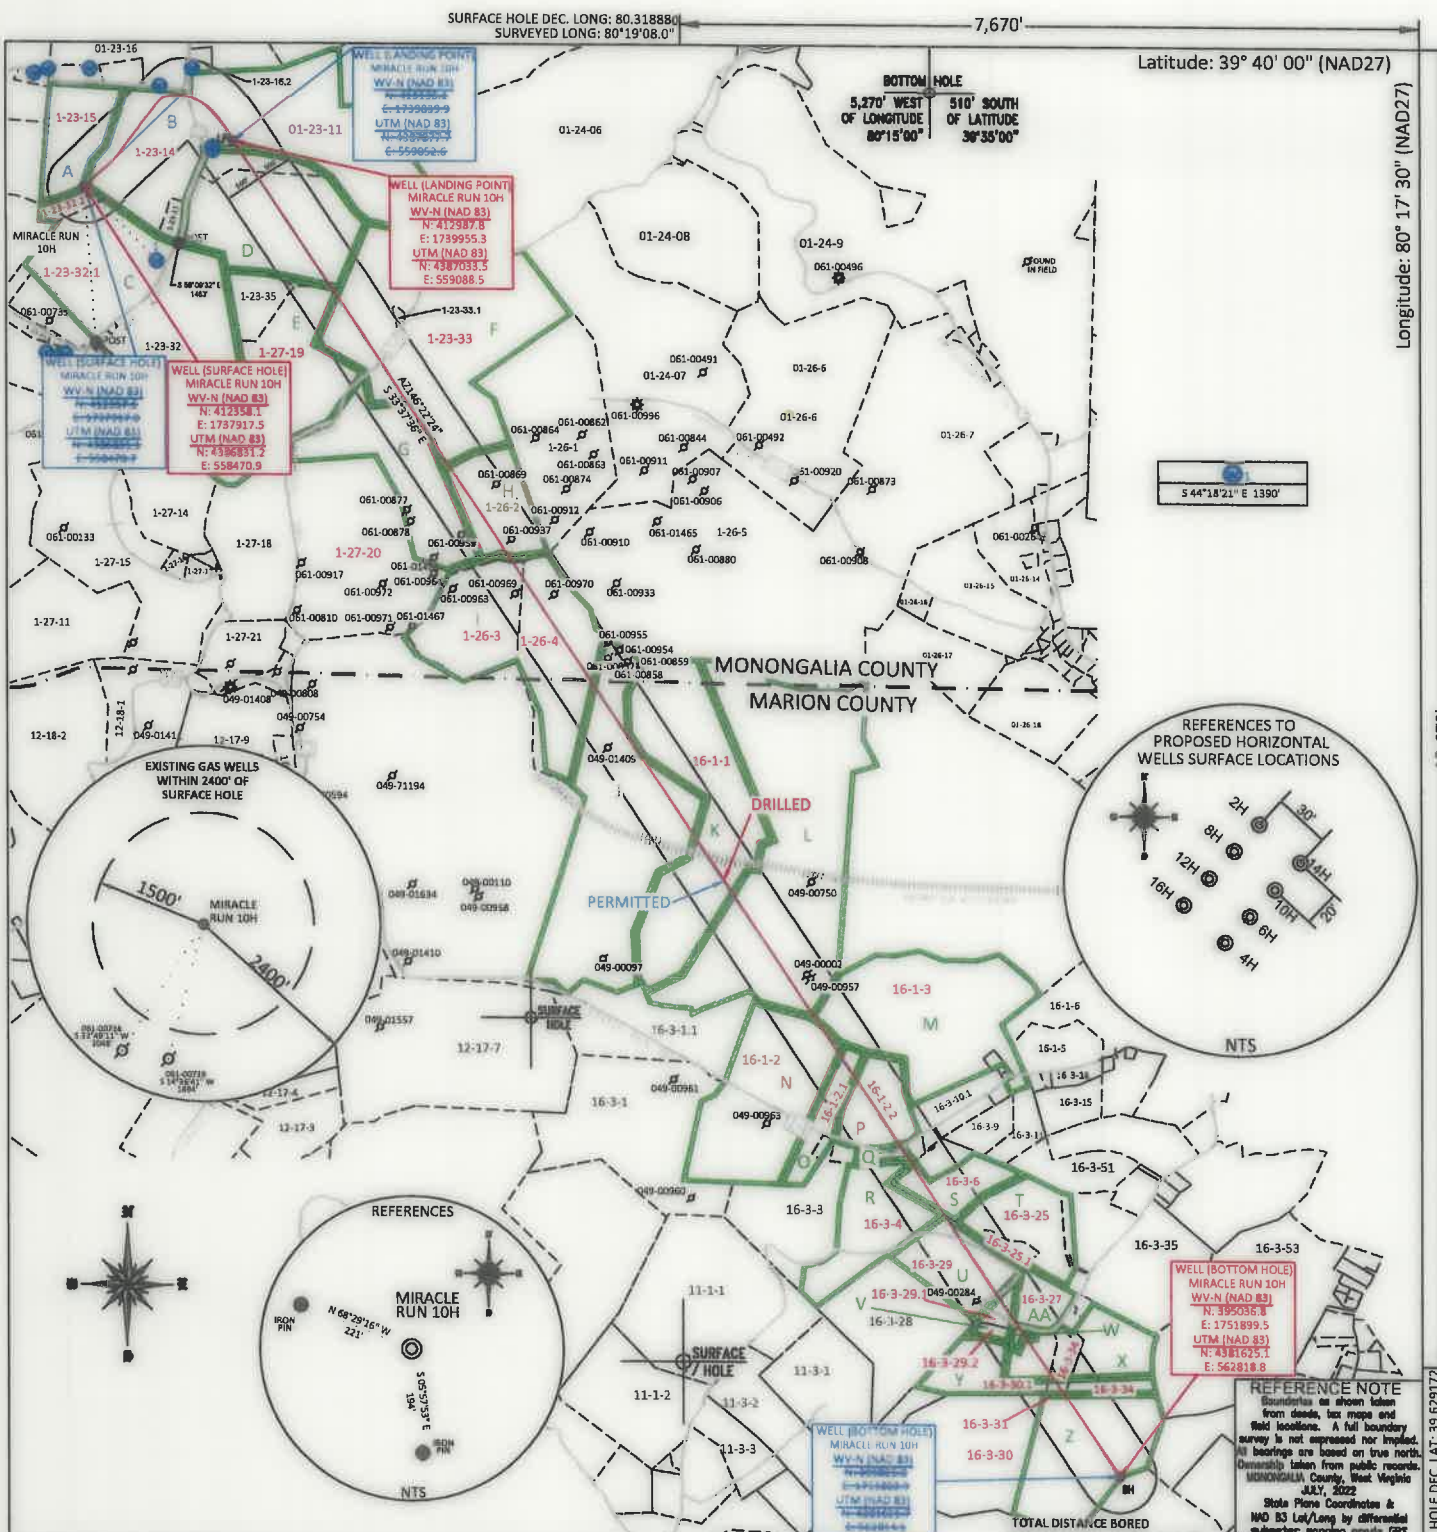

FILE #:	NNE20	I, THE UNDERSIGNED, HEREBY CERTIFY THAT THIS PLAT IS CORRECT TO THE BEST OF MY KNOWLEDGE AND BELIEF AND SHOWS ALL THE INFORMATION REQUIRED BY LAW AND THE REGULATIONS ISSUED AND PRESCRIBED BY THE DEPARTMENT OF ENVIRONMENTAL PROTECTION. Signed: L.L.S. #2124 Ernest J. Benchek III
DRAWING #:	3095	
SCALE:	PLAT: 1" = 2800' TICK: 1" = 2000'	
MINIMUM DEGREE OF ACCURACY:	1/200	
PROVEN SOURCE OF ELEVATION:	SUBMETER MAPPING GRADE GPS	


(+) DENOTES LOCATION OF WELL ON UNITED STATES TOPOGRAPHIC MAPS WVDEP OFFICE OF OIL & GAS 601 57TH STREET CHARLESTON, WV 25304		DATE: MAY 5, 2025
Well Type: ☐ Oil ☐ Waste Diposal ☐ Production ☐ Deep ☒ Gas ☐ Liquid Injection ☐ Storage ☒ Shallow		OPERATOR'S WELL #: MIRACLE RUN 10H (AS-DRILLED)
WATERSHED: DUNKARD CREEK		API WELL #: 47 61 01925 STATE COUNTY PERMIT
COUNTY/DISTRICT: MONONGALIA / BATTELLE		AS-BUILT ELEVATION: 1,521.56'
SURFACE OWNER: BYRON LANE RAPP		QUADRANGLE: WADESTOWN
OIL & GAS ROYALTY OWNER:		ACREAGE: 1741.26 +/-
LEASE NUMBERS:		ACREAGE: 56.46
DRILL ☒ CONVERT ☐ DRILL DEEPER ☐ REDRILL ☐ FRACTURE OR STIMULATE ☒ PLUG OFF FORMATION ☐ PERFORATE NEW FORMATION ☐ PLUG & ABANDON ☐ CLEAN OUT & REPLUG ☐ OTHER CHANGE ☐ (SPECIFY):		
TARGET FORMATION: MARCELLUS		DRILLED DEPTH: TVD: 8,174' TMD: 30,768'
WELL OPERATOR: NORTHEAST NATURAL ENERGY LLC		DESIGNATED AGENT: JOHN ADAMS
ADDRESS: 707 VIRGINIA STREET EAST, SUITE 1200		ADDRESS: 707 VIRGINIA STREET EAST, SUITE 1200
CITY: CHARLESTON STATE: WV ZIP CODE: 25301		CITY: CHARLESTON STATE: WV ZIP CODE: 25301

16 of 36

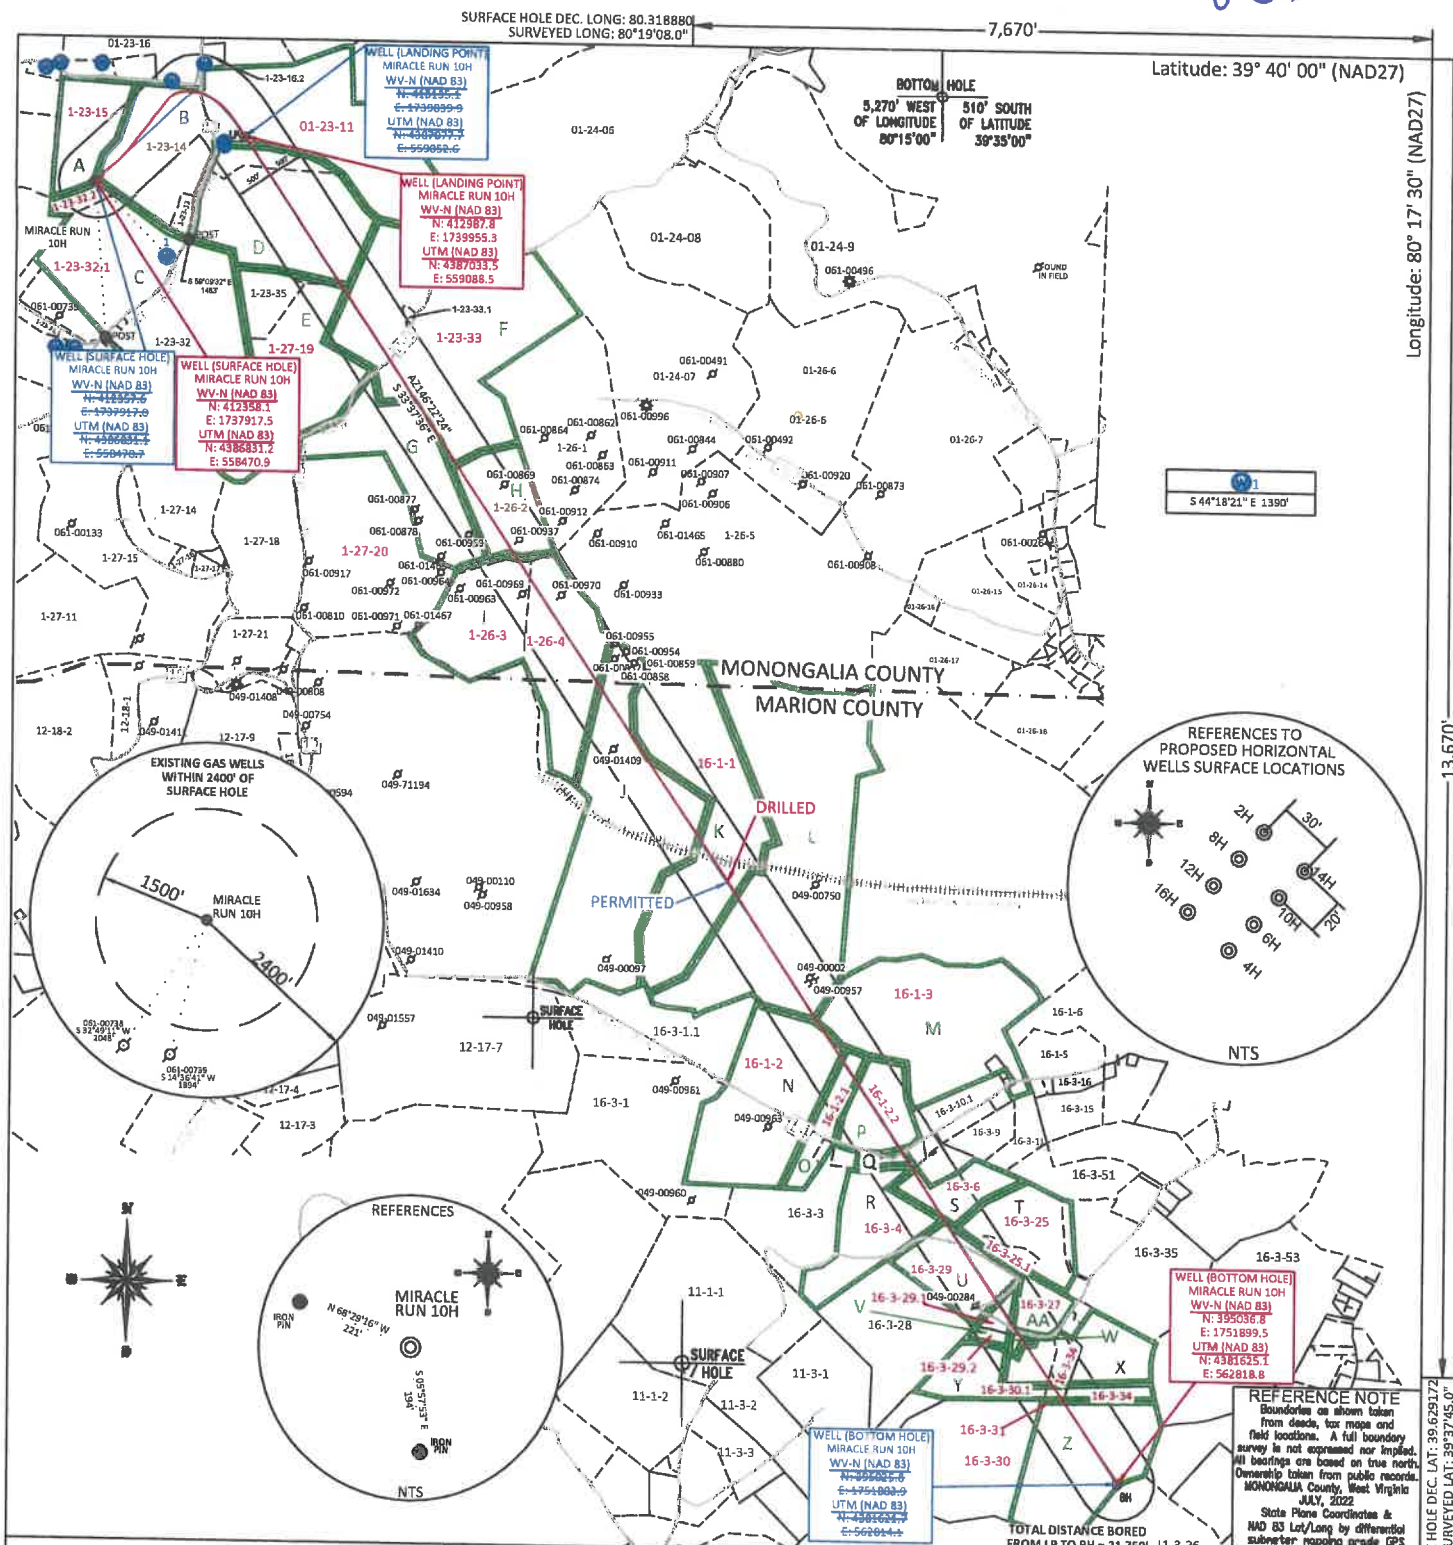

FILE #: NNE20
DRAWING #: 3095
SCALE: PLAT: 1" = 2600'
TICK: 1" = 2000'
MINIMUM DEGREE OF ACCURACY: 1/200
PROVEN SOURCE OF ELEVATION: SUBMETER MAPPING GRADE GPS

I, THE UNDERSIGNED, HEREBY CERTIFY THAT THIS PLAT IS CORRECT TO THE BEST OF MY KNOWLEDGE AND BELIEF AND SHOWS ALL THE INFORMATION REQUIRED BY LAW AND THE REGULATIONS ISSUED AND PRESCRIBED BY THE DEPARTMENT OF ENVIRONMENTAL PROTECTION.
Signed: *[Signature]*
L.L.S. #2124: Ernest J. Benchek III

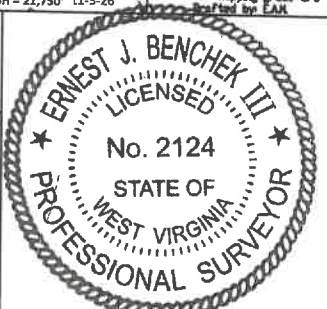

(+) DENOTES LOCATION OF WELL ON UNITED STATES TOPOGRAPHIC MAPS WVDEP
OFFICE OF OIL & GAS
601 57TH STREET
CHARLESTON, WV 25304

Well Type: ☐ Oil ☐ Waste Diposal ☐ Production ☐ Deep ☒ Gas ☐ Liquid Injection ☐ Storage ☒ Shallow

WATERSHED: DUNKARD CREEK
COUNTY/DISTRICT: MONONGALIA / BATTELLE
SURFACE OWNER: BYRON LANE RAPP
OIL & GAS ROYALTY OWNER:
LEASE NUMBERS:

DATE: MAY 5, 2025
OPERATOR'S WELL #: MIRACLE RUN 10H (AS-DRILLED)
API WELL #: 47 61 01925
STATE COUNTY PERMIT

AS-BUILT ELEVATION: 1,521.56'
QUADRANGLE: WADESTOWN
ACREAGE: 1741.26
ACREAGE: 56.46 +/ -

DRILL ☒ CONVERT ☐ DRILL DEEPER ☐ REDRILL ☐ FRACTURE OR STIMULATE ☒
PLUG OFF FORMATION ☐ PERFORATE NEW FORMATION ☐ PLUG & ABANDON ☐
CLEAN OUT & REPLUG ☐ OTHER CHANGE ☐ (SPECIFY):

TARGET FORMATION: MARCELLUS
WELL OPERATOR: NORTHEAST NATURAL ENERGY LLC
ADDRESS: 707 VIRGINIA STREET EAST, SUITE 1200
CITY: CHARLESTON STATE: WV ZIP CODE: 25301

DRILLED DEPTH: TVD: 8,174' TMD: 30,768'
DESIGNATED AGENT: JOHN ADAMS
ADDRESS: 707 VIRGINIA STREET EAST, SUITE 1200
CITY: CHARLESTON STATE: WV ZIP CODE: 25301

09/19/2025

PROPERTY INDEX	
1-23-11	CLAUDE S & JONI L ANDERSON
1-23-12	CNX LAND LLC
1-23-14	CLAUDE S & JONI L ANDERSON
1-23-15	CLAUDE S & JONI L ANDERSON
1-23-32.2	NORTHEAST NATURAL ENERGY LLC
1-23-33	CONSOL MINING COMPANY LLC
1-27-19	CNX LAND LLC
1-26-2	CONSOL MINING COMPANY LLC
1-27-20	CONSOL MINING COMPANY LLC
1-26-3	CONSOL MINING COMPANY LLC
1-26-4	CONSOL MINING COMPANY LLC
16-1-1	MARION COUNTY COAL RESOURCES INC
16-1-3	MICHAEL A & DOROTHY K DEMARY
16-1-2	JAMES A TENNANT & KIM M DENSON
16-1-2.2	JAMES A TENNANT & KIM M DENSON
16-1-2.1	GREGORY N & JULIE A TENNANT
16-3-6	JUDITH A PRICE
16-3-25	CHARLES L & SUSAN L UNDERWOOD
16-3-4	WACO OIL & GAS
16-3-25.1	TONY & TRACY UNDERWOOD
16-3-29	CHARLES L & SUSAN L UNDERWOOD
16-3-27	MATTHEW PAUL SICKLES
16-3-29.2	MATTHEW PAUL SICKLES
16-3-34	CHESTER L & SUSAN L MICHAEL
16-3-30.1	CHESTER L & SUSAN L MICHAEL
16-3-31	CHARLES L & SUSAN L UNDERWOOD
16-3-30	CHARLES L & SUSAN L UNDERWOOD
1-23-16	SHEILA J TENNANT
16-3-29.1	MATTHEW PAUL SICKLES

LEASE INDEX			
A	WV-061-003830-005	O	WV-049-086168-003
B	WV-061-003828-007	P	WV-049-086191-002
C	WV-061-005463-023	Q	WV-049-086145-001
D	WV-061-003829-005	R	WV-049-086145-001
E	WV-061-000198-001-LOI	S	WV-049-106467-001
F	WV-061-005633-015	T	WV-049-106467-001
G	WV-061-006138-005	U	WV-049-106399-002
H	WV-061-006138-005	V	WV-049-085259-003
I	WV-061-003844-025	W	WV-049-085259-003
J	WV-061-006503-001	X	WV-049-106436-001
K	WV-049-106389-002	Y	WV-049-106436-001
L	WV-049-004839-001	Z	WV-049-106399-001
M	WV-049-005194-004	AA	WV-049-085259-003
N	WV-049-086168-003		

09/19/2025

FILE #: NEE20	DATE: MAY 5, 2025
DRAWING #: 3095	OPERATOR'S WELL #: MIRACLE RUN 10H
SCALE: N/A	API WELL #: 47 61 STATE COUNTY PERMIT