



16 of 30

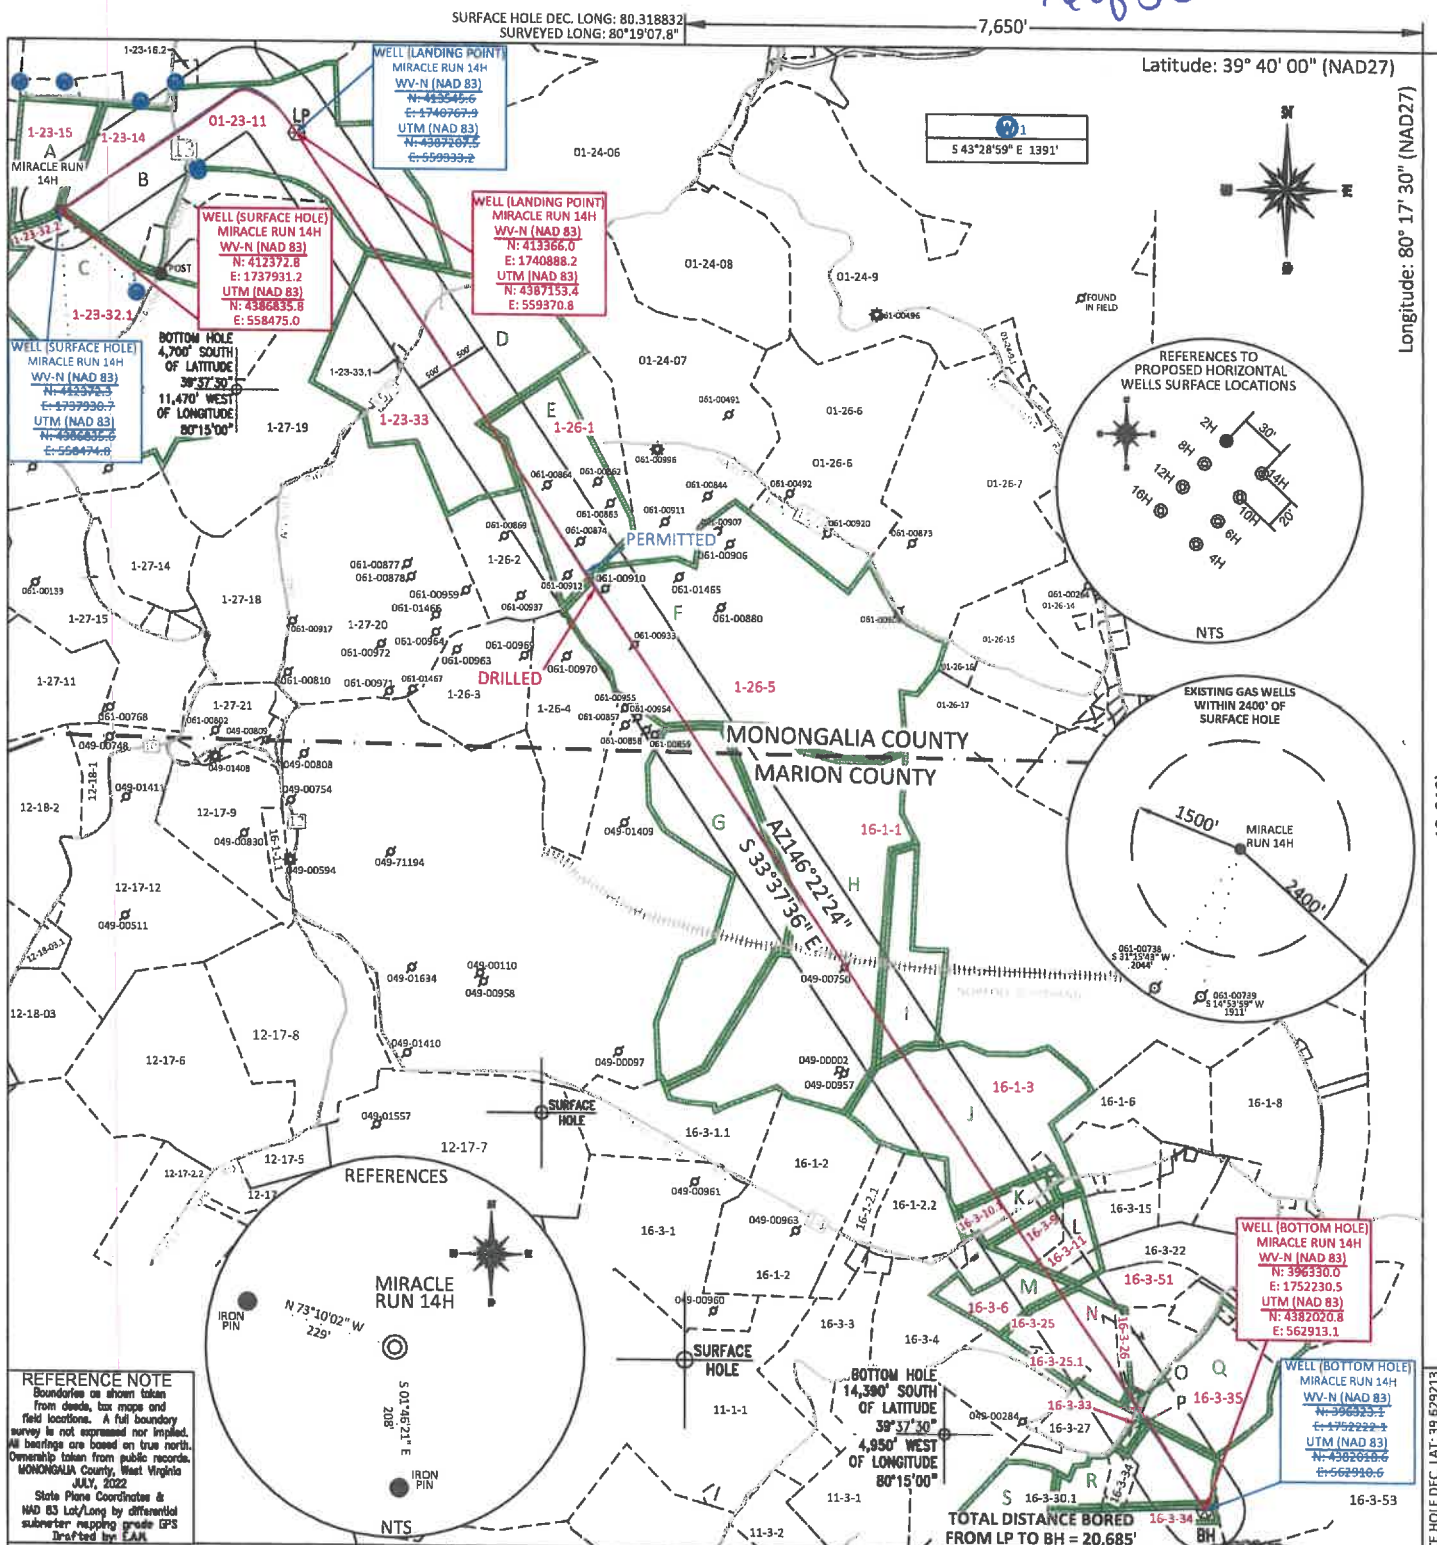

REFERENCE NOTE
Boundaries as shown taken from deeds, tax maps and field locations. A full boundary survey is not expressed nor implied. All bearings are based on true north. Ownership taken from public records. MONONGALIA County, West Virginia JULY, 2022
State Plane Coordinates at NAD 83 Lat/Long by differential submeter mapping grade GPS
Drafted by EAM

FILE #: NNE20
DRAWING #: 3097
SCALE: PLAT: 1" = 2400'
TICK: 1" = 2000'
MINIMUM DEGREE OF ACCURACY: 1/200
PROVEN SOURCE OF ELEVATION: SUBMETER MAPPING
GRADE GPS

I, THE UNDERSIGNED, HEREBY CERTIFY THAT THIS PLAT IS CORRECT TO THE BEST OF MY KNOWLEDGE AND BELIEF AND SHOWS ALL THE INFORMATION REQUIRED BY LAW AND THE REGULATIONS ISSUED AND PRESCRIBED BY THE DEPARTMENT OF ENVIRONMENTAL PROTECTION.
Signed: [Signature]
L.L.S. #2124 : Ernest J. Benchek III

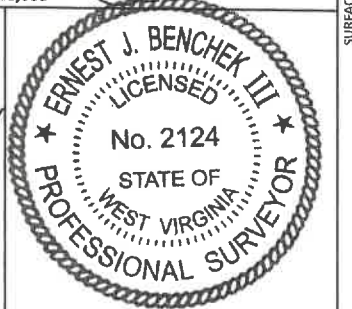

(+) DENOTES LOCATION OF WELL ON UNITED STATES TOPOGRAPHIC MAPS WVDEP
OFFICE OF OIL & GAS
601 57TH STREET
CHARLESTON, WV 25304
Well Type: ☐ Oil ☐ Waste Diposal ☐ Production ☐ Deep ☒ Gas ☐ Liquid Injection ☐ Storage ☒ Shallow
WATERSHED: DUNKARD CREEK
COUNTY/DISTRICT: MONONGALIA / BATTELLE
SURFACE OWNER: BYRON LANE RAPP
OIL & GAS ROYALTY OWNER: _____
LEASE NUMBERS: _____
DATE: MAY 5, 2025
OPERATOR'S WELL #: MIRACLE RUN 14H (AS-DRILLED)
API WELL #: 47 61 01926
STATE COUNTY PERMIT
AS-BUILT ELEVATION: 1,521.56'
QUADRANGLE: WADESTOWN
ACREAGE: 1414.02 +/-
ACREAGE: 56.46 +/-
09/19/2025
DRILL ☒ CONVERT ☐ DRILL DEEPER ☐ REDRILL ☐ FRACTURE OR STIMULATE ☒
PLUG OFF FORMATION ☐ PERFORATE NEW FORMATION ☐ PLUG & ABANDON ☐
CLEAN OUT & REPLUG ☐ OTHER CHANGE ☐ (SPECIFY): _____
TARGET FORMATION: MARCELLUS
WELL OPERATOR: NORTHEAST NATURAL ENERGY LLC
ADDRESS: 707 VIRGINIA STREET EAST, SUITE 1200
CITY: CHARLESTON STATE: WV ZIP CODE: 25301
DRILLED DEPTH: TVD: 8,196' TMD: 29,863'
DESIGNATED AGENT: JOHN ADAMS
ADDRESS: 707 VIRGINIA STREET EAST, SUITE 1200
CITY: CHARLESTON STATE: WV ZIP CODE: 25301

	PROPERTY INDEX
1-23-11	CLAUDE S & JONI L ANDERSON
1-23-14	CLAUDE S & JONI L ANDERSON
1-23-15	CLAUDE S & JONI L ANDERSON
1-23-32.2	NORTHEAST NATURAL ENERGY LLC
1-23-33	CONSOL MINING COMPANY LLC
1-26-1	CONSOL MINING COMPANY LLC
1-26-5	CONSOL MINING COMPANY LLC
16-1-1	MARION COUNTY COAL RESOURCES INC
16-1-3	MICHAEL A & DOROTHY K DEMARY
16-3-10.1	MARLA KETTINGER ETAL
16-3-9	MARLA KETTINGER ETAL
16-3-11	MARJORIE ROSE & FRANCIS D GUMP; DARWIN R GUMP
16-3-51	DONALD & PATRICIA PYLES
16-3-6	JUDITH A PRICE
16-3-25	CHARLES L & SUSAN L UNDERWOOD
16-3-25.1	CHARLES L & SUSAN L UNDERWOOD
16-3-33	CHARLES UNDERWOOD II
16-3-35	CHARLES L & SUSAN L UNDERWOOD
16-3-34	CHARLES L & SUSAN L UNDERWOOD
16-3-26	CHARLES L & SUSAN L UNDERWOOD

	LEASE INDEX		
A	WV-061-003830-005	K	WV-049-006439-008
B	WV-061-003828-007	L	WV-049-094055-001
C	WV-061-005463-023	M	WV-049-106467-001
D	WV-061-005633-015	N	WV-049-106467-001
E	WV-061-005781-001	O	WV-049-106467-001
F	WV-061-005781-001	P	WV-049-086171-001
G	WV-049-106389-002	Q	049-006401-001
H	WV-049-004839-001	R	WV-049-106436-001
I	WV-049-006487-001	S	WV-049-106436-001
J	WV-049-005194-004		

09/19/2025

FILE #: NEE20	DATE: MAY 5, 2025
DRAWING #: 3097	OPERATOR'S WELL #: MIRACLE RUN 14H
SCALE: N/A	API WELL #: 47 61
	STATE COUNTY PERMIT