


140631

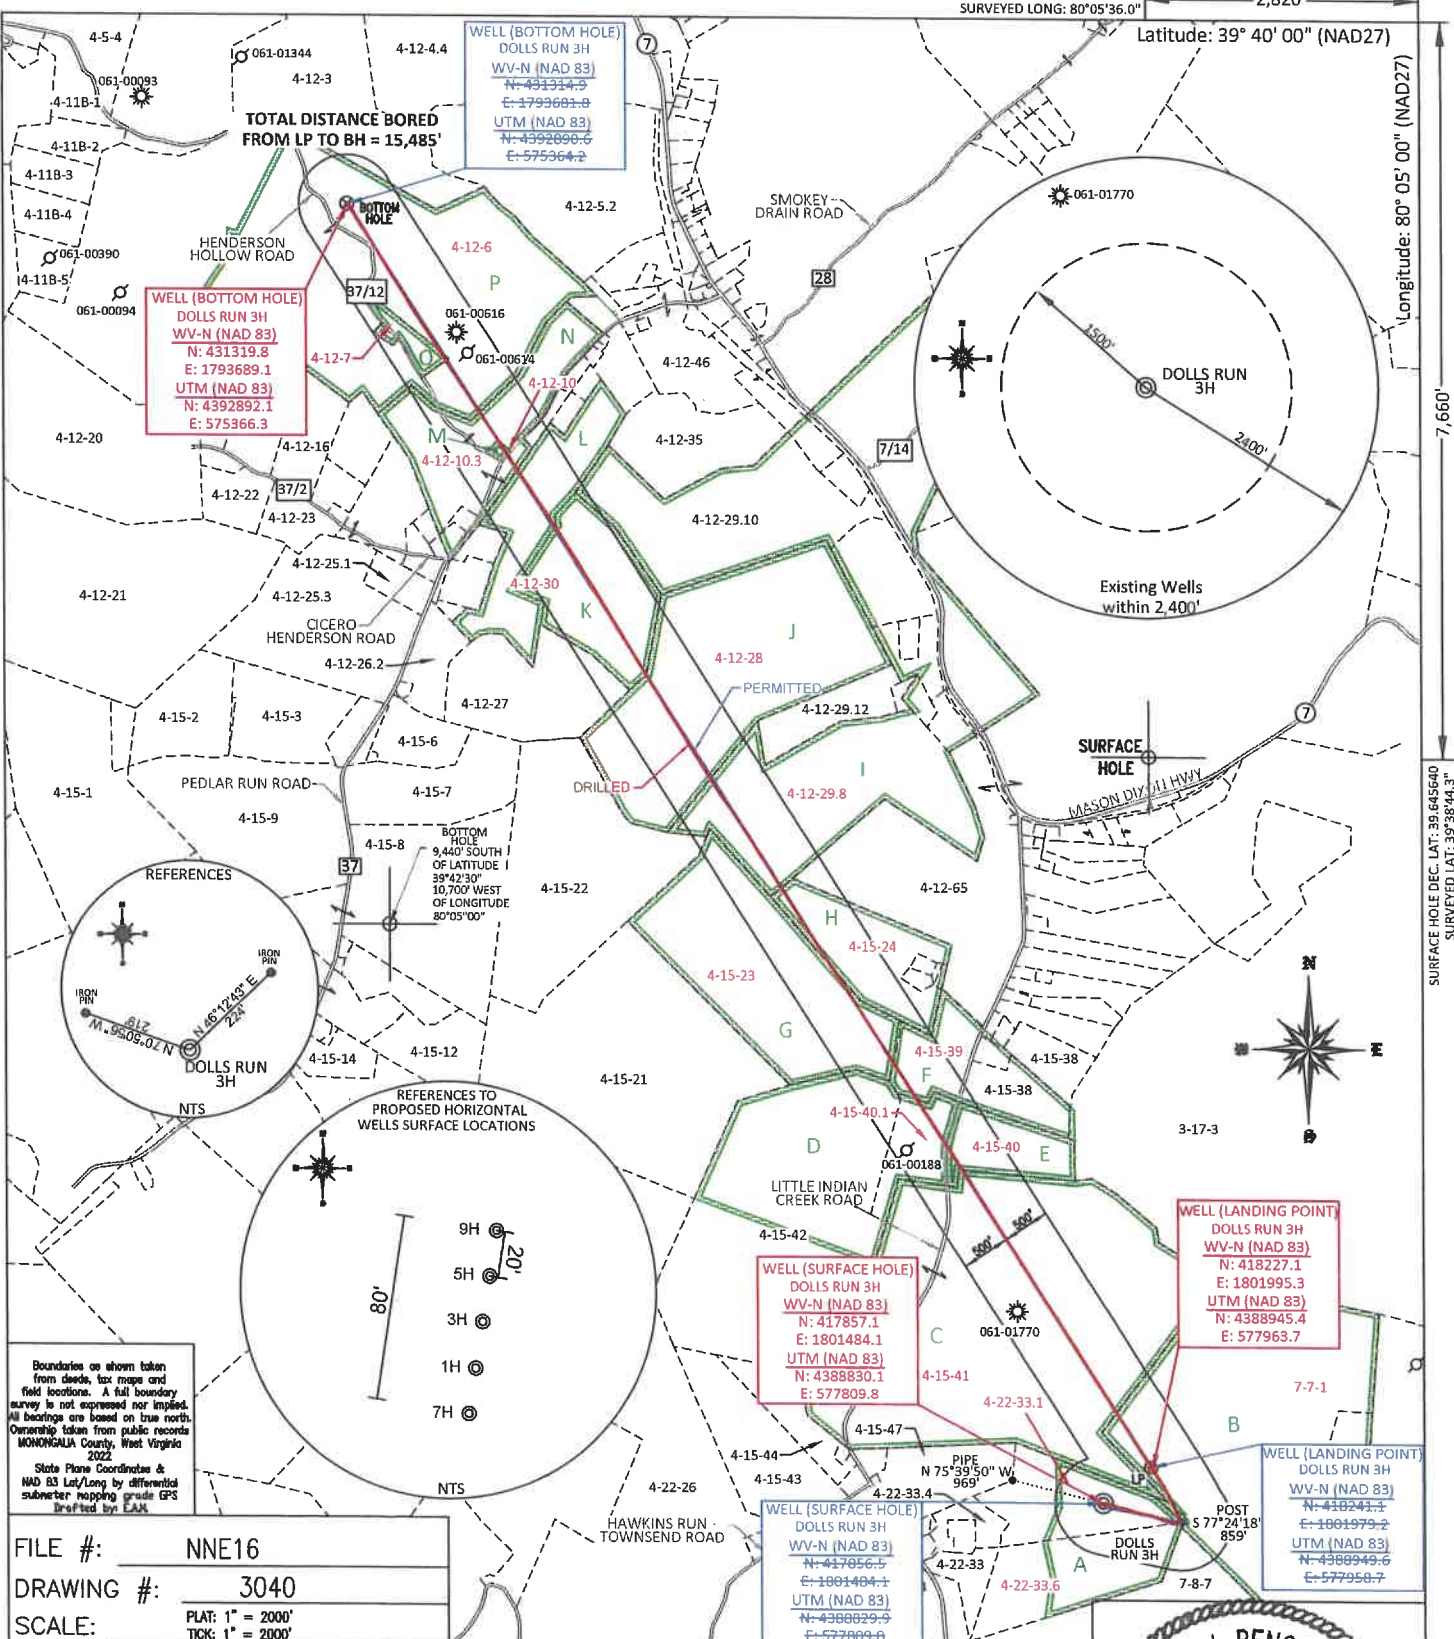

Boundaries as shown taken from deeds, tax maps and field locations. A full boundary survey is not expressed nor implied. All bearings are based on true north. Ownership taken from public records MONONGALIA County, West Virginia 2022.

State Plane Coordinates & NAD 83 Lat/Long by differential submeter mapping grade GPS drafted by EAM

FILE #: NNE16

DRAWING #: 3040

SCALE: PLAT: 1" = 2000' TICK: 1" = 2000'


MINIMUM DEGREE OF ACCURACY: 1/200

PROVEN SOURCE OF ELEVATION: SUBMETER MAPPING GRADE GPS

PLAT IS CORRECT TO THE BEST OF MY KNOWLEDGE AND BELIEF AND SHOWS ALL THE INFORMATION REQUIRED BY LAW AND THE REGULATIONS ISSUED AND PRESCRIBED BY THE DEPARTMENT OF ENVIRONMENTAL PROTECTION.

Signed: *[Signature]*

L.L.S. #2124 : Ernest J. Benchek III

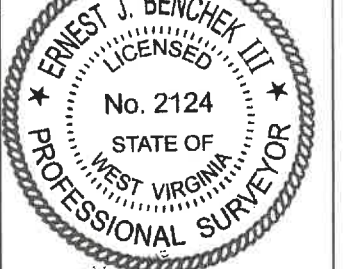

(+) DENOTES LOCATION OF WELL ON UNITED STATES TOPOGRAPHIC MAPS

WVDEP
OFFICE OF OIL & GAS
601 57TH STREET
CHARLESTON, WV 25304

Well Type: ☐ Oil ☐ Waste Diposal ☐ Production ☐ Deep ☒ Gas ☐ Liquid Injection ☐ Storage ☒ Shallow

WATERSHED: DUNKARD CREEK

COUNTY/DISTRICT: MONONGALIA / CLAY

SURFACE OWNER: BRYAN & SIERRA VANNORMAN

OIL & GAS ROYALTY OWNER: MARK V EDDY

LEASE NUMBERS:

DATE: APRIL 15, 2025

OPERATOR'S WELL #: DOLLS RUN 3H AS-DRILLED

API WELL #: 47

STATE: WV COUNTY: MASON

AS-BUILT ELEVATION: 1,522.6'

QUADRANGLE: OSAGE

ACREAGE: 27.7

ACREAGE: 1,599.15+/-

DRILL ☒ CONVERT ☐ DRILL DEEPER ☐ REDRILL ☐ FRACTURE OR STIMULATE ☒ PLUG OFF FORMATION ☐ PERFORATE NEW FORMATION ☐ PLUG & ABANDON ☐ CLEAN OUT & REPLUG ☐ OTHER CHANGE ☐ (SPECIFY):

TARGET FORMATION: MARCELLUS

WELL OPERATOR: NORTHEAST NATURAL ENERGY LLC

ADDRESS: 707 VIRGINIA STREET EAST, SUITE 1200

CITY: CHARLESTON STATE: WV ZIP CODE: 25301

DRILLED DEPTH: TVD: 8,302' TMD: 24,154'

DESIGNATED AGENT: JOHN ADAMS

ADDRESS: 707 VIRGINIA STREET EAST, SUITE 1200

CITY: CHARLESTON STATE: WV ZIP CODE: 25301

	PROPERTY OWNER INDEX
4-12-6	ALPHEUS MICHAEL HENDERSON
4-12-7	JEFFERIE R WRIGHT II & NICOLE M WRIGHT
4-12-10	NORMA L EDDIE IRREVOCABLE TRUST (LIFE NORMA L EDDY)
4-12-10.3	MAVIS I EDDY
4-12-28	MELISSA T HETTMAN & ERIN ALLEN
4-12-29.8	MELISSA T HETTMAN & ERIN ALLEN
4-12-30	ROBERT C WALLS FAMILT TRUST (LIFE- DIANA LYNN WALLS)
4-15-23	STATE OF WEST VIRGINIA BUREAU OF COMMERCE
4-15-39	STATE OF WEST VIRGINIA BUREAU OF COMMERCE
4-15-40	LEROY E & GLENNA J TENNANT LEGACY PROTECTOR TRUST
4-15-40.1	STATE OF WEST VIRGINIA BUREAU OF COMMERCE
4-15-41	DONNA N & ROBERT ALLEN WRIGHT
4-22-33.1	DENNIS J & MELINDA S THORNE
4-22-33.6	DANIEL D & MARTHA P SPERANDIO
4-15-24	RICHARD L & THOMASINE WEBER
7-7-1	OWEN REALTY CO INC

LEASE INDEX			
A	WV-061-004020-000	I	WV-061-006385-001
B	WV-061-086230-001	J	WV-061-001111-008
C	WV-061-005246-002	K	WV-061-002357-000
D	WV-061-004237-001	L	WV-061-002357-000
E	WV-061-004237-001	M	WV-061-003768-014
F	WV-061-004237-001	N	WV-061-005615-008
G	WV-061-001575-014	O	WV-061-003525-012
H	WV-061-005524-007	P	WV-061-003525-012

RECEIVED
Office Of Oil and Gas
MAY 29 2025
WV Department of
Environmental Protection

09/19/2025

FILE #: NEE14
DRAWING #: 3040
SCALE: N/A

DATE: APRIL 15, 2025
OPERATOR’S WELL #: DOLLS RUN 3H AS-DRILLED
API WELL #: 47 61 01929
STATE COUNTY PERMIT