


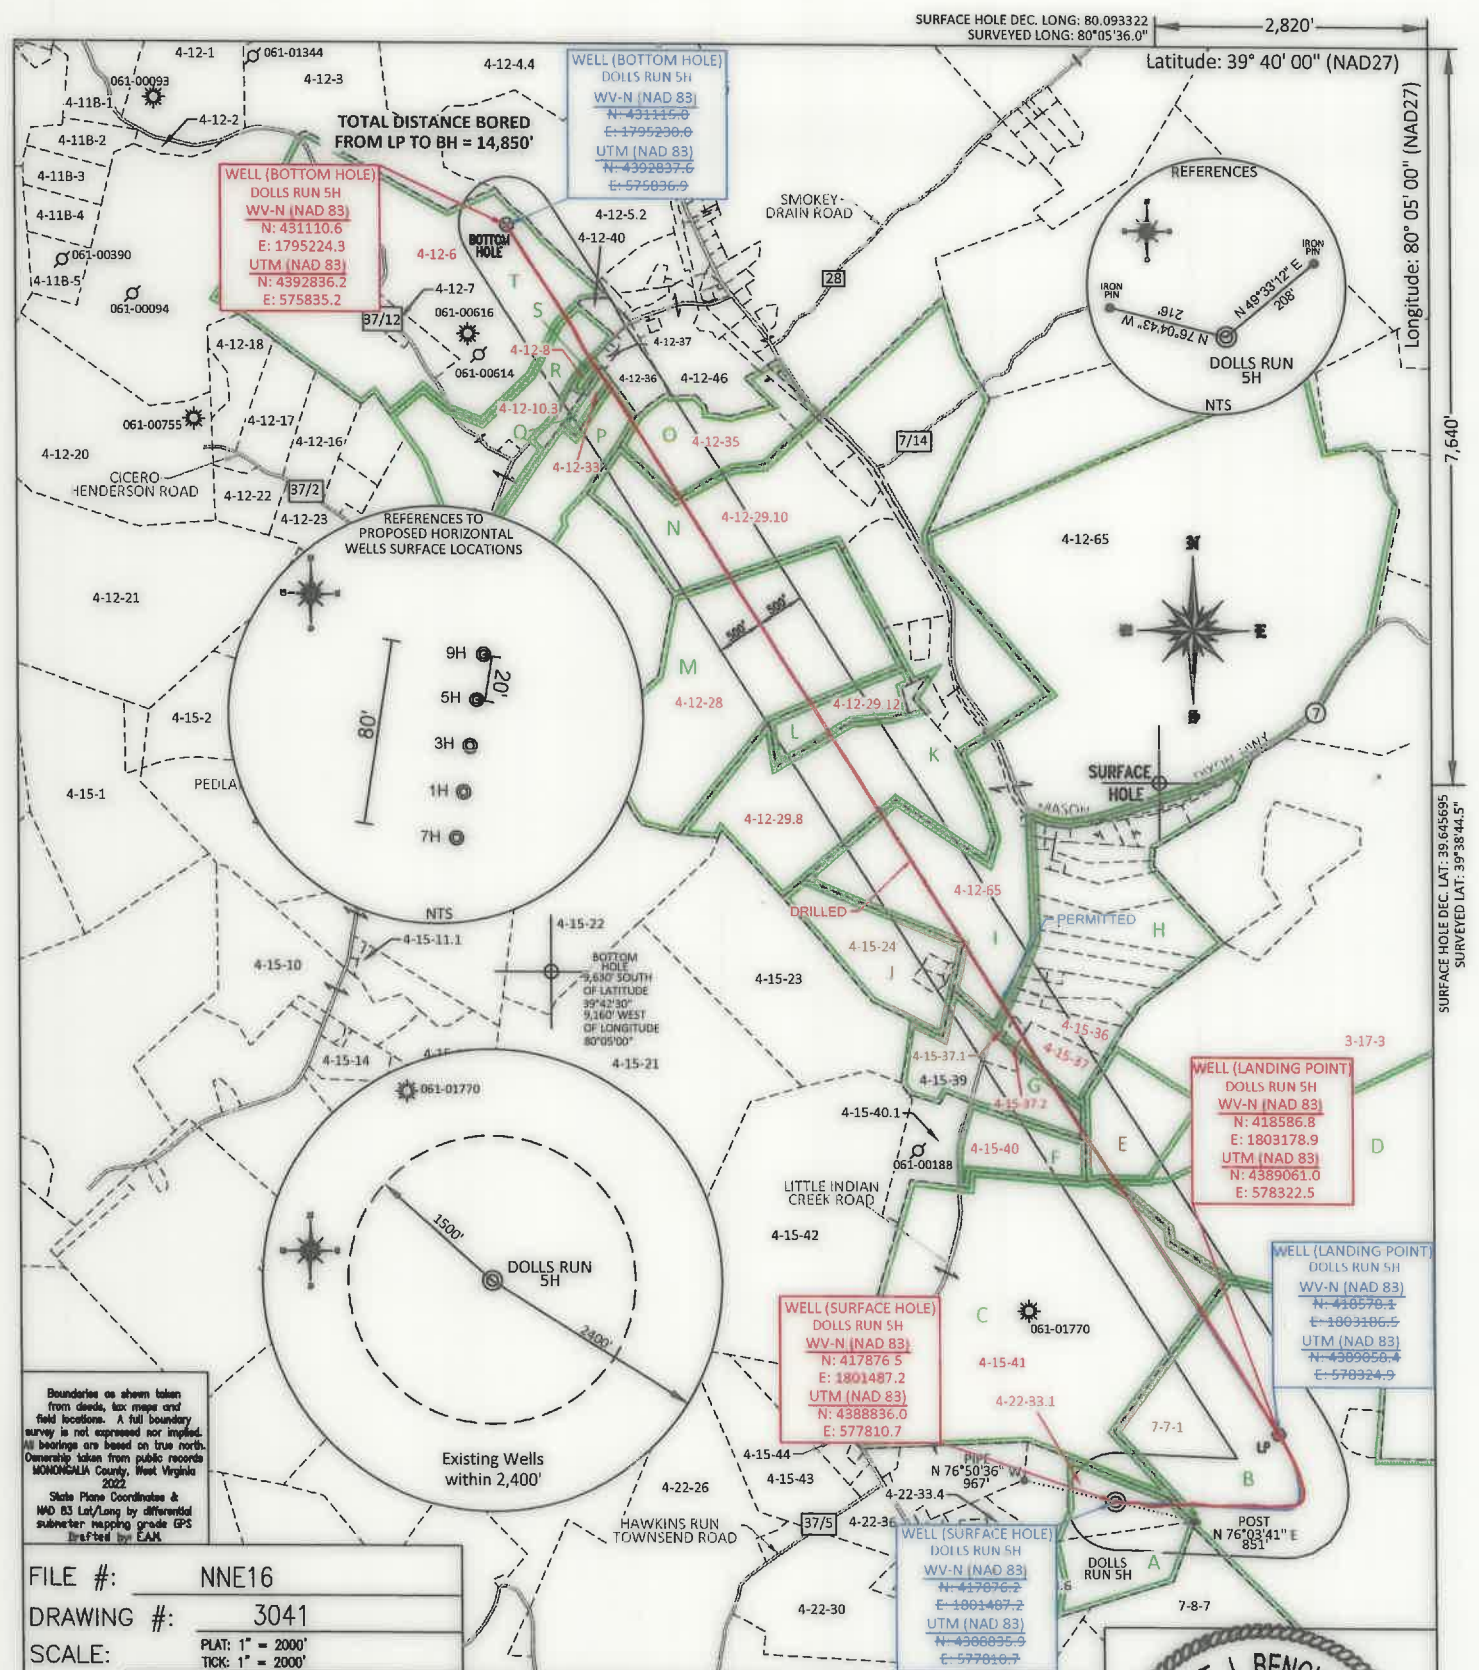

FILE #: NNE16

DRAWING #: 3041

SCALE: PLAT: 1" = 2000'
TICK: 1" = 2000'

MINIMUM DEGREE OF ACCURACY: 1/200

PROVEN SOURCE OF ELEVATION: SUBMETER MAPPING GRADE GPS

(+) DENOTES LOCATION OF WELL ON UNITED STATES TOPOGRAPHIC MAPS
WVDEP

OFFICE OF OIL & GAS
601 57TH STREET
CHARLESTON, WV 25304

Well Type: ☐ Oil ☐ Waste Diposal ☐ Production ☐ Deep
☒ Gas ☐ Liquid Injection ☐ Storage ☒ Shallow

WATERSHED: DUNKARD CREEK

COUNTY/DISTRICT: MONONGALIA / CLAY

SURFACE OWNER: BRYAN & SIERRA VANNORMAN

OIL & GAS ROYALTY OWNER: MARK V EDDY

LEASE NUMBERS:

DRILL ☒ CONVERT ☐ DRILL DEEPER ☐ REDRILL ☐ FRACTURE OR STIMULATE ☒
PLUG OFF FORMATION ☐ PERFORATE NEW FORMATION ☐ PLUG & ABANDON ☐
CLEAN OUT & REPLUG ☐ OTHER CHANGE ☐ (SPECIFY):

TARGET FORMATION: MARCELLUS

WELL OPERATOR: NORTHEAST NATURAL ENERGY LLC

ADDRESS: 707 VIRGINIA STREET EAST, SUITE 1200

CITY: CHARLESTON STATE: WV ZIP CODE: 25301

DRILLED DEPTH: TVD: 8,308' TMD: 23,859'

DESIGNATED AGENT: JOHN ADAMS

ADDRESS: 707 VIRGINIA STREET EAST, SUITE 1200

CITY: CHARLESTON STATE: WV ZIP CODE: 25301

PLAT IS CORRECT TO THE BEST OF MY KNOWLEDGE AND BELIEF AND SHOWS ALL THE INFORMATION REQUIRED BY LAW AND THE REGULATIONS ISSUED AND PRESCRIBED BY THE DEPARTMENT OF ENVIRONMENTAL PROTECTION.

Signed:

L.L.S. #2124 Ernest J. Benchek III

DATE: APRIL 15, 2025

OPERATOR'S WELL #: DOLLS RUN 5H AS-DRILLED


API WELL #: 47 61 01930
STATE COUNTY PERMIT


AS-BUILT ELEVATION: 1,522.6'

QUADRANGLE: OSAGE

ACREAGE: 27.74 09/19/2025

ACREAGE: 1.59.08 +/-

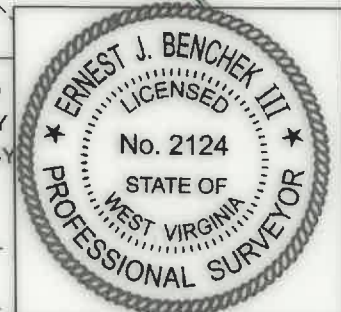

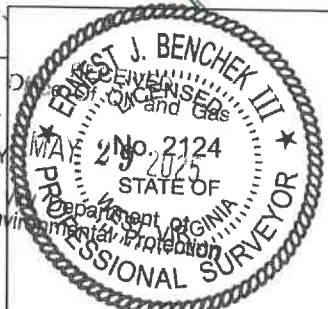CITY: CHARLESTON STATE: WV ZIP CODE: 25301

PROPERTY OWNER INDEX	
3-17-3	PENN PLASTIC CO
4-12-6	ALPHEUS MICHAEL HENDERSON
4-12-8	JOHN F BELL JR & VIVIAN J BELL
4-12-10.3	MAVIS I EDDY
4-12-28	MELISSA T HETTMAN & ERIN ALLEN
4-12-29.8	MELISSA T HETTMAN & ERIN ALLEN
4-12-29.10	DEANNA S TENNANT
4-12-29.12	MELISSA T HETTMAN & ERIN ALLEN
4-12-30	ROBERT C WALLS FAMILT TRUST (LIFE- DIANA LYNN WALLS)
4-12-33	JOHN F BELL JR & VIVIAN J BELL
4-12-35	ROBERT LYNN CORE
4-12-65	BLAKE R & H PRESTON BOGGESS
4-15-36	GEORGE E & MARGARET A REEL
4-15-37	LEROY E & GLENNA J TENNANT LEGACY PROTECTOR TRUST
4-15-37.1	LEROY E & GLENNA J TENNANT LEGACY PROTECTOR TRUST
4-15-37.2	LEROY E & GLENNA J TENNANT LEGACY PROTECTOR TRUST
4-15-38	LEROY E & GLENNA J TENNANT LEGACY PROTECTOR TRUST
4-15-40	LEROY E & GLENNA J TENNANT LEGACY PROTECTOR TRUST
4-15-41	DONNA N & ROBERT ALLEN WRIGHT
4-22-33.1	DENNIS J & MELINDA S THORNE
4-15-24	RICHARD L & THOMASINE WEBER
7-7-1	OWEN REALTY CO INC

LEASE INDEX			
A	WV-061-004020-000	K	WV-061-006385-001
B	WV-061-086230-001	L	WV-061-004662-000
C	WV-061-005246-002	M	WV-061-001111-008
D	WV-061-106300-001	N	WV-061-006385-001
E	WV-061-086005-001	O	WV-061-004267-001
F	WV-061-006385-001	P	WV-061-002357-000
G	WV-061-006385-001	Q	WV-061-006044-002
H	WV-061-003269-003	R	WV-061-003768-014
I	WV-061-003269-003	S	WV-061-005143-003
J	WV-061-005524-007	T	WV-061-003525-012

RECEIVED
Office Of Oil and Gas
MAY 29 2025
WV Department of
Environmental Protection

09/19/2025

FILE #: NEE14
DRAWING #: 3041
SCALE: N/A

DATE: APRIL 15, 2025
OPERATOR'S WELL #: DOLLS RUN 5H AS-DRILLED
API WELL #: 47 61 01930
STATE COUNTY PERMIT