


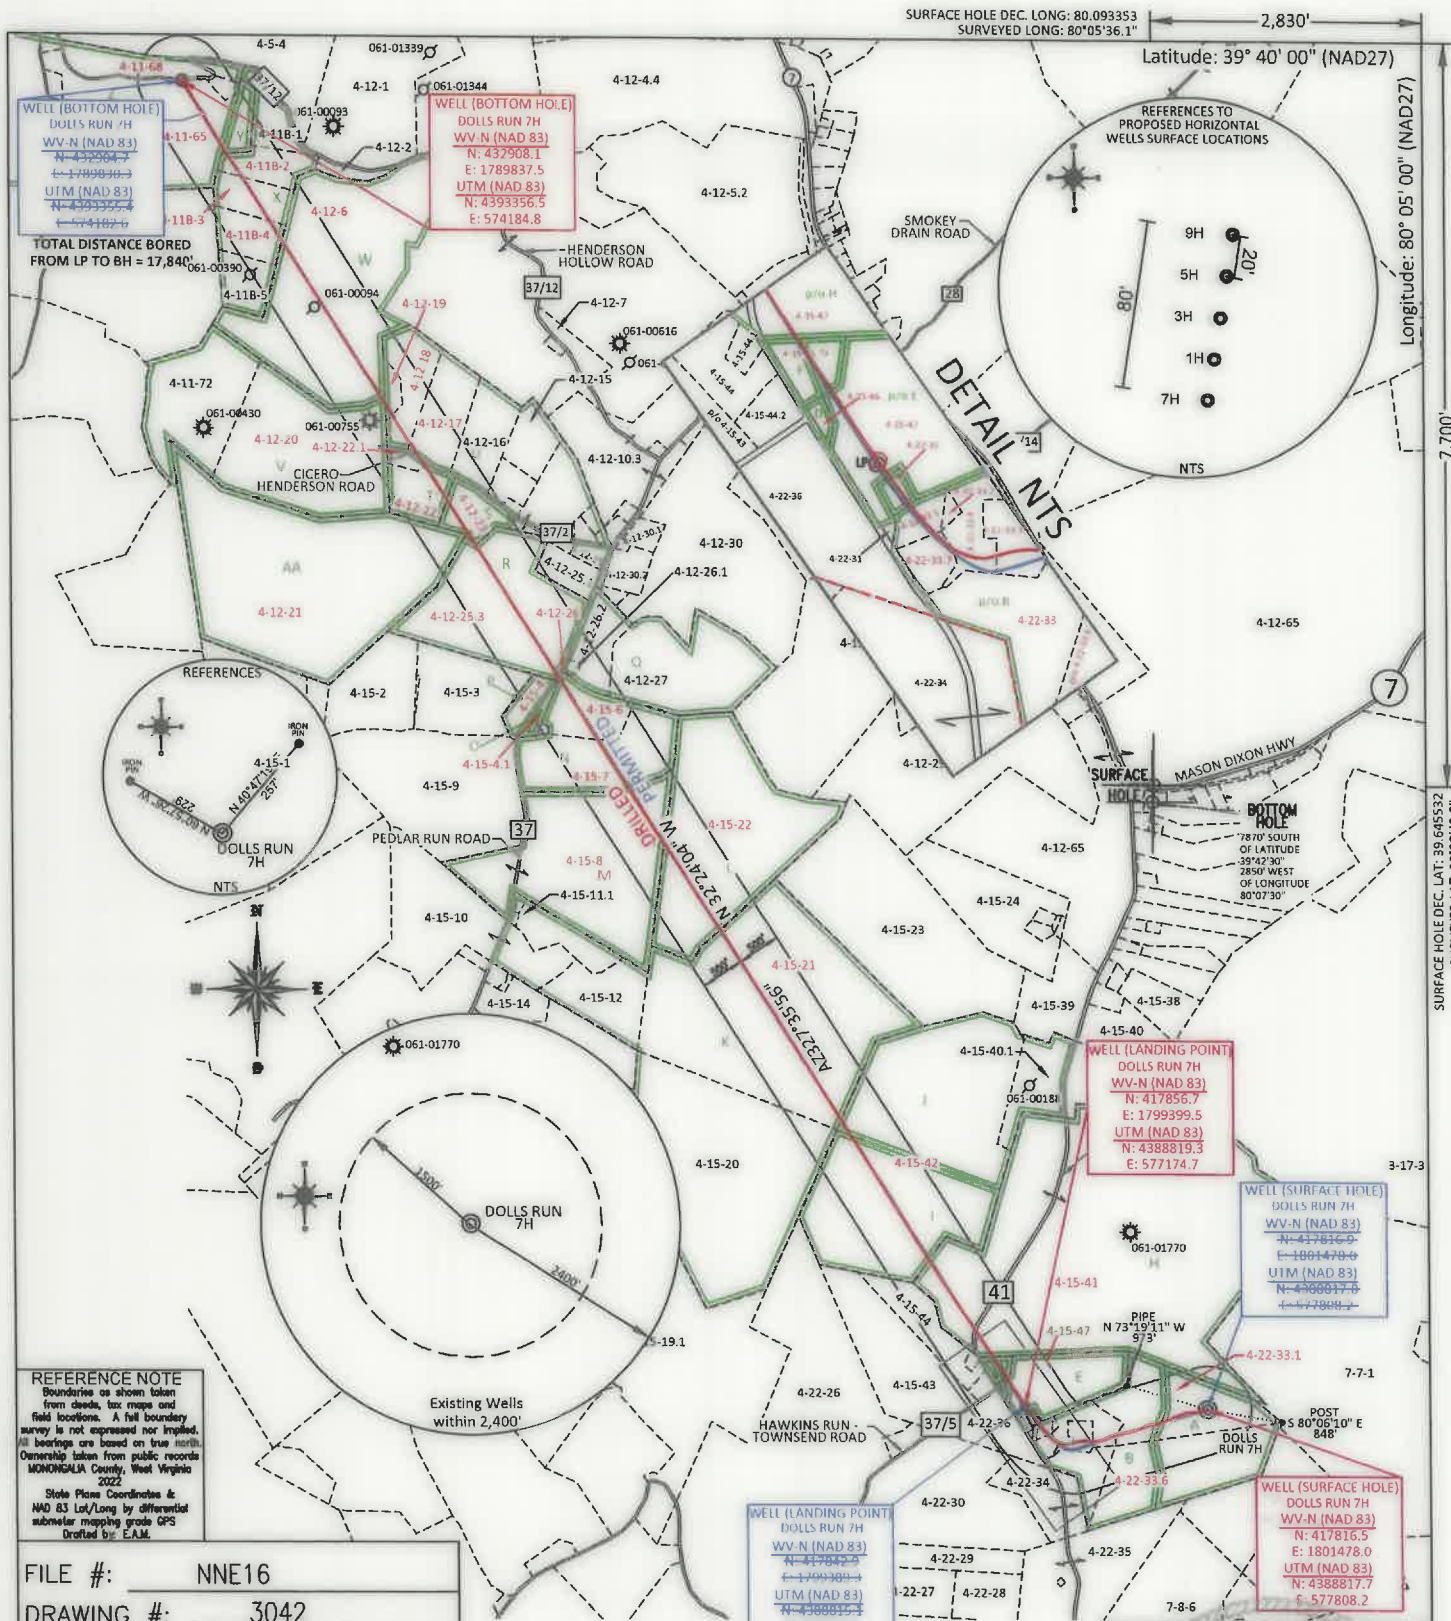


REFERENCE NOTE
Boundaries as shown taken from deeds, tax maps and field locations. A full boundary survey is not expressed nor implied. All bearings are based on true north. Ownership taken from public records MONONGALIA County, West Virginia 2022.
State Plane Coordinates & NAD 83 Lat/Long by differential submeter mapping grade GPS. Drafted by: E.A.M.

FILE #: NNE16
DRAWING #: 3042
SCALE: PLAT: 1" = 2200'
TICK: 1" = 2000'
MINIMUM DEGREE OF ACCURACY: 1/200
PROVEN SOURCE OF ELEVATION: SUBMETER MAPPING GRADE GPS

PLAT IS CORRECT TO THE BEST OF MY KNOWLEDGE AND BELIEF AND SHOWS ALL THE INFORMATION REQUIRED BY LAW AND THE REGULATIONS ISSUED AND PRESCRIBED BY THE DEPARTMENT OF ENVIRONMENTAL PROTECTION.

Signed: *[Signature]*
L.L.S. #2124 Ernest J. Benchek III

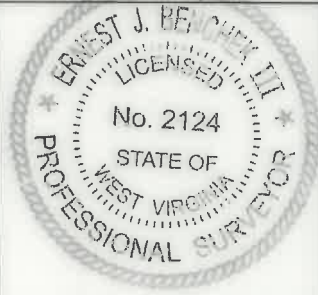

(+) DENOTES LOCATION OF WELL ON UNITED STATES TOPOGRAPHIC MAPS
WYDEP
OFFICE OF OIL & GAS
601 57TH STREET
CHARLESTON, WV 25304
Well Type: ☐ Oil ☐ Waste Diposal ☐ Production ☐ Deep
☒ Gas ☐ Liquid Injection ☐ Storage ☒ Shallow
WATERSHED: DUNKARD CREEK
COUNTY/DISTRICT: MONONGALIA / CLAY
SURFACE OWNER: BRYAN & SIERRA VANNORMAN
OIL & GAS ROYALTY OWNER: MARK V EDDY
LEASE NUMBERS:

DATE: FEBRUARY 12, 2024
OPERATOR'S WELL #: DOLLS RUN 7H
API WELL #: 47 61 01931
STATE COUNTY PERMIT
AS-BUILT ELEVATION: 1,522.6'
QUADRANGLE: OSAGE
ACREAGE: 27.76
ACREAGE: 1,563.611 +/-

DRILL ☒ CONVERT ☐ DRILL DEEPER ☐ REDRILL ☐ FRACTURE OR STIMULATE ☒
PLUG OFF FORMATION ☐ PERFORATE NEW FORMATION ☐ PLUG & ABANDON ☐
CLEAN OUT & REPLUG ☐ OTHER CHANGE ☐ (SPECIFY):
TARGET FORMATION: MARCELLUS
WELL OPERATOR: NORTHEAST NATURAL ENERGY LLC
ADDRESS: 707 VIRGINIA STREET EAST, SUITE 1200
CITY: CHARLESTON STATE: WV ZIP CODE: 25301
DESIGNATED AGENT: JOHN ADAMS
ADDRESS: 707 VIRGINIA STREET EAST, SUITE 1200
CITY: CHARLESTON STATE: WV ZIP CODE: 25301

	PROPERTY OWNER INDEX
4-12-25.3	JEFFERY & MARTHA J BARON
4-15-6	MARY RUTH JOHNSON
4-15-4.1	DAVID L & BARBARA L STULL
4-15-7	MARK V & BETTY EDDY
4-15-22	MARK V & BETTY A EDDY
4-15-8	MARK V & BETTY A EDDY
4-15-21	STATE OF WEST VIRGINIA BUREAU OF COMMERCE
4-15-42	STATE OF WEST VIRGINIA BUREAU OF COMMERCE
4-15-41	DONNA N & ROBERT ALLEN WRIGHT
4-15-47	MARVIN E MORRIS
4-22-33.1	DENNIS J & MELINDA S THORNE
4-22-33.6	DANIEL D & MARTHA P SPERANDIO
4-15-45	MILFORD RAY MORRIS
4-15-46	MARVIN E MORRIS
4-22-32	MARVIN E MORRIS
4-22-33.7	BRENDA LEA MERRIFIELD & THORTON LEE MERRIFIELD JR
4-22-33	GARY & REBECCA SPERANDIO
4-15-4	ELIZABETH JUNE JONES & KATHRYN JOYCE TENNANT
4-12-26	MARY RUTH JOHNSON
4-22-33.5	DANIEL D & MARTHA P SPERANDIO
4-22-33.4	MELINDA S & DENNIS J THORNE
4-22-33.3	MICHAEL M FRAME
4-12-23	RONALD A LEMLEY
4-12-22	RONALD A LEMLEY
4-12-20	CLARENCE W LEMLEY JR & CHARLOTTE E
4-12-22.1	RONALD A LEMLEY
4-12-17	JOSHUA M SANDONE
4-12-18	JOSHUA M SANDONE
4-12-19	JOSHUA M SANDONE
4-12-6	ALPHEUS MICHAEL HENDERSON
4-12-21	VINCENT KOLANKO, MARK SELLARO & CRA PROPERTIES
4-11B-2	GARRETT SAURBORN
4-11B-4	STACY D RILEY
4-11B-3	RICHARD A FRANCIS
4-11-65	JOSEPH C & LOUIE A STATLER
4-11-68	ADRIANE NICOLE & JOHN SCHAUFFNER; DAVID
	SCHAUFFNER; NICHOLAS SCHAUFFNER

	LEASE INDEX			
A	WV-061-004020-000	O	WV-061-006094-001	
B	WV-061-004020-000	P	WV-061-005771-001	
C	WV-061-005830-001	Q	WV-061-005963-003	
D	WV-061-005983-003	R	WV-061-006203-001	
E	WV-061-005830-001	S	WV-061-006234-001	
F	WV-061-006124-001	T	WV-061-003544-002	
G	WV-061-006124-001	U	WV-061-003475-015	
H	WV-061-005246-002	V	WV-061-004058-000	
I	WV-061-004238-001	W	WV-061-004058-000	
J	WV-061-004237-001	X	WV-061-006234-001	
K	WV-061-004240-001	Y	WV-061-005690-001	
L	WV-061-004255-001	Z	WV-061-003575-001	
M	WV-061-004202-001	AA	WV-061-006234-001	
N	WV-061-005617-002			

RECEIVED
Office Of Oil and Gas

MAY 29 2025

WV Department of
Environmental Protection

09/19/2025

FILE #: NEE14	DATE: FEBRUARY 12, 2024
DRAWING #: 3042	OPERATOR'S WELL #: DOLLS RUN 7H
SCALE: N/A	API WELL #: 47 61 01931 STATE COUNTY PERMIT