


WELL NAME: DOLLS RUN 9H
OSAGE, WV

TOTAL DISTANCE BORED
FROM LP TO BH = 15,010'

07/14/2023

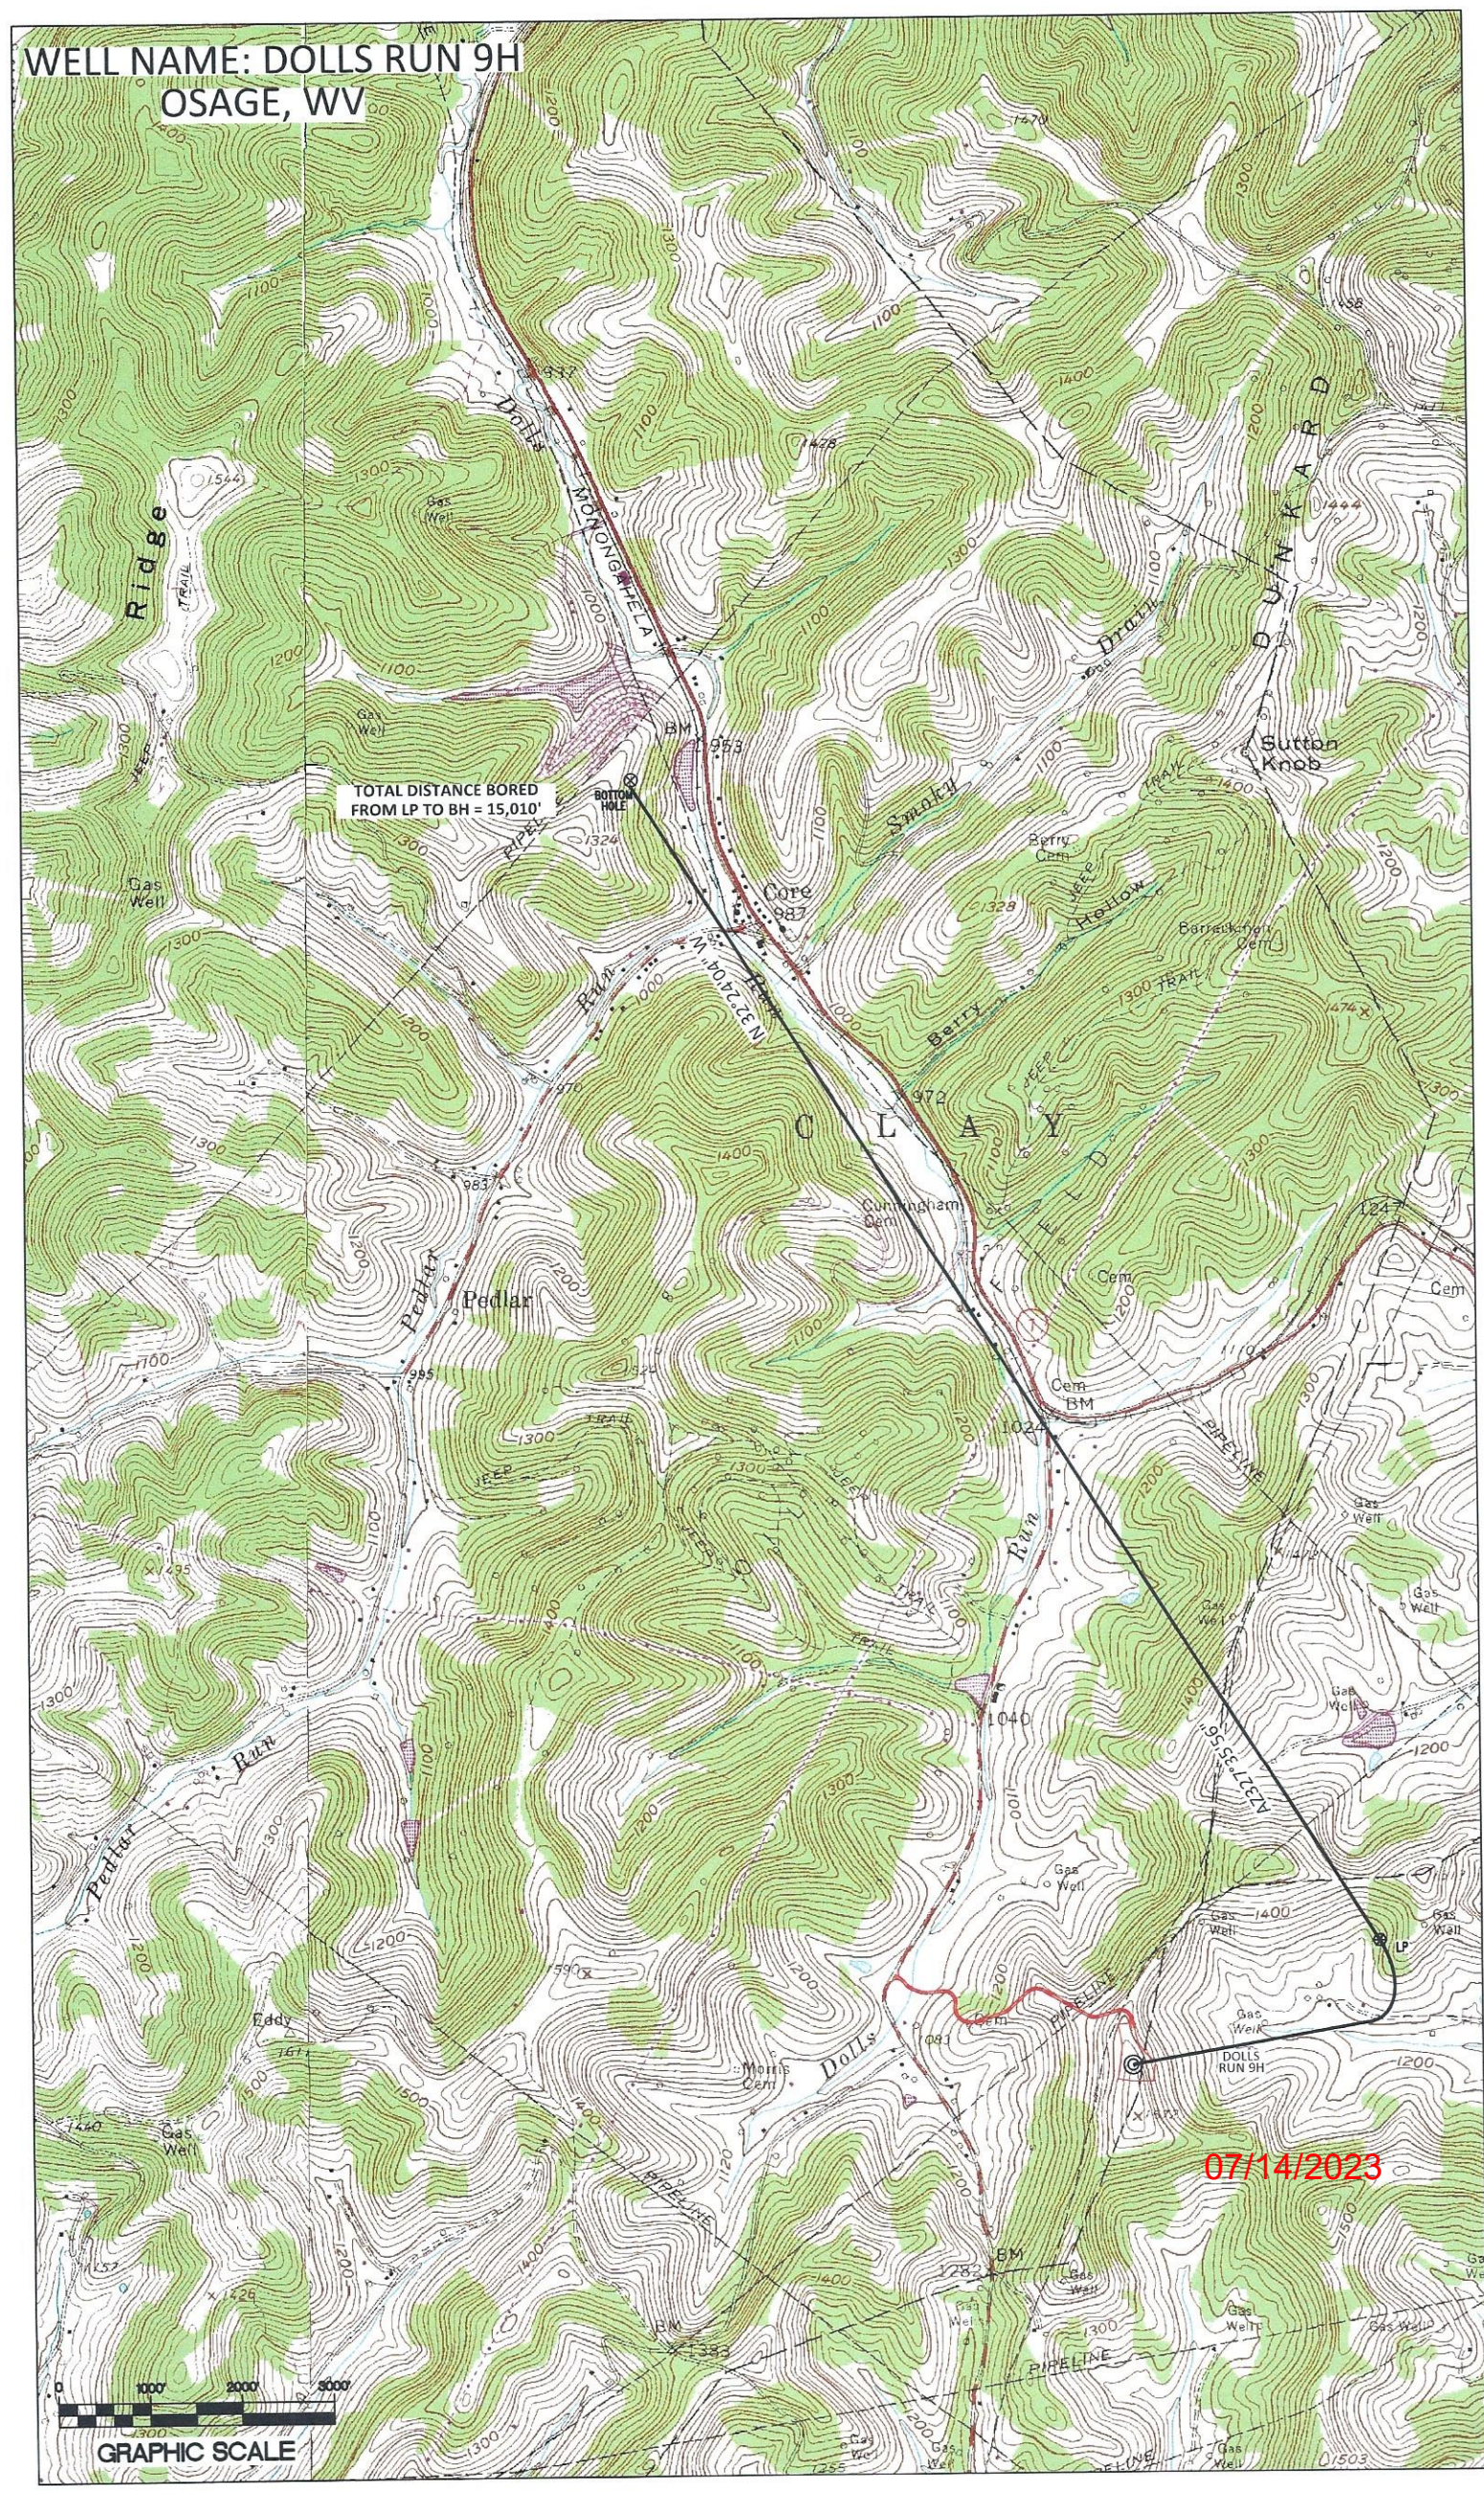

PROPERTY OWNER INDEX	
4-12-5.2	STATE OF WEST VIRGINIA BUREAU OF COMMERCE
4-12-42	MARY ANN HIGGINBOTHAM
4-12-46	TRAVIS D & SUSIE J ANDERSON
4-12-35	ROBERT LYNN CORE
4-12-29.10	DEANNA S TENNANT
4-12-65	BLAKE R & H PRESTON BOGCESS
3-17-3	PENN PLASTIC CO
4-15-41	DONNA N & ROBERT ALLEN WRIGHT
4-22-33.1	DENNIS J & MELINDA S THORNE
7-7-1	OWEN REALTY CO INC
7-2-1	MARK S HASELEU & KELLEY J OWEN
7-2-22	MARK S HASELEU & KELLEY J OWEN
4-15-26	DEANNA S TENNANT
4-15-30.9	DONNA SUE & DAVID JONES
4-15-30.8	RYAN C HOXTER
4-15-30.7	LAURIE NICHOL COZORT
4-15-30.5	DAVE & DONNA JONES
4-15-30.3	LAURIE NICHOL COZORT
4-15-30.4	LAURIE NICHOL COZORT
4-15-31	TIMOTHY G LIMING ET AL
4-15-32	SUSAN BETH KISH
4-15-32.1	KEITH R WRIGHT ET AL
4-15-33	LOUIS TOLKA JR & LINDA LOU TOLKA
4-15-34	YOST FAMILY REVOCABLE TRUST AGREEMENT
4-12-29.3	CHARLES N HOY IRREVOCABLE TRUST
4-12-29.16	CHRISTOPHER D & TERESA A TENNANT
4-12-29.13	CHRISTOPHER D & TERESA A TENNANT
4-15-25	MARK V & BETTY A EDDY
4-12-43	KAREN R SELF POLING
4-12-44	KAREN R SELF POLING
4-12-69	STATE OF WEST VIRGINIA BUREAU OF COMMERCE
4-12-46.3	WEST VIRGINIA DEPARTMENT OF HIGHWAYS
4-12-48	ROBERT LYNN CORE
4-12-29.4	CHRISTOPHER D & TERESA A TENNANT
4-12-29.5	CORE PROPERTIES LLC

LEASE INDEX			
A	WV-061-004020-000	K	WV-061-006385-001
B	WV-061-005246-002	L	WV-061-006385-001
C	WV-061-086230-001	M	WV-061-004662-000
D	WV-061-106300-001	N	WV-061-005202-000
E	WV-061-106300-001	O	WV-061-006385-001
F	WV-061-086005-001	P	WV-061-004267-001
G	WV-061-086005-001	Q	WV-061-004645-006
H	WV-061-086005-001	R	WV-061-006003-001
I	WV-061-003269-003	S	WV-061-005944-001
J	WV-061-003269-003	T	WV-061-005944-001

07/14/2023

FILE #: NEE14

DRAWING #: 3043

SCALE: N/A

DATE: JUNE 21, 2023

OPERATOR'S WELL #: DOLLS RUN 9H

API WELL #: 47 61 01932 H6A
STATE COUNTY PERMIT