

110631

SURFACE HOLE DEC. LONG: 80.099312
SURVEYED LONG: 80°05'36.0"


2,820'

Latitude: 39° 40' 00" (NAD27)

Longitude: 80° 05' 00" (NAD27)

7,660'

SURFACE HOLE DEC. LAT: 39.665749
SURVEYED LAT: 39°38'44.7"

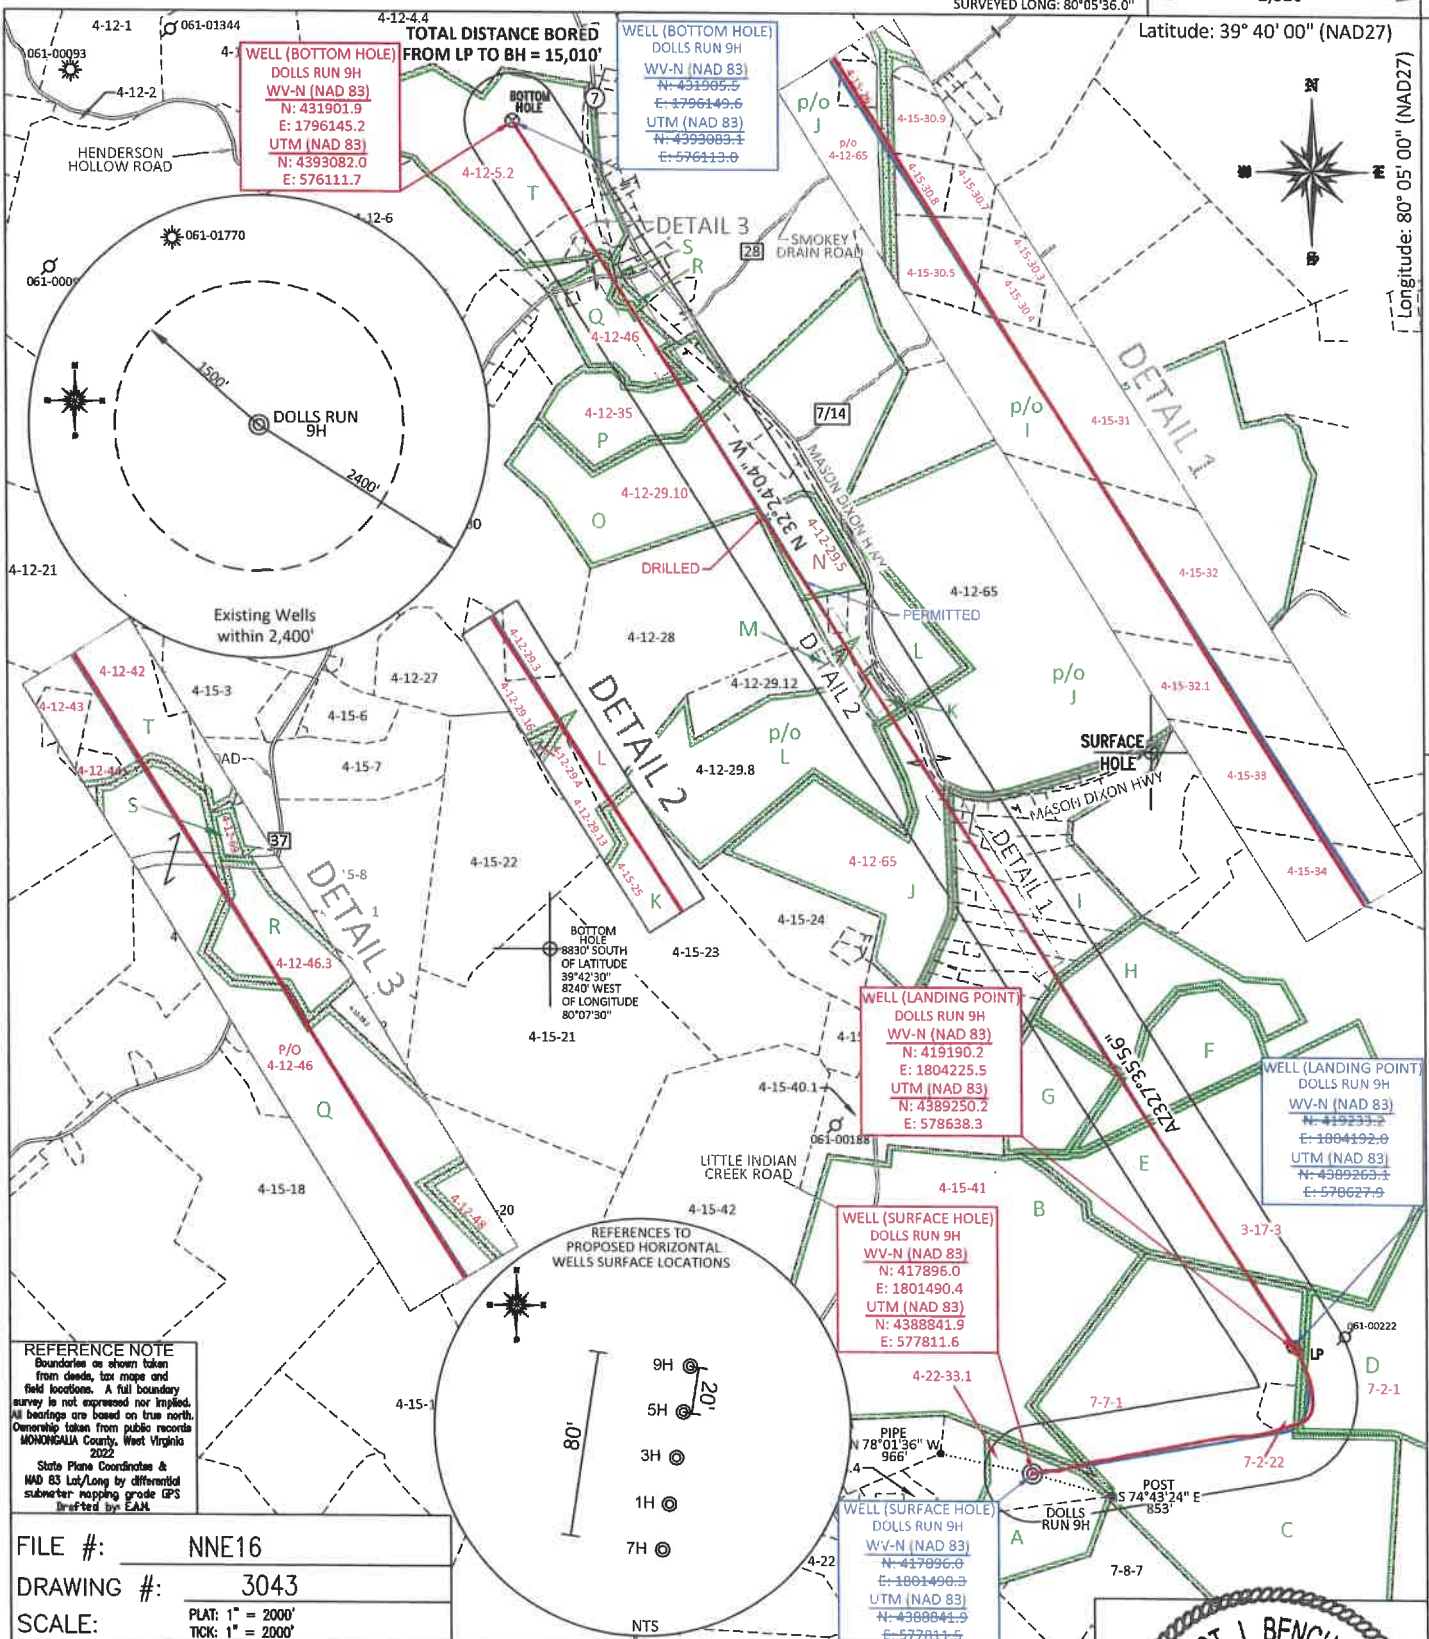

REFERENCE NOTE
Boundaries as shown taken from deeds, tax maps and field locations. A full boundary survey is not expressed nor implied. All bearings are based on true north. Ownership taken from public records MONONGALIA County, West Virginia 2022
State Plane Coordinates & NAD 83 Lat/Long by differential submeter mapping grade GPS verified by EAM

FILE #: NNE16
DRAWING #: 3043
SCALE: PLAT: 1" = 2000'
TICK: 1" = 2000'
MINIMUM DEGREE OF ACCURACY: 1/200
PROVEN SOURCE OF ELEVATION: SUBMETER MAPPING GRADE GPS

(+) DENOTES LOCATION OF WELL ON UNITED STATES TOPOGRAPHIC MAPS
WVDEP

OFFICE OF OIL & GAS
601 57TH STREET
CHARLESTON, WV 25304

Well Type: ☐ Oil ☐ Waste Diposal ☐ Production ☐ Deep
☒ Gas ☐ Liquid Injection ☐ Storage ☒ Shallow


WATERSHED: DUNKARD CREEK
COUNTY/DISTRICT: MONONGALIA / CLAY
SURFACE OWNER: BRYAN & SIERRA VANNORMAN
OIL & GAS ROYALTY OWNER: MARK V EDDY
LEASE NUMBERS:

DRILL ☒ CONVERT ☐ DRILL DEEPER ☐ REDRILL ☐ FRACTURE OR STIMULATE ☒
PLUG OFF FORMATION ☐ PERFORATE NEW FORMATION ☐ PLUG & ABANDON ☐
CLEAN OUT & REPLUG ☐ OTHER CHANGE ☐ (SPECIFY):

TARGET FORMATION: MARCELLUS
WELL OPERATOR: NORTHEAST NATURAL ENERGY LLC
ADDRESS: 707 VIRGINIA STREET EAST, SUITE 1200
CITY: CHARLESTON STATE: WV ZIP CODE: 25301

PLAT IS CORRECT TO THE BEST OF MY KNOWLEDGE AND BELIEF AND SHOWS ALL THE INFORMATION REQUIRED BY LAW AND THE REGULATIONS ISSUED AND PRESCRIBED BY THE DEPARTMENT OF ENVIRONMENTAL PROTECTION.

Signed:
L.L.S. #2124 : Ernest J. Benchek III

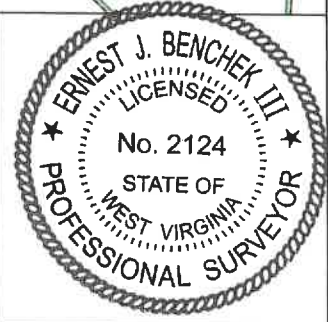

RECEIVED
Office of Oil and Gas
DATE: APRIL 15, 2025
OPERATOR'S WELL #: DOLLS RUN 9H AS-DRILLED
WELL #: 47 61 01932
WV Department of Environmental Protection STATE COUNTY PERMIT

AS-BUILT ELEVATION: 1,522.6'
QUADRANGLE: OSAGE
ACREAGE: 27.74
ACREAGE: 1,694.04 +/-

DRILLED DEPTH: TVD: 8,322' TMD: 24,465'
DESIGNATED AGENT: JOHN ADAMS
ADDRESS: 707 VIRGINIA STREET EAST, SUITE 1200
CITY: CHARLESTON STATE: WV ZIP CODE: 25301

	PROPERTY OWNER INDEX
4-12-5.2	STATE OF WEST VIRGINIA BUREAU OF COMMERCE
4-12-42	MARY ANN HIGGINBOTHAM
4-12-46	TRAVIS D & SUSIE J ANDERSON
4-12-35	ROBERT LYNN CORE
4-12-29.10	DEANNA S TENNANT
4-12-65	BLAKE R & H PRESTON BOGGESS
3-17-3	PENN PLASTIC CO
4-15-41	DONNA N & ROBERT ALLEN WRIGHT
4-22-33.1	DENNIS J & MELINDA S THORNE
7-7-1	OWEN REALTY CO INC
7-2-1	MARK S HASELEU & KELLEY J OWEN
7-2-22	MARK S HASELEU & KELLEY J OWEN
4-15-26	DEANNA S TENNANT
4-15-30.9	DONNA SUE & DAVID JONES
4-15-30.8	RYAN C HOXTER
4-15-30.7	LAURIE NICHOL COZORT
4-15-30.5	DAVE & DONNA JONES
4-15-30.3	LAURIE NICHOL COZORT
4-15-30.4	LAURIE NICHOL COZORT
4-15-31	TIMOTHY G LIMING ET AL
4-15-32	SUSAN BETH KISH
4-15-32.1	KEITH R WRIGHT ET AL
4-15-33	LOUIS TOLKA JR & LINDA LOU TOLKA
4-15-34	YOST FAMILY REVOCABLE TRUST AGREEMENT
4-12-29.3	CHARLES N HOY IRREVOCABLE TRUST
4-12-29.16	CHRISTOPHER D & TERESA A TENNANT
4-12-29.13	CHRISTOPHER D & TERESA A TENNANT
4-15-25	MARK V & BETTY A EDDY
4-12-43	KAREN R SELF POLING
4-12-44	KAREN R SELF POLING
4-12-69	STATE OF WEST VIRGINIA BUREAU OF COMMERCE
4-12-46.3	WEST VIRGINIA DEPARTMENT OF HIGHWAYS
4-12-48	ROBERT LYNN CORE
4-12-29.4	CHRISTOPHER D & TERESA A TENNANT
4-12-29.5	CORE PROPERTIES LLC

	LEASE INDEX		
A	WV-061-004020-000	K	WV-061-006385-001
B	WV-061-005246-002	L	WV-061-006385-001
C	WV-061-086230-001	M	WV-061-004662-000
D	WV-061-106300-001	N	WV-061-005202-000
E	WV-061-106300-001	O	WV-061-006385-001
F	WV-061-086005-001	P	WV-061-004267-001
G	WV-061-086005-001	Q	WV-061-004645-006
H	WV-061-086005-001	R	WV-061-006003-001
I	WV-061-003269-003	S	WV-061-005944-001
J	WV-061-003269-003	T	WV-061-005944-001

RECEIVED
Office Of Oil and Gas
MAY 29 2025
WV Department of
Environmental Protection

09/19/2025

FILE #: NEE14	DATE: APRIL 15, 2025
DRAWING #: 3043	OPERATOR'S WELL #: DOLLS RUN 9H AS-DRILLED
SCALE: N/A	API WELL #: 47 61 01932 STATE COUNTY PERMIT