


FILE #: NEE14
 DRAWING #: 4050
 SCALE: PLAT: 1" = 2200' TICK MARK: 1" = 2000'
 MINIMUM DEGREE OF ACCURACY: 1/200
 PROVEN SOURCE OF ELEVATION: SUBMETER MAPPING GRADE GPS

I, THE UNDERSIGNED, HEREBY CERTIFY THAT THIS PLAT IS CORRECT TO THE BEST OF MY KNOWLEDGE AND BELIEF AND SHOWS ALL THE INFORMATION REQUIRED BY LAW AND THE REGULATIONS ISSUED AND PRESCRIBED BY THE DEPARTMENT OF ENVIRONMENTAL PROTECTION.
 Signed: *[Signature]*
 L.L.S. #2124 : Ernest J. Benchek III

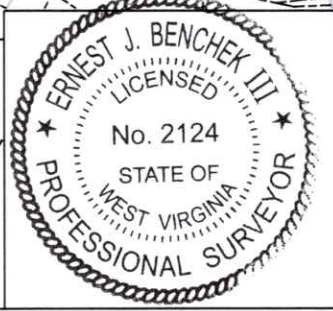

(+) DENOTES LOCATION OF WELL ON UNITED STATES TOPOGRAPHIC MAPS WVDEP
 OFFICE OF OIL & GAS
 601 57TH STREET
 CHARLESTON, WV 25304
 Well Type: Oil Waste Diposal Production Deep
 Gas Liquid Injection Storage Shallow
 WATERSHED: DUNKARD CREEK
 COUNTY/DISTRICT: MONONGALIA / CLAY
 SURFACE OWNER: PATRICIA A. BUNNER
 OIL & GAS ROYALTY OWNER: PATRICIA BUNNER, et al
 LEASE NUMBERS: _____

DATE: OCTOBER 9, 2025
 OPERATOR'S WELL #: BUNNER 19H AS-DRILLED
 API WELL #: 47 STATE 61 COUNTY 01967 PERMIT
 AS-BUILT ELEVATION: 1,277.25'

QUADRANGLE: BLACKSVILLE, WV
 ACREAGE: 91.93 +/-
 ACREAGE: 1355.58 +/-

DRILL CONVERT DRILL DEEPER REDRILL FRACTURE OR STIMULATE
 PLUG OFF FORMATION PERFORATE NEW FORMATION PLUG & ABANDON
 CLEAN OUT & REPLUG OTHER CHANGE (SPECIFY): _____

TARGET FORMATION: MARCELLUS
 DRILLED DEPTH: TVD: 7,965' TMD: 25,930'
 WELL OPERATOR: NORTHEAST NATURAL ENERGY LLC
 ADDRESS: 707 VIRGINIA STREET EAST, SUITE 1200
 CITY: CHARLESTON STATE: WV ZIP CODE: 25301
 DESIGNATED AGENT: JOHN ADAMS
 ADDRESS: 707 VIRGINIA STREET EAST, SUITE 1200
 CITY: CHARLESTON STATE: WV ZIP CODE: 25301

04/24/2026

| PROPERTY OWNER INDEX | |
|----------------------|---|
| 1-7-36 | JERRY L & MARGARET E WILSON |
| 1-7-37 | ERIC MONTGOMERY |
| 1-7-55 | BRUCE & KAREN W HAUGHT |
| 1-7-55.3 | RICHARD E SHRIVER |
| 1-7-56.1 | RICHARD E SHRIVER |
| 1-7-56.2 | PENNSYLVANIA LINES LLC |
| 1-14-30 | FOX JOHN TRUST FOR BONNIE HUMBERTSON |
| 1-14-30.2 | FRANKLIN M CHISLER |
| 1-15-3 | SHUMAN INC |
| 1-15-4 | STANDARD LAND CO LLC & ARKANSAS ENERGY PARTNERS LLC |
| 4-9-20 | KARSON & KIRSTON MOORE (LIFE-JASON T MOORE) |
| 4-9-21 | KARSON & KIRSTON MOORE (LIFE-JASON T MOORE) |
| 4-9-22 | KARSON & KIRSTON MOORE (LIFE-JASON T MOORE) |
| 4-9-27 | RICHARD & SANDY FRANCIS |
| 4-9-29.4 | AMMONS FAMILY TRUST |
| 4-18-1 | EDDY RANDY, SCOTT A STEELE & ET AL & HAMILTONS |
| 4-18-3 | PAMELA SUE ARNETT; DONNA JO & JODIE DAWN SHRIVER |
| 4-18-18 | PRUDENCE G BERRY TERESA TENNANT |
| 4-18-18.1 | GILBERT DONALD BERRY |
| 4-18-19.1 | JASON C & MARY C WEBER |
| 4-18-22 | MARK MYERS |
| 4-18-23 | CARMEL G BROOKOVER JR |
| 4-18-24 | DONNA JO & WEBSTER M VARNER |
| 4-18-27 | DONNA JO & WEBSTER M VARNER |
| 4-18-29 | GILBERT DONALD BERRY (LIFE-ROBERT E BERRY SR) |
| 4-18-29.1 | BILLY VON DEVINE |
| 4-18-30 | PRUDENCE G BERRY |
| 4-18-32 | PATRICIA A BUNNER |

| LEASE INDEX | | | |
|-------------|-------------------|---|-----------------------|
| A | WV-061-004154-001 | N | WV-061-006209-001 |
| B | WV-061-005378-013 | O | WV-061-000209-001-ACT |
| C | WV-061-005966-001 | P | WV-061-006061-002 |
| D | WV-061-005639-001 | Q | WV-061-006061-002 |
| E | WV-061-005917-001 | R | WV-061-006061-002 |
| F | WV-061-005890-001 | S | WV-061-006179-001 |
| G | WV-061-005935-006 | T | WV-061-004400-001 |
| H | WV-061-005931-001 | U | WV-061-005230-001 |
| I | WV-061-006254-004 | V | WV-061-005230-001 |
| J | WV-061-004705-011 | | |
| K | WV-061-005826-001 | | |
| L | WV-061-006362-013 | | |
| M | WV-061-005811-017 | | |

RECEIVED
Office of Oil and Gas
APR 03 2025
WV Department of
Environmental Protection

04/24/2026

| | |
|------------------------|---|
| FILE #: <u>NEE14</u> | DATE: <u>OCTOBER 9, 2025</u> |
| DRAWING #: <u>4050</u> | OPERATOR'S WELL #: <u>BUNNER 19H AS-DRILLED</u> |
| SCALE: <u>N/A</u> | API WELL #: <u>47</u> <u>61</u> <u>01967</u> STATE COUNTY PERMIT |