

LATITUDE 39°42'30"

80° 20' 00"

15  
+

LONGITUDE

7'5 OGIS topo location

7.5' loc	<u>0.615</u>	15' loc	<u>3.495</u>
	<u>0.170</u>	(calc.)	<u>0.170</u>

Company \_\_\_\_\_

Farm \_\_\_\_\_

Quad Wadestown


County Monongahela

District Battle

WELL LOCATION MAP

File No. 061-29A

Abandoned gas well No. 1 of the  
 Eastern Development Co. of Radostown, W. Va. in the  
 City of West Union, consisting of 33 1/2 Acres  
 Located in Hattie No. District, Monongalia County.

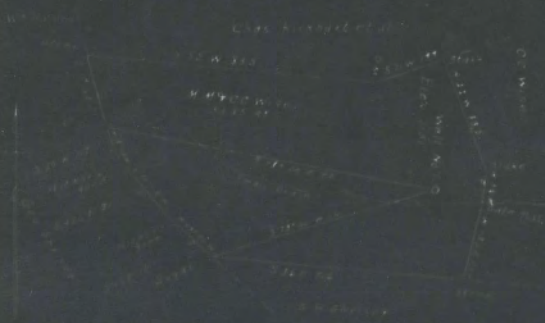

Scale 1/4 inch = 100 feet  
 Property of Eastern Development Co.

Property Certificate

I, the undersigned, hereby certify that this map is correct and  
 true to the best of my knowledge and belief, and that I am the  
 owner of the property described in the foregoing map.

*A. S. [Signature]*

Witness my hand and seal of office this 1st day of May, 1911.  
 A. S. [Signature]  
 County Clerk

*W. C. [Signature]*  
 Surveyor

**WEST VIRGINIA DEPARTMENT OF MINES**  
**Oil and Gas Section**  
**PRELIMINARY DATA SHEET NO. 1**

File No. \_\_\_\_\_ Well No. 2

Harry, L. Tennant Company, of Hubertown

Sept. 28 on date N.M. & C.M. Wigg Perm  
 containing 25.25.25 acres. Location \_\_\_\_\_

McCall District, in Woodsburg County, West Virginia.

The surface of the above tract is owned in fee by C.C. Wigg heirs  
 of Hubertown Sept. 28 address, and the mineral rights are owned by

Harry, L. Tennant of Hubertown, Sept. 28

The oil and gas privileges are held under lease by the above named company, and this well is drilled under  
 permit No. \_\_\_\_\_ issued by the West Virginia Department of Mines, Oil and Gas Section,  
 \_\_\_\_\_ 19 \_\_\_\_\_

Elevation of surface at top of well, \_\_\_\_\_ 1182.75 <sup>feet</sup> <sub>Barometric</sub>

The number of feet of the different sized casings used in the well.

Conductor	6.75	12.12	12.12	12.12	12.12	12.12	12.12
212	feet	10.12	12	12	12	12	12
222	feet	8.2	12	12	12	12	12
232	feet	6	12	12	12	12	12
McCall	packer of	8.2	8.12	12	12	12	12
	packer of						
	in casing perforated at						
	in casing perforated at						

Cul was encountered at 720 ± 200 feet; thickness 60 inches, and at 820 ± 200  
 feet; thickness 28 inches; and at \_\_\_\_\_ feet; thickness \_\_\_\_\_ inches

Liths were used as follows: (Give details)  
 \_\_\_\_\_  
 \_\_\_\_\_  
 \_\_\_\_\_

\_\_\_\_\_ Sept 22 1922 \_\_\_\_\_

Approved Harry L. Tennant  
 By \_\_\_\_\_

Name	Color	Character	Oil, Gas or Water	Top	Bottom	Thickness	Total Depth	Remarks
Conductor				6 ft				
Shale	Dark	Block		788	800			
Shale	Dark	Block		898	922			
Shale	Dark	Block		1078	1080			
Shale	Dark	Block		1080	1089			
Shale	Dark	Block		1700	1708			
Shale	Dark	Block		1840	1888			
Shale	Dark	Block		2100	2136			
Shale	Dark	Block		2116	2121			
Shale	Dark	Block		2121	2129			
Shale	Dark	Block		2190	2208			
Shale	Dark	Block		2248	2276			
Shale	Dark	Block		2204	2209			
Shale	Dark	Block		2224	2231		648	20207
Shale	Dark	Block		2264	2270			

Well was shot at \_\_\_\_\_ feet; well was shot at 2260 feet.

Spit fresh water at \_\_\_\_\_ feet; salt fresh water at \_\_\_\_\_ feet.

Well was producing \_\_\_\_\_ bbls. per day.

\_\_\_\_\_  
 Date Approved \_\_\_\_\_ Owner \_\_\_\_\_

NOTE: All bottom measurements to be given as indicated above and all top-calls and all gas-calls must be checked with the proper instruments to be checked as well as any test made with any well in the district for such work.

**AFFIDAVIT IN TRIPLICATE TO TIME AND MANNER OF  
PLUGGING AND FILLING WELL**

(Formulated by Section 8, Chapter 20, Acts 1921)

**WEST VIRGINIA DEPARTMENT OF MINES  
OIL AND GAS SECTION**

Custer Development Company

J. J. Long, (½ interest Pitts,

Harry L. Tennant, Contractor

COAL OPERATOR coal.)

NAME OF WELL OPERATOR

Mt. Harris, Pa.

Madestown, W. Va.

John Stephens, (½ interest

September 23, 1931

COAL OPERATOR Pitts, coal.)

DATE OF WELL OPERATOR

Waynesburg, Pa.

WELL AND LOCATION

M. H. C. C. Waco, Noire, all other  
Coals, § 1171, U. S. Waco,  
Waco, W. Va.

Battelle, District

Monongalia, County

Well No. 1.

M. H. C. C. Waco, (Noire) Form

AFFIDAVIT TO BE MADE IN COMPLIANCE AND ONLY TO BE MADE BY OPERATOR AND TO THE DEPARTMENT, AND ONLY TO BE RETURNED BY THE DEPARTMENT AND THIS FORM MUST HAVE APPROPRIATE SIGNATURE TO BE FILED IN CASE FILES OPERATING UNDER AUTHORITY OF THESE REGULATIONS.

**AFFIDAVIT**

STATE OF WEST VIRGINIA,

County of Monongalia

Harry L. Tennant

Geo. I. Tennant

being first duly sworn according to law depose and say that they are experienced in the work of plugging

and filling oil and gas wells and were employed by Custer Development Co., well operator, and participated in the work of plugging and filling the above well, that said work was commenced on the

1st day of June, 1931, and that the well was plugged and filled in the following manner:

Put Red clay from 2270 to 2320. Bridged hole at 2320. Red clay from 2320 to 2370. Put stone at 2370. Put in Red clay from 2370 to 2420. Put in stone at 2420. Move lead plug at 2420. Put in Red clay from 2420 to 2470. Bottom of 2 in casing 2470. Pulled the casing thru bridge hole at 2470. Stone 2470 to 2520. Red clay from 2520 to 2570. Move lead plug at 2570. Then put in Red clay from 2570 to 2620. Pulled & increasing and bridged with stone 2620 to 2670. Then put in Red clay from 2670 to 2720. Then connected Pittsburgh and Marietta coals. Cement from 2720 to 2770. Pulled hole 2770 to 2820. Then put in Red clay from 2820 to 2870. Then put in Cement under ground to 2970 above ground. With some of mill on surface.

*OK  
X 7 M*

Description of cement:



that said work was completed on the 23rd day of September, 1931.

And further deposes with us.

Harry L. Tennant  
Geo. I. Tennant

Sworn to and subscribed before me this 14th day of March, 1932.

My Commission expires:

Chas. B. Anderson  
Notary Public