


Latitude 39 45

Longitude 80 15

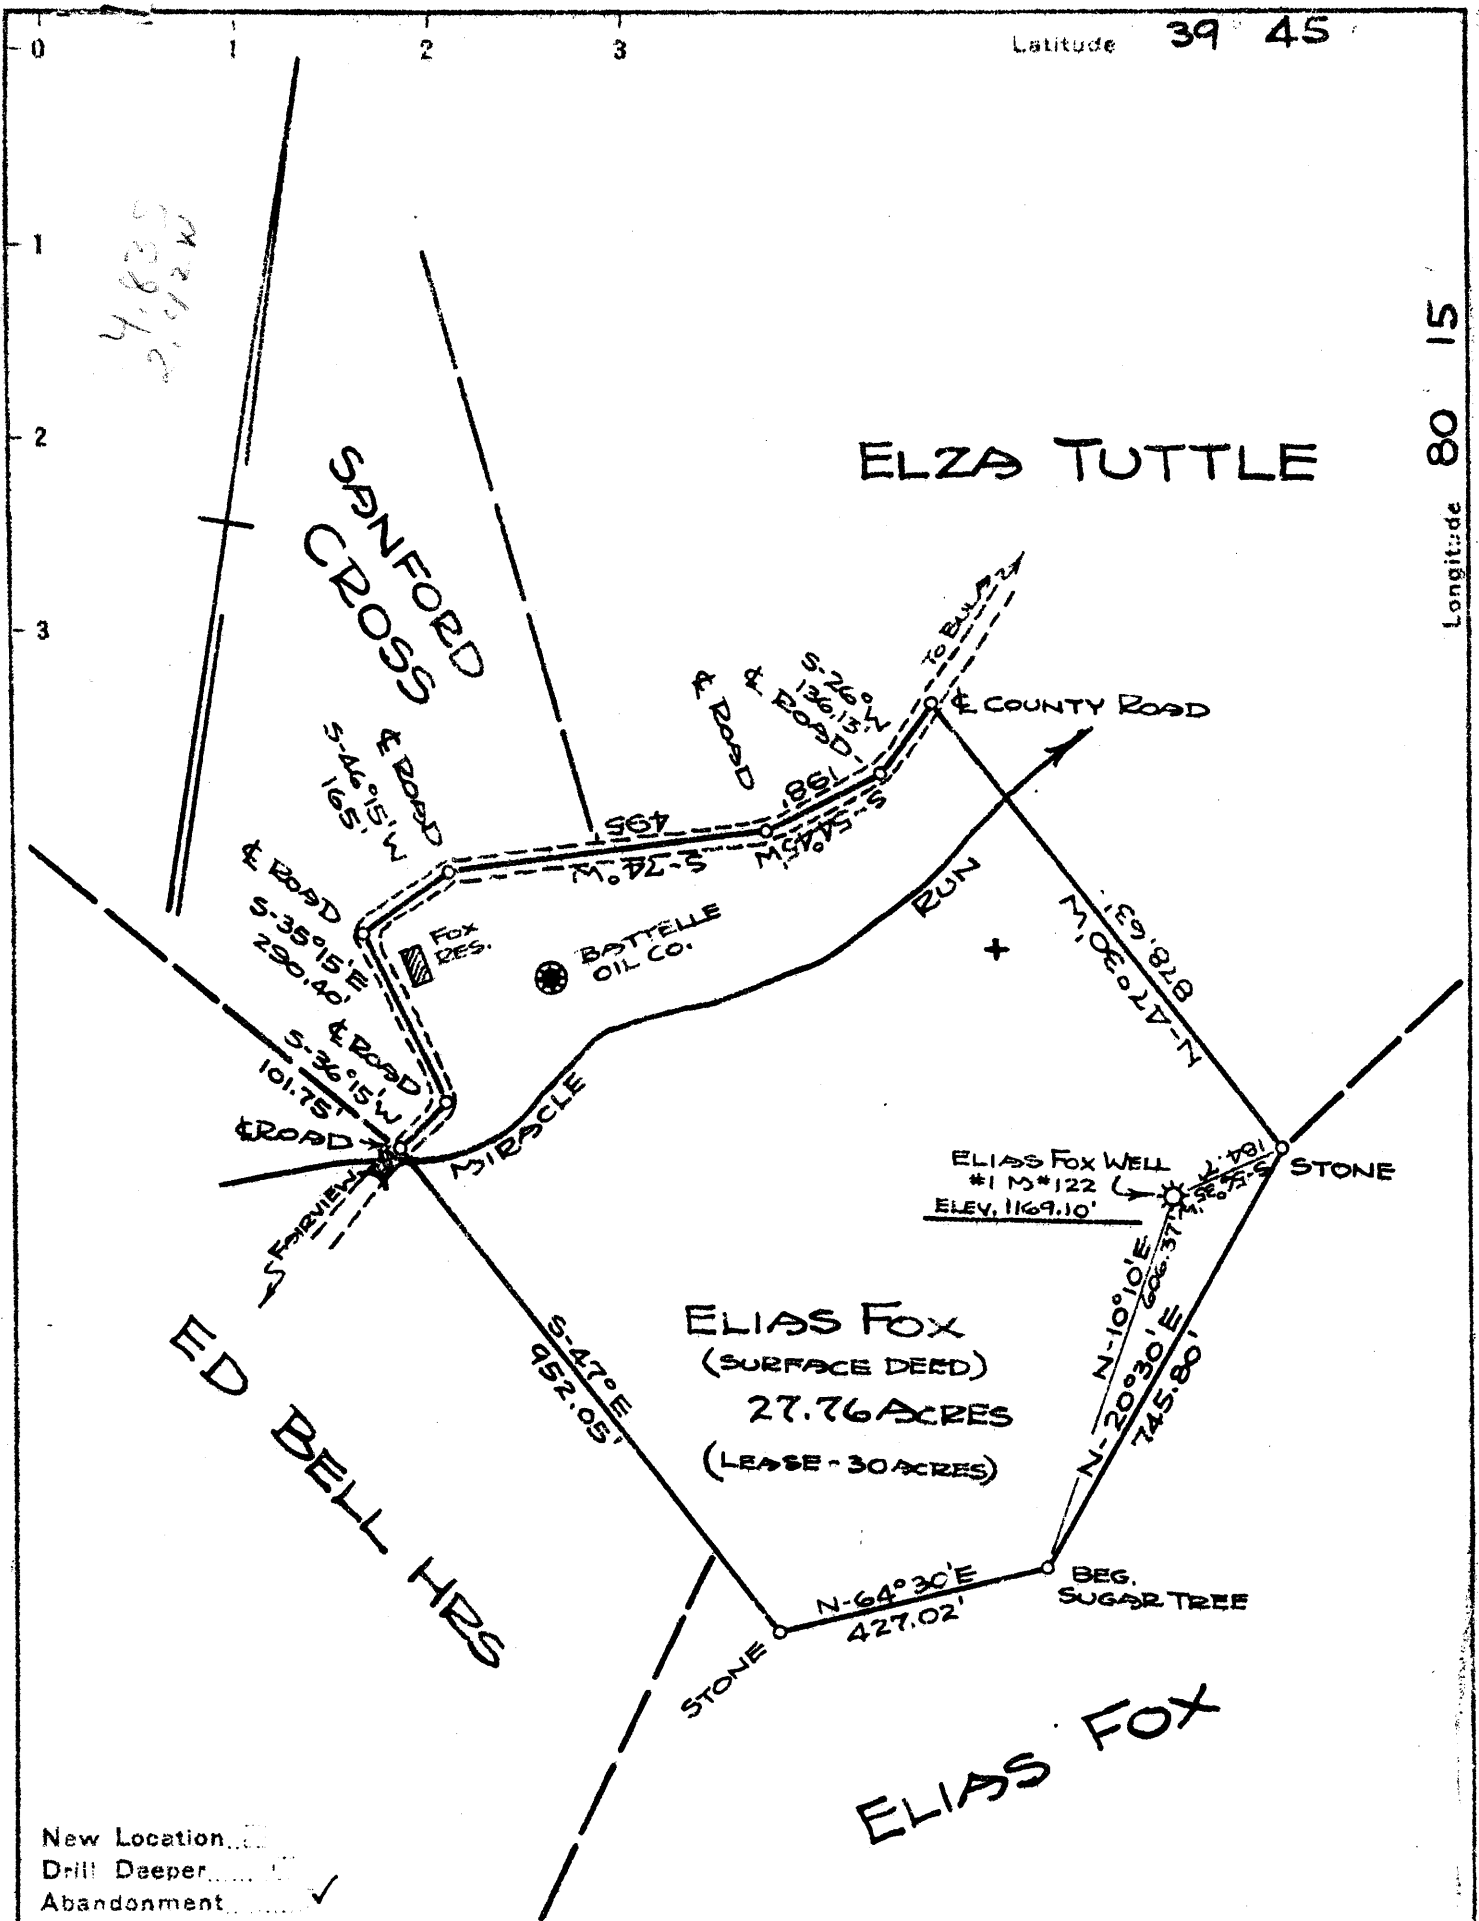

Company MONONGAHELA WEST PENN PUBLIC SERVICE CO.

Address FAIRMONT W.VA.

Farm ELIAS FOX

Tract \_\_\_\_\_ Acres 27.76 Lease No. 705 (30A)

Well (Farm) No. 1 Serial No. M\*122

Elevation (Spirit Level) 1169.10'

Quadrangle MANNINGTON

County MONONGALIA District BATTELLE

Engineer F. A. H. Kelley

Engineer's Registration No. 695

File No. \_\_\_\_\_ Drawing No. B-93043-G

Date 9/30/43 Scale 1" = 300'

STATE OF WEST VIRGINIA  
DEPARTMENT OF MINES  
OIL AND GAS DIVISION  
CHARLESTON

WELL LOCATION MAP  
FILE NO. MON-295-A

+ Denotes location of well on United States Topographic Maps scale 1 to 62,500, latitude and longitude lines being represented by border lines as shown.

- Denotes one inch spaces on border line of original tracing.