

New Location
 Drill Deeper
 Abandonment

SEP 26 1944
 MAP N83E, Sqs. 18N & 28E
 SURFACE OWNED BY: *Wm. Lemley*
 WM. LEMLEY - CORE W. VA.
 MAPLETOWN COAL OWNED BY:
 VICTORIA P. RANDOLPH - RICES LANDING, PA.
 PITTSBURGH COAL OWNED BY:
 DONALD D. SHEPARD - SILVER SPRINGS, MD.

Company SOUTH PENN NATURAL GAS Co.
 Address PARKERSBURG, W. VA.
 Farm A.E. PRICE
 Tract _____ Acres 147 Lease No. 66910
 Well (Farm) No. 5 Serial No. _____
 Elevation (Spirit Level) 926
 Quadrangle BLACKSVILLE
 County MONONGALIA District CLAY
 Engineer EMMON HAINES
 Engineer's Registration No. _____
 File No. _____ Drawing No. _____
 Date 8 24-44 Scale 1" = 400'

STATE OF WEST VIRGINIA
 DEPARTMENT OF MINES
 OIL AND GAS DIVISION
 CHARLESTON


WELL LOCATION MAP
 FILE NO. MON-304-A

+ Denotes location of well on United States Topographic Maps, scale 1 to 62,500, latitude and longitude lines being represented by border lines as shown.
 - Denotes one inch spaces on border line of original tracing.



STATE OF WEST VIRGINIA
DEPARTMENT OF MINES
OIL AND GAS DIVISION

WELL RECORD

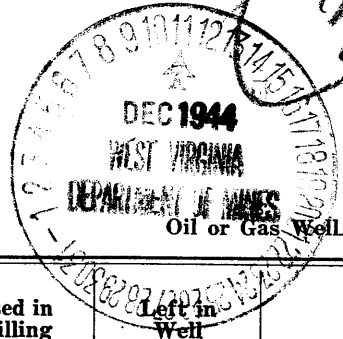

367

Permit No. 304-A

OIL
(KIND)

Company South Penn Natural Gas Company
Address Union Trust Bldg. Parkersburg, W. Va.
Farm A. E. Price Acres 147
Location (waters) Dunkard Creek
Well No. 5 Elev. 926.
District Clay County Monongalia
The surface of tract is owned in fee by Wm. Lemley
Address Cora, W. Va.
Mineral rights are owned by A. Brown Price et al
Address Core, W. Va.
Drilling commenced Oct. 25, 1920
Drilling completed Jan. 28, 1921
Date Shot 2-1-21 -- 20 Qts.
Date Shot 8-30-37 -- 20 Qts. T 2882-2892
With --

Casing and Tubing	Used in Drilling	Left in Well	Packers
Size			Kind of Packer
16			-
13	63'	63'	-
10	484' (Pulled)		Size of
8 3/4	1449' (Pulled)		-
6 5/8	1993		Depth set
5 3/16	2717' 6" 2717' 6"		-
3 4"	2707'		Perf. top
2			-
Liners Used	4 1/2" 4-	177'	Perf. top
			-
			Perf. bottom
			-

Open Flow /10ths Water in --- Inch
/10ths Merc. in --- Inch
Volume --- Cu. Ft.
Rock Pressure --- lbs. --- hrs.
Oil 5 bbls., 1st 24 hrs.
Fresh water --- feet --- feet
Salt water 1240 feet --- feet

CASING CEMENTED - SIZE - No. Ft. - Date -
COAL WAS ENCOUNTERED AT 475 FEET 72 INCHES
- FEET - INCHES --- FEET - INCHES
- FEET - INCHES - FEET - INCHES

Formation	Color	Hard or Soft	Top	Bottom	Oil, Gas or Water	Depth Found	Remarks
Pittsburgh Coal			475	481			
Murphy Sand			635	775			
Little Dunkard			870	910			
Big Dunkard			990	1060			
Gas Sand			1100	1160			
1st Salt Sand			1240	1288			
2nd Salt Sand			1328	1510	Water	1240	
Little Lime			1663	1675			
Pencil Cave			1675	1685			
Big Lime			1685	1745			
Big Injun Sand			1745	1940			
Squaw Sand			1970	2000			
Berea Grit			2010	2040			
Fifty Foot Sand			2330	2425			
Thirty Foot Sand			2435	2454			
Gordon Stray			2585	2607			
Gordon Sand			2680	2702			
Fourth Sand			2733	2743			
Fifth Sand			2879	2896			
					Oil	2882	
				2902			
Total Depth							



JUN 15 1915

