

Surface belongs to M.C. Spragg, RFD #2, Fairview, Marion Co., W.Va.

Pittsburgh Coal belongs to Davis Coal & Coke Co., Baltimore, Maryland.

AUG - 6 1945

- New Location
- Drill Deeper
- Abandonment

Company Rad Supply Co.
 Address Salem, W.Va.
 Farm Lucinda Wilson
 Tract Acres 62 5/8 Lease No. _____
 Well (Farm) No. 3 Serial No. _____
 Elevation (Spirit Level) 1560.55, Ground _____
 Quadrangle Blacksville
 County Monongalia District CLAY
 Engineer E.C. Tabler
 Engineer's Registration No. _____
 File No. _____ Drawing No. _____
 Date May 24th 1945 Scale 1" = 400'

STATE OF WEST VIRGINIA
DEPARTMENT OF MINES
OIL AND GAS DIVISION
CHARLESTON

WELL LOCATION MAP
FILE NO. MON-315-A

+ Denotes location of well on United States Topographic Maps, scale 1 to 62,500, latitude and longitude lines being represented by border lines as shown.

- Denotes one inch spaces on border line of original tracing.

LUCINDA WILSON NO. 3 WELL.

Clay District, Monongalia County, W. Va.
 By Road Supply Co., 184 E. Main St., Salem, W. Va.
 Abandoned under permit Mon-.....-A?
 On.....acres.

Elevation,⁺ L.
 Surface owned by M. C. Spragg, Fairview, W. Va., R. F. D. No. 2.
 Shot May 23, 1917.

13" casing, 252' 100' left in); 12", 1592' (pulled); 8 1/2", 2180';
 6", 2500'; 5", 2568'; 4 1/2" liner, 280'.

Casing not cemented.

Coal was encountered at 1144-1149 and 1245-1255'.

Gas well. Abandonment reported to Dept. of Mines (stamped May 29,
 1945 and June 25, 1945). Originally an oil well.

Record to RCF from Mrs. Griffith June 27, 1945. Old File No. 366.

	Top.	Bottom.
Conductor	0	14
Mapletown (Sevickley) Coal	1144	1149
Pittsburgh Coal	1245	1255
Big Darkard Sand	1755	1810
Salt Sand	2140	2255
Little Lime	2460	2472
Pencil Cave	2472	2475
Big Lime	2475	2520
Big Injun Sand (gas, light, 2531-2534') (1st pay, 2625-2635')	2520
Total depth		2650
DRILLED DEEPER:		
Started to drill deeper		2650
Bottom of Big Injun Sand	2723
Squaw Sand	2730	2840
Berea Grit	2995	3025
Ganta Sand	3120	3140
Fifty-foot Sand	3158	3205
Thirty-foot Sand	3212	3216
Gordon Stray Sand	3427	3457
Gordon Sand (4 1/2" liner, 3463') (gas, 3475-3480')	3462	3505
Fourth Sand (gas, 3509-3512') (gas, 3515')	3508	3528
Total depth		3529

STATE OF WEST VIRGINIA
DEPARTMENT OF MINES
OIL AND GAS DIVISION

366

WELL RECORD

Permit No. **M. O. 315A**

Oil or Gas Well
(Kind)

Company **Raad Supply Company**
Address **184 East Main St., Salem, W. Va.**
Farm **Lucinda Wilson** Acres.....
Location (waters).....
Well No. **3** Elev.....
District **Clay** County **Monongalia**
The surface of tract is owned in fee by **M.C. Spragg**
Fairview, W.V. a.RFD#2 Address.....

Mineral rights are owned by.....
Address.....

Drilling commenced.....
Drilling completed.....

Date shot **May 23, 1917** Depth of shot.....

Open Flow /10ths Water in..... Inch
/10ths Merc. in..... Inch

Volume..... Cu. Ft.

Rock Pressure..... lbs..... hrs.

Oil..... bbls., 1st 24 hrs.

Fresh water..... feet.....

Salt water..... feet.....

Casing and Tubing	Used in Drilling	Left in Well	Packers
Size			Kind of Packer.....
16			
13	252'	100'	PARALLEL XXXXX
10	1592'	1592'	Size of 3 1/2 x 1 1/2
8 1/4	2180'	2180'	PACKER 2 1/2 x 1 1/2
6 5/8	2500'	2500'	Depth set.....
5 3/16	2668'	2668'	PACKER 2 1/2 x 1 1/2
3			Perf. top.....
2			Perf. bottom.....
Liners Used	280'	280'	Perf. top.....
4 1/2 x 4"			Perf. bottom.....



CASING CEMENTED **No** SIZE..... No. Ft..... Date.....

COAL WAS ENCOUNTERED AT **1149'** FEET **60** INCHES

1255 FEET **120** INCHES FEET INCHES

FEET INCHES FEET INCHES

Formation	Color	Hard or Soft	Top	Bottom	Oil, Gas or Water	Depth Found	Remarks
Conductor				14'			
Mapletown Coal			1144'	1149'			
Pittsburgh Coal			1245'	1255'			
Big Dunkard			1755'	1810'			
Salt Sand			2140'	2255'			
Little Lime			2460'	2472'			
Pencil Cave			2472'	2475'			
Big Lime			2475'	2520'			
Big Injun			2520'				
Gas light			2531'	2534'			
1st. Pay			2625'	2635'			
Total Depth				2650'			
Started to D. D.				2650'			
Bottom Big Injun Sand				2728'			
Squaw Sand			2730'	2840'			
Berea Grit			2995'	3025'			
Gantz Sand			3120'	3140'			
Fifty Foot Sand			3158'	3205'			
Thirty Foot Sand			3212'	3216'			
Gordon Stray			3427'	3457'			
Gordon Sand			3462'	3505'			
4 1/2" x 4" Liner				3463'			
Gas			3475'	3480'			
Fourth Sand			3508'	3528'			
Gas			3509'	3512'			
Gas			3515'				
Total Depth				3529'			

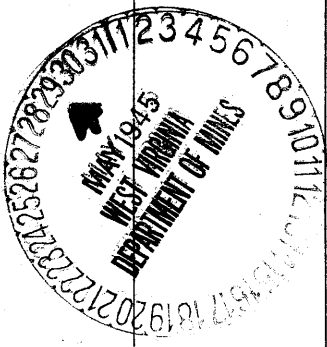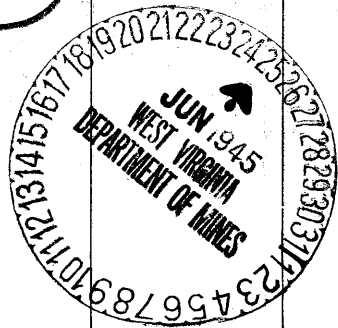

JUN 27 1945