



LATITUDE 39°40'00"

80°17'30"

LONGITUDE

75'

7.5 OGIS topo location

7.5' loc	<u>1.055</u>	15' loc	<u>1.055</u>
	<u>0.640</u>	(calc.)	<u>2.146 W</u>

Company \_\_\_\_\_

Farm \_\_\_\_\_

Quad Wadestown (Maunington Ec)

County Monongahela

District Battelle

WELL LOCATION MAP

File No. 061-323A



STATE OF WEST VIRGINIA  
DEPARTMENT OF MINES  
OIL AND GAS DIVISION

371

Permit No. MON-323-A

WELL RECORD

Oil or Gas Well \_\_\_\_\_  
(KIND)


Company Raad Supply Company  
Address 184 E. Main St., Salem, W. Va.  
Farm A. J. Carrothers Acres 398 3/4  
Location (waters) \_\_\_\_\_  
Well No. 8 Elev. 1240.54  
District Battelle District Monongalia  
The surface of tract is owned in fee by Mrs. H. Glenn  
Cross Address 713 E. Lincoln Way  
Lisbon, Ohio  
Mineral rights are owned by The Davis Coal & Coke Co  
810 Keyser Bldg. Address Baltimore 2, Md.  
Drilling commenced \_\_\_\_\_  
Drilling completed \_\_\_\_\_  
Date Shot 4/13/19 ~~From~~ 10 Qts.  
With 4/17/30 - 20 qts.  
Open Flow /10ths Water in \_\_\_\_\_ Inch  
/10ths Merc. in \_\_\_\_\_ Inch  
Volume \_\_\_\_\_ Cu. Ft.  
Rock Pressure \_\_\_\_\_ lbs. \_\_\_\_\_ hrs.  
Oil \_\_\_\_\_ bbls., 1st 24 hrs.  
Fresh water \_\_\_\_\_ feet \_\_\_\_\_ feet  
Salt water \_\_\_\_\_ feet \_\_\_\_\_ feet

Casing and Tubing	Used in Drilling	Left in Well	Packers
Size			
16			Kind of Packer
13			
10	<u>442'11"</u>	<u>None</u>	Size of
8 1/4	<u>1489'3"</u>	<u>None</u>	
6 5/8	<u>2444'5"</u>	<u>2444'5"</u>	Depth set
5 3/16	<u>2920'9"</u>	<u>2920'9"</u>	
3			Perf. top
2			Perf. bottom
Liners Used			Perf. top
<u>4" x 4 1/2"</u>	<u>250'7"</u>	<u>250'7"</u>	Perf. bottom

CASING CEMENTED No SIZE \_\_\_\_\_ No. Ft. \_\_\_\_\_ Date \_\_\_\_\_

COAL WAS ENCOUNTERED AT 982 FEET 84 INCHES  
605 FEET 60 INCHES FEET INCHES  
FEET INCHES FEET INCHES

Formation	Color	Hard or Soft	Top	Bottom	Oil, Gas or Water	Depth Found	Remarks
Conductor				<u>14'</u>			
Fairview Coal			<u>600'</u>	<u>605'</u>			
Pittsburgh Coal			<u>975</u>	<u>982</u>			
Little Dunkard			<u>1290</u>	<u>1338</u>			
Big Dunkard			<u>1455</u>	<u>1530</u>			
Salt Sand			<u>1850</u>	<u>1935</u>			
Little Lime			<u>2170</u>	<u>2178</u>			
Pencil Cave			<u>2178</u>	<u>2190</u>			
Big Lime			<u>2190</u>	<u>2275</u>			
Big Injun			<u>2275</u>	<u>2425</u>			
Squaw Sand			<u>2435</u>	<u>2460</u>			
Gantz Sand			<u>2775</u>	<u>2795</u>			
Fifty Foot Sand			<u>2880</u>	<u>2944</u>			
Thirty Foot Sand			<u>2991</u>	<u>3031</u>			
Stray Sand			<u>3160</u>	<u>3177</u>			
Gordon Sand			<u>3189</u>				
1st. Pay			<u>3202</u>	<u>3204</u>			
Total Depth				<u>3210</u>			

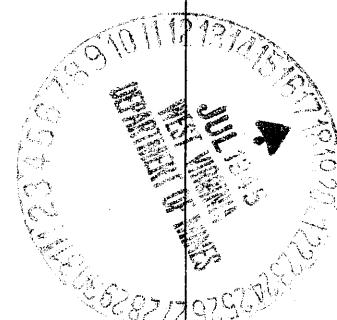

(Over)

SEP 19 1945



Battle District, Monongalia County, W. Va.  
 By Road Supply Co., 184 E. Main St., Salem, W. Va.  
 Abandoned under permit Mon-.....A.  
 On 396 acres.

Elevation, 1280.54' L.

Surface owned by Mrs. H. Olem Cross, 713 E. Lincoln Way, Lisbon, Ohio,  
 and minerals by The Davis Coal & Coke Co., 820 Keyser Bldg.,  
 Baltimore, 2, Md.

Shot April 13, 1919, with 10 qts., and April 17, 1930, with 20 qts.  
 10" casing, 442' 11" (pulled); 8", 1489' 3" (pulled); 6", 2444' 5";  
 5", 2920' 9"; liner, 4 x 4", 250' 7".

Coal was encountered at 600-605 and 975-982'.

Oil well. Abandonment reported to Dept. of Mines July 16, 1945.

Record to NCF from Mrs. Griffith Sept. 18, 1945. Old File No. 371.

	Top.	Bottom.
Conductor	0	1 1/2
Fairview (Waynesburg) Coal	600	605
Pittsburgh Coal	975	982
Little Dunkard Sand	1330	1338
Big Dunkard Sand	1455	1530
Salt Sand	1650	1905
Little Line	2170	2178
Pencil Cave	2178	2190
Big Line	2190	2275
Big Injun Sand	2275	2435
Sugar Sand	2435	2460
Gantz Sand	2775	2795
Fifty-foot Sand	2880	2944
Thirty-foot Sand	2991	3031
Stray Sand	3160	3177
Gordon Sand (1st pay, 302-304')	3189	.....
Total depth		3210

