


Latitude 39 45'

Longitude 80 15'

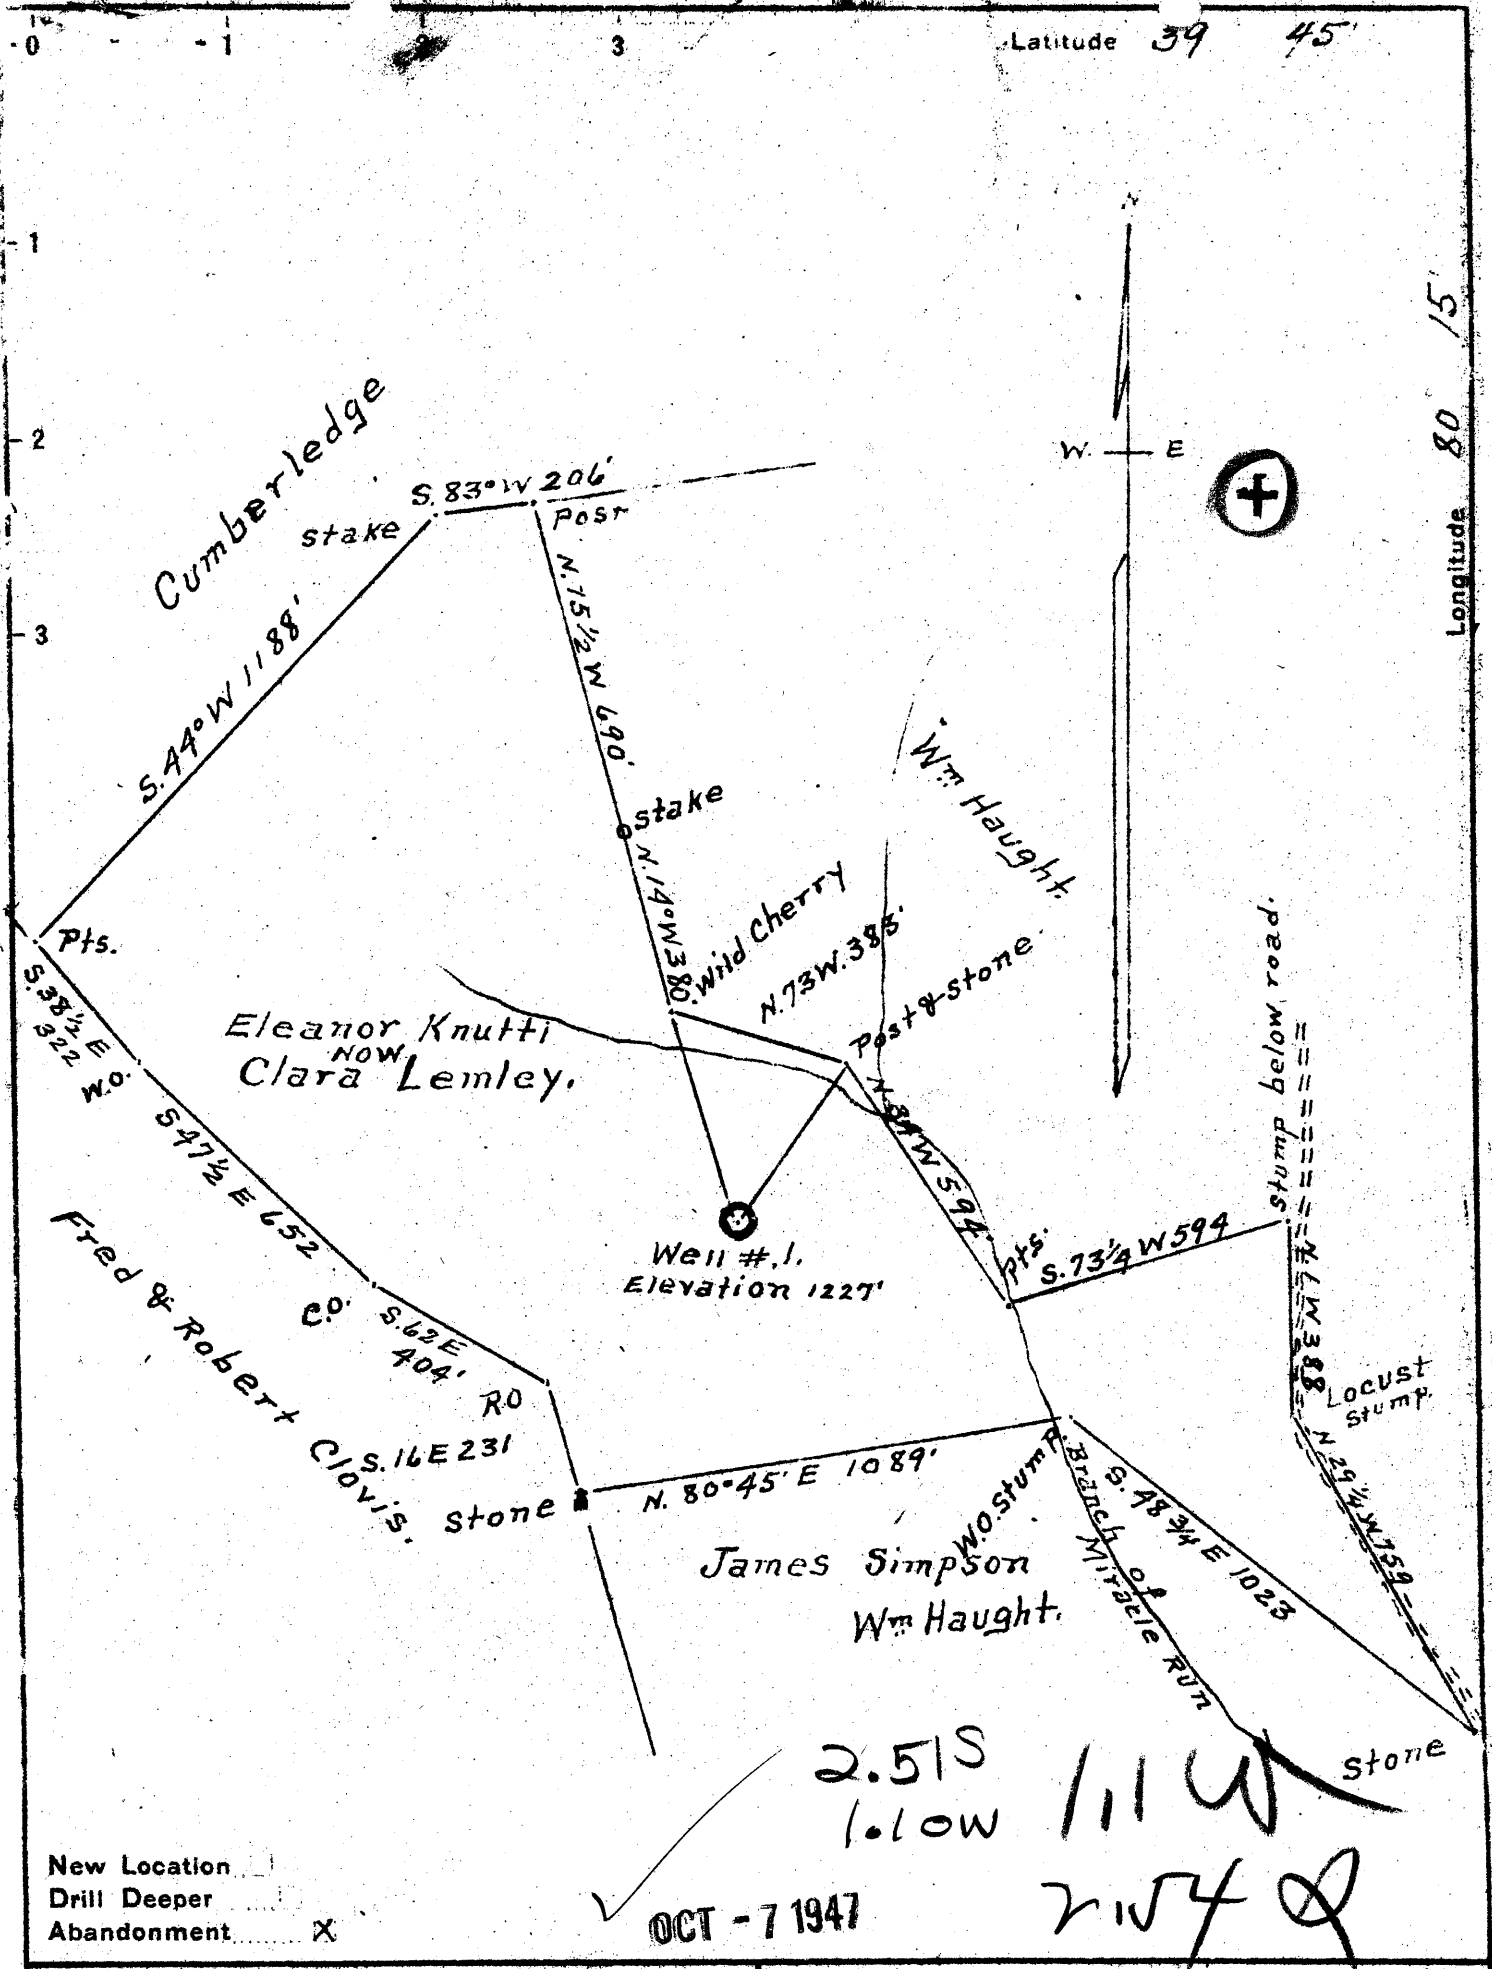

New Location
 Drill Deeper
 Abandonment

OCT - 7 1947

2.51 S
 1.01 OW 111 W
 2154 Q

Company A. M. Snider
 Address Hundred W. Va.
 Farm Eleanor Knutti
 Tract 1 Acres 59 3/4 Lease No. _____
 Well (Farm) No. ONE Serial No. _____
 Elevation (Spirit Level) 1227'
 Quadrangle Mannington
 County Monongalia District Battle
 Engineer A. L. Headley
 Engineer's Registration No. _____
 File No. _____ Drawing No. _____
 Date 8-30-1947

(NE)

STATE OF WEST VIRGINIA
 DEPARTMENT OF MINES
 OIL AND GAS DIVISION
 CHARLESTON

WELL LOCATION MAP
 FILE NO. MON-341-A

+ Denotes location of well on United States Topographic Maps, scale 1 to 62,500, latitude and longitude lines being represented by border lines as shown.
 - Denotes one inch spaces on border line of original tracing.

2000



STATE OF WEST VIRGINIA
DEPARTMENT OF MINES
OIL AND GAS DIVISION

1851
990
911
397

AD 341-A

WELL RECORD

Permit No. _____ Oil or Gas Well _____ (KIND)


Company A. M. Snider
 Address Hundred, W.Va.
 Farm Eleanor Knutti Acres 54 3/4
 Location (waters) _____
 Well No. 1 Elev. 1227
 District Battelle County Monongalia
 The surface of tract is owned in fee by _____
 Address _____
 Mineral rights are owned by _____
 Address _____
 Drilling commenced _____
 Drilling completed _____
 Date Shot _____ From _____ To _____
 With _____
 Open Flow _____ /10ths Water in _____ Inch
 _____ /10ths Merc. in _____ Inch
 Volume _____ Cu. Ft.
 Rock Pressure _____ lbs. _____ hrs.
 Oil _____ bbls., 1st 24 hrs.
 Fresh water _____ feet _____ feet
 Salt water _____ feet _____ feet

Casing and Tubing	Used in Drilling	Left in Well	Packers
Size			Kind of Packer
16			
13			
10			Size of
8 1/4	1748	1748	
6 5/8	2162	2162	Depth set
5 3/16			
3			Perf. top
2	2235	2235	Perf. bottom
Liners Used			Perf. top
			Perf. bottom

CASING CEMENTED _____ SIZE _____ No. Ft. _____ Date _____
 COAL WAS ENCOUNTERED AT _____ FEET _____ INCHES
 _____ FEET _____ INCHES FEET _____ INCHES
 _____ FEET _____ INCHES FEET _____ INCHES

Formation	Color	Hard or Soft	Top	Bottom	Oil, Gas or Water	Depth Found	Remarks
Pittsburgh Coal	<i>salt sand</i>	<i>7897 to 1917</i>	927	936			
Big Injun			2199	2452	Oil	2227 to 2235	
Fifty Foot			2874	2929			
Gordon			3185	3220	Gas	3197	
					Oil	3199	
Fourth Sand			3278	3298			
Fifth Sand			3342	3354	Gas	3345	
Total Depth		3390'					

Several years ago this well was plugged to 2235' from where it has been producing oil .

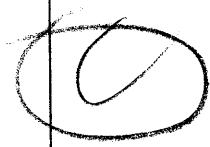

Formation	Color	Hard or Soft	Top	Bottom	Oil, Gas or Water	Depth Found	Remarks



3000
 605 2000
 180
 200
 180
 180
 180

Date _____, 19____

APPROVED _____, Owner

By _____

(Title)