

HATTIE HERRINGTON



POST
(20' N-OF WILD CHERRY)
(STONE-WORK)

S1°30'W
1250'

LEWIS LIMING

E. L. BRAND

N4°45'E - 2392.5'

N8°30'W
1222'

STONE

WEST
1034.5'

HICKORY

STONE (STAKE)

DONLEY McCORMIC

2.88S
2.10W

3.12 W

2.91 S

MAY 16 1948

New Location
Drill Deeper
Abandonment

Company FRANK S. ULLOM

Address WAYNESBURG, PA.

Farm HARRY BOWLBY

Tract _____ Acres 77 Lease No. 573

Well (Farm) No. 1 Serial No. 571

Elevation (Spirit Level) 1324.97

Quadrangle BLACKSVILLE - N-E

County MONONGALIA District CASS

Engineer B. B. COUK

Engineer's Registration No. 4274-PA.

File No. _____ Drawing No. _____

Date 4-13-43 Scale 1" = 800'

STATE OF WEST VIRGINIA
DEPARTMENT OF MINES
OIL AND GAS DIVISION
CHARLESTON

WELL LOCATION MAP
FILE NO. MON-356-A

+ Denotes location of well on United States Topographic Maps, scale 1 to 62,500, latitude and longitude lines being represented by border lines as shown.

- Denotes one inch spaces on border line of original tracing



421

STATE OF WEST VIRGINIA
DEPARTMENT OF MINES
OIL AND GAS DIVISION

WELL RECORD

Permit No. 356 A

Oil or Gas Well Gas


Company Frank S. Ullom
Address Waynesburg, Pa
Farm Harry Bowlby Acres 77
Location (waters) Wades Run
Well No. One (1) Elev. 1324.97
District Cass County Monongalia
The surface of tract is owned in fee by Grace D. Linger
Brand Address Morgantown, W. Va.
Mineral rights are owned by _____
Address _____
Drilling commenced Approximately 1915
Drilling completed " "
Date Shot No Record From _____ To _____
With _____
Open Flow _____ /10ths Water in No Record Inch
_____ /10ths Merc. in _____ Inch
Volume No Record Cu. Ft.
Rock Pressure No Record lbs. _____ hrs.
Oil None bbls., 1st 24 hrs.
Fresh water 760 feet _____ feet
Salt water 1210 feet 1405 & 1425 feet

Casing and Tubing	Used in Drilling	Left in Well	Packers
Size			
16			Kind of Packer
13			
10	518	None	Size of
8 1/4	1252	"	
6 1/2	1554	"	Depth set
5 3/16	1805	1805	
3			Perf. top
2			Perf. bottom
Liners Used			Perf. top
			Perf. bottom

CASING CEMENTED _____ SIZE _____ No. Ft. _____ Date _____

COAL WAS ENCOUNTERED AT 410 FEET 60 INCHES
510 FEET 60 INCHES FEET INCHES
FEET INCHES FEET INCHES

Formation	Color	Hard or Soft	Top	Bottom	Oil, Gas or Water	Depth Found	Remarks
Mapletown Coal			410	415			
Pittsburgh Coal			510	515			
Murphy Sand			650	770	Water	760	
Little Dunkard			980	1040			
Big Dunkard			1090	1170			
1st Gas Sand			1200	1235	Gas	1205	
1st Salt Sand			1500	1410	Water	1210	
2nd Salt Sand			1415	1430	"	1405	
3rd Salt Sand			1435	1480	"	1425	
4th Salt Sand			1525	1570	"	1460	
Maxon Sand			1590	1610			
Little Line			1715	1730			
Pencil Cave			1730	1740			
Big Injun			1740	1795	Gas	1815	
Total Depth				1981			

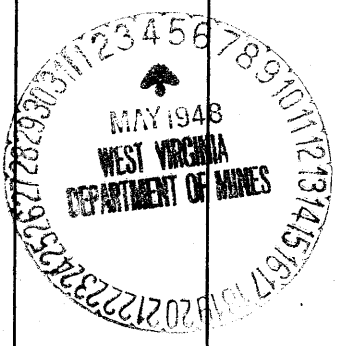

(Over)

OCT 11 1948