

Elevations:

- 3 Annie Harvey { Floor - 1229.07
Ground - 1228.07
- 4 Annie Harvey { 1222.15
1220.65
- 2 Annie Harvey { 1253.66
1251.16

Surface: Ed Barr; R.F.D. Fairview, Marion Co. W.Va.
 Coal: Wheeling Dollar Savings & Trust Co.; Wheeling W.Va.

- New Location
- Drill Deeper
- Abandonment

On 400' map # 2459

3.34S
 2.26W
 JUN 15 1948
 N 12 E 18-19

Company	Evaluation & Sales Service
Address	Mount Pleasant Michigan.
Farm	Annie Harvey
Tract	Acres 138.65 Lease No.
Well (Farm) No.	2, 3 & 4 Serial No.
Elevation (Spirit Level)	See above in North East Corner
Quadrangle	Mannington
County	Monongalia District Battelle
Engineer	E.C. Tabler
Engineer's Registration No.	
File No.	Drawing No.
Date	March 30 th 1948 Scale 1" = 800 Feet.

STATE OF WEST VIRGINIA
 DEPARTMENT OF MINES
 OIL AND GAS DIVISION
 CHARLESTON

WELL LOCATION MAP
 FILE NO. MON-359-A-#3
~~MON-362-A-#2~~
 ✓ MON-363-A-#4

+ Denotes location of well on United States Topographic Maps, scale 1 to 62,500, latitude and longitude lines being represented by border lines as shown.

- Denotes one inch spaces on border line of original tracing.



STATE OF WEST VIRGINIA
DEPARTMENT OF MINES
OIL AND GAS DIVISION

739


WELL RECORD

Permit No. 77A Oil or Gas Well Oil (KIND)

Company C. W. Collin
 Address P. O. Box 10, Mt. Pleasant, Mich.
 Farm Anna Harvey Acres 140
 Location (waters) _____
 Well No. 1 Floor - 1229.076
 District Battelle County McMingo Elev. 1228.07
 The surface of tract is owned in fee by Ed. Beer 10' 300' Pulled
 Address RFD, Fairview, W. Va. 1 1/2" 1420'
 Mineral rights are owned by Wheeling Dollar Savings & Trust Co. 6% 2135'
 Address Wheeling, W. Va. 5 3/16" 2135'
 Drilling commenced _____ 3"
 Drilling completed June 24, 1905 2"
 Date Shot 1899 From _____ To _____
 With 3 Qts. Liners Used 6" x 4" 1 1/2"
 Open Flow _____ /10ths Water in _____ Inch
 _____ /10ths Merc. in _____ Inch
 Volume _____ Cu. Ft.
 Rock Pressure _____ lbs. _____ hrs.
 Oil 4th sand -- 40 bbls. bbls., 1st 24 hrs.
 Fresh water _____ feet _____ feet
 Salt water _____ feet _____ feet

CASING CEMENTED	SIZE	No. Ft.	Date
COAL WAS ENCOUNTERED AT <u>920</u> FEET INCHES			

Formation	Color	Hard or Soft	Top	Bottom	Oil, Gas or Water	Depth Found	Remarks
Pgh. Coal			920				
Big Injun			2225	2370			
Fifty Feet			2785	2830			
Stray Sand			3085	3125			
Gordon			3130				
1st Pay			3133				
Total Depth				3152			
Drilled deeper to 4th Sand							
Gordon Comp.			3130	3151			
1st pay			3133				
Fourth			3159				
1st pay			3166				
Total Depth				3181			

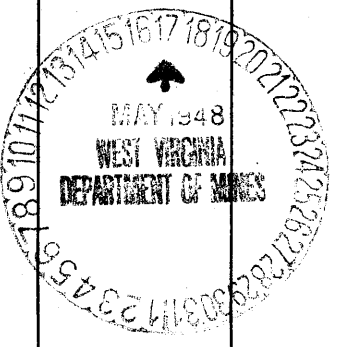

JUL 23 1943

75+
70222

LATITUDE

39°37'30"

11°00'51.00"

LONGITUDE

7'5 OGIS topo location

7.5' loc	<u>0.055</u>	15' loc	<u>2.935</u>
	<u>2.11 W</u>	(calc.)	<u>2.11 W</u>

115 in 1912 Co Rst

Company _____

Farm _____

Quad Mannington EC

County Monongalia

District Battelle

WELL LOCATION MAP

File No. 061-70222

Battelle District, Monongalia County, W. Va.
By South Penn Oil Co.
On Flat Run.
Completed in 1895.
Elevation, 1235' B.

	Top.	Bottom.
Pittsburgh Coal	920	
Big Injun Sand (show oil and light gas)	2225	- 2370
50-Ft. Sand (light gas)	2785	- 2830
Stray Sand	3085	- 3125
Gorden Sand (1st pay, 3133')	3130	
Total depth		3152