


Latitude 39° 45'

Longitude 80° 15'

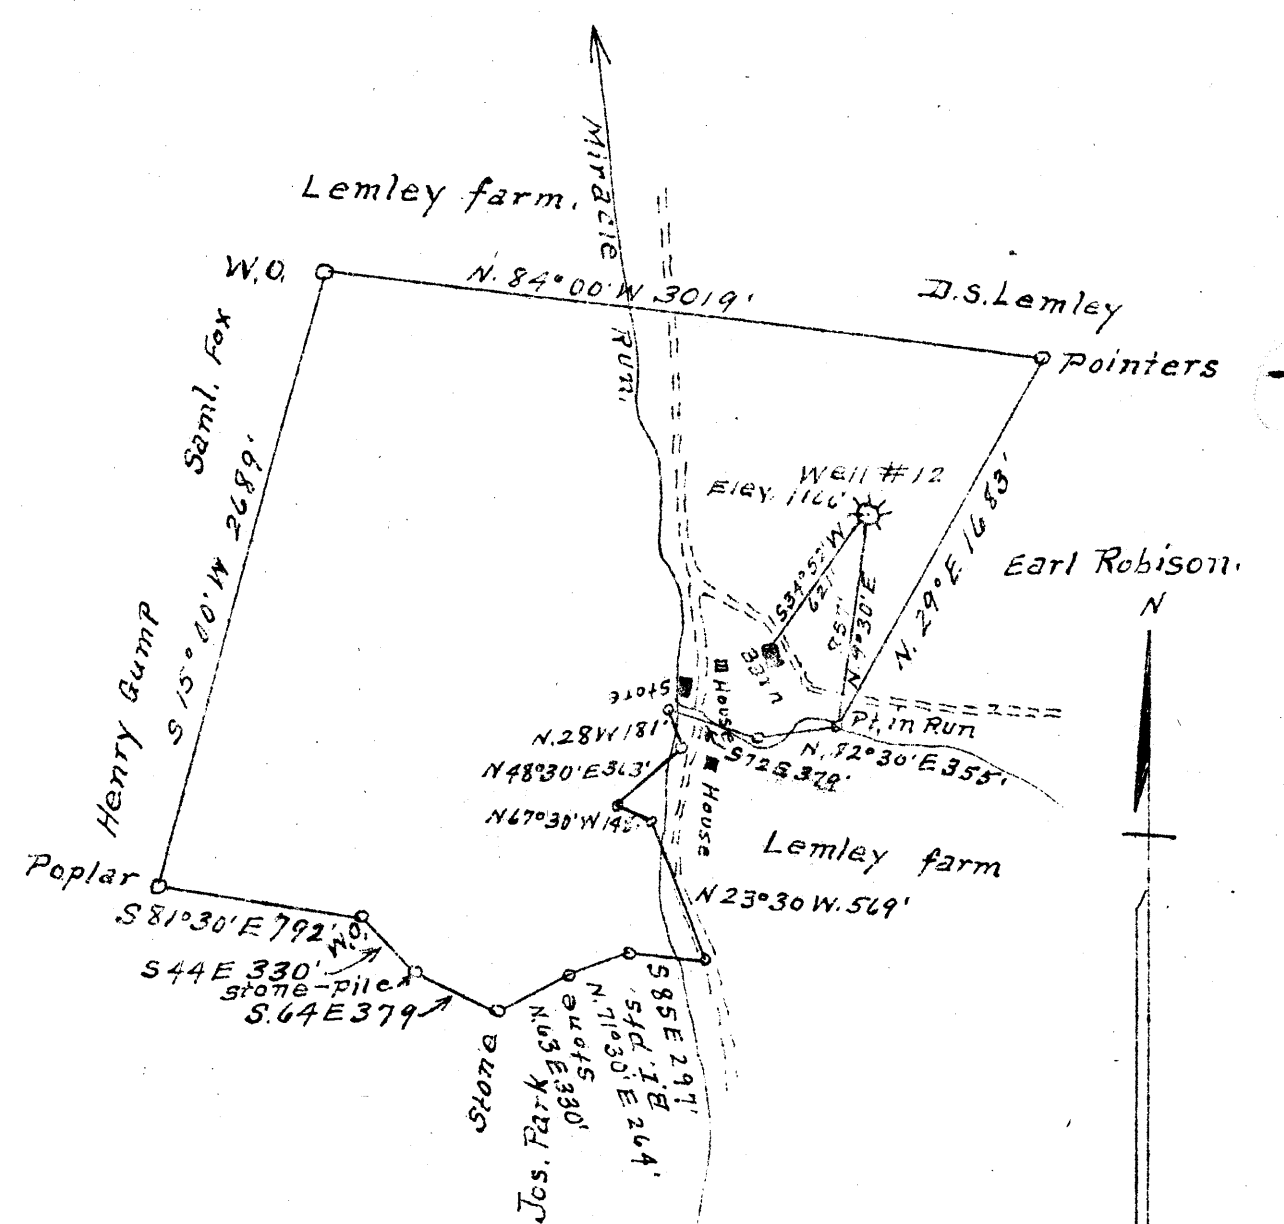

Surface - Leroy Lemley R.#.1, Fairview W.Va.
 Coal - Wheeling Dollar Savings & Trust Co.
 Trustee, P.&L.E.R.R. Wheeling, W.Va.

4.06S
 0.43W

New Location
 Drill Deeper
 Abandonment

JUN 22 1948

Company A. M. Snider
 Address Hundred, W.Va.
 Farm Rebecca Lemley
 Tract 1 Acres 146 Lease No. 27164
 Well (Farm) No. 5 Serial No. _____
 Elevation (Spirit Level) 1166'
 Quadrangle Mannington
 County Monongalia District Battelle
 Engineer A. E. Headley
 Engineer's Registration No. _____
 File No. _____ Drawing No. _____
 Date 5-25-1948 Scale 1" = 800'

STATE OF WEST VIRGINIA
 DEPARTMENT OF MINES
 OIL AND GAS DIVISION
 CHARLESTON

WELL LOCATION MAP
 FILE NO. MON-370-A

+ Denotes location of well on United States Topographic Maps, scale 1 to 62,500, latitude and longitude lines being represented by border lines as shown.
 - Denotes one inch spaces on border line of original tracing.



401

STATE OF WEST VIRGINIA
DEPARTMENT OF MINES
OIL AND GAS DIVISION

WELL RECORD

Permit No. 31 A


Oil or Gas Well _____
(KIND)

Company A. M. Snider
 Address Hundred, West Virginia
 Farm Rebecca Lemley Acres 146
 Location (waters) Miracle Run
 Well No. 5 Elev. 1166
 District Battelle County Monongalia
 The surface of tract is owned in fee by Leroy Lemley
Fairview Address W. Va.
 Mineral rights are owned by Wheeling Dollar Savings
& Trust Co. Address Wheeling, W. Va.
 Drilling commenced 1917
 Drilling completed Jan., 10, 1918
 Date Shotted May 17, 1918 From Top 2224 To _____
 With 16 Qts.
 Open Flow _____ /10ths Water in _____ Inch
 _____ /10ths Merc. in _____ Inch
 Volume _____ Cu. Ft.
 Rock Pressure NO Record lbs. _____ hrs.
 Oil No Record bbls., 1st 24 hrs.
 Fresh water _____ feet _____ feet
 Salt water _____ feet _____ feet

Casing and Tubing	Used in Drilling	Left in Well	Packers
Size			Kind of Packer
16			
13	257	Pulled	
10	1169	Pulled	Size of
8 1/4	1854	1854	
6 3/4	2112	2112	Depth set
5 3/16	2113	2113	
3			Perf. top
2			Perf. bottom
Liners Used			Perf. top
			Perf. bottom

CASING CEMENTED _____ SIZE _____ No. Ft. _____ Date _____
 COAL WAS ENCOUNTERED AT 505 FEET 60 INCHES
856 FEET 86 INCHES FEET INCHES
 FEET INCHES FEET INCHES

Formation	Color	Hard or Soft	Top	Bottom	Oil, Gas or Water	Depth Found	Remarks
Fairview Coal			505	510			
Pittsburgh Coal			856	864			
Little Dunkard Sand			1228	1258			
Big Dunkard Sand			1360	1419			
1st Salt Sand			1660	1710			
2nd Salt Sand			1775	1785			
Little Lime			2068	2074	Water	1814	
Big Lime			2080	2149	"	1843	
Big Injun			2149		Oil	2244-2235	
					Water	2244-2235	
Total Depth				2252			

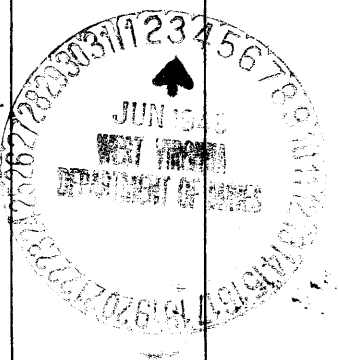

237948