


Latitude 39° 45'

Longitude 80° 15'

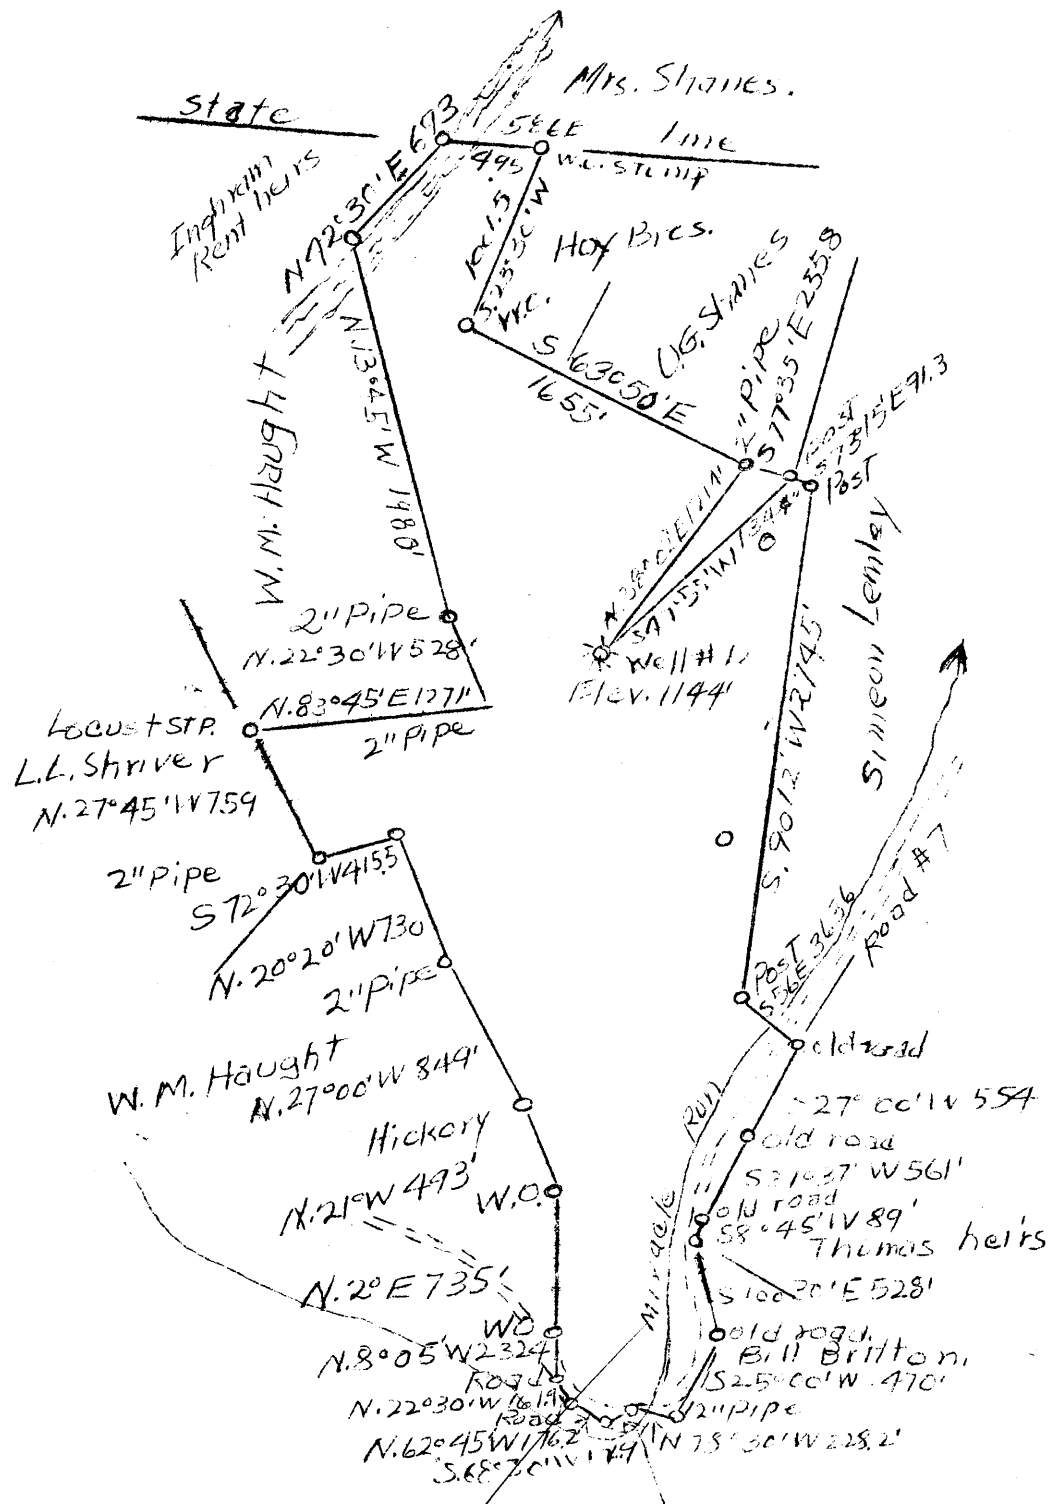

2.26S
0.55W

Surface = Ralph Sanders; Westtown, W. Va.
 Coal - Mary Lemasters, Fairmont W. Va.
 Martha E. Taylor, Morgantown, W. Va.
 412 Grand St.

Abandonment

JUN 22 1948

COMPANY A. M. SNIDER
 ADDRESS HUNDRED, W. VA.
 FARM ACCHA EDDY
 TRACT 1 ACRES 207 LEASE NO. 27827
 WELL FARM NO. 12 SERIAL NO.
 ELEVATION (S.L.) 1144'
 QUADRANGLE MANNINGTON
 COUNTY MONONGALIA DIST. BATTELLE
 ENGINEER A. L. HEADLEY
 ENGINEER'S REG. NO.
 FILE NO. DWG. NO.
 DATE 5/24/48 SCALE 1"=1000'

STATE OF WEST VIRGINIA
 DEPARTMENT OF MINES
 OIL AND GAS DIVISION
 CHARLESTON

WELL LOCATION MAP
 FILE NO. MON 373A

T DENOTES LOCATION OF WELL ON U.S. TOPOGRAPHIC MAPS, SCALE 1 TO 62,500 LATITUDE AND LONGITUDE LINES BEING REPRESENTED BY BORDER LINES AS SHOWN
 - DENOTES ONE INCH SPACES ON BORDER LINE OF ORIGINAL TRACING.



413

STATE OF WEST VIRGINIA
DEPARTMENT OF MINES
OIL AND GAS DIVISION

WELL RECORD

Permit No. 373-A

Oil or Gas Well _____
(KIND)

Company A. M. Snider
 Address Hundred, West Virginia
 Farm Acoba Eddy Acres 207
 Location (waters) Miracle Run
 Well No. 12 Elev. 1144
 District Battelle County Monongalia
 The surface of tract is owned in fee by Ralph Sanders
Wadestown Address W. Va.
 Mineral rights are owned Mary Lemasters-Fairmont
Martha Taylor-Morgantown W. Va.
 Drilling commenced 1901
 Drilling completed Aug., 17, 1901
 Date Shot 1901 From 3106 To 3104
 With 20 Qts.
 Open Flow /10ths Water in _____ Inch
 /10ths Merc. in _____ Inch
 Volume _____ Cu. Ft.
 Rock Pressure _____ lbs. _____ hrs.
 Oil 35 bbls., 1st 24 hrs.
 Fresh water _____ feet _____ feet
 Salt water _____ feet _____ feet

Casing and Tubing	Used in Drilling	Left in Well	Packers
Size			
16			Kind of Packer
13	148	Pulled	
10	1265	688	Size of
8 1/4	1745	Pulled	
6 5/8	1879	1879	Depth set
5 3/16	2280	2280	
3			Perf. top
2			Perf. bottom
Liners Used			Perf. top
4 1/2 x 4	292	292	Perf. bottom

CASING CEMENTED _____ SIZE _____ No. Ft. _____ Date _____

COAL WAS ENCOUNTERED AT 834 FEET ? INCHES
 _____ FEET _____ INCHES FEET _____ INCHES
 _____ FEET _____ INCHES FEET _____ INCHES

Formation	Color	Hard or Soft	Top	Bottom	Oil, Gas or Water	Depth Found	Remarks
Pittsburgh Coal			834				
Big Injun Sand			2096	2341			
Fifty Foot			2750	2795			
C. Run Sand			3074	3089	Oil	3104	
Gordon Sand			3095		"	3108	
Total Depth				3128			

