

New Location
 Drill Stump
 Abandonment

MAP SA 2 N18 E 24 P 8 24 HP 92-24

Company Hops Natural Gas Gas Co
 Address Clarksburg WV
 Farm H.G. Denley
 Tract _____ Acres 40 Lease No. 61217
 Well (Farm) No. _____ Serial No. 9618
 Elevation (Split Level) 1080'
 Quadrangle Blacksville
 County Monongalia District CASS
 Engineer W.H. Thompson
 Engineer's Registration No. 700

STATE OF WEST VIRGINIA
 DEPARTMENT OF MINES
 OIL AND GAS DIVISION
 CHARLESTON

WELL LOCATION MAP
 FILE NO. MON. 821-A

+ Denotes location of well on United States Topographic Map, scale 1 to 62,500, latitude and longitude lines being represented by border lines as shown.

LATITUDE 39° 45' 00"

11° 00' 00" 08

LONGITUDE

7.5'
+

7.5 OGIS topo location

7.5' loc	<u>2.095</u>	15' loc	<u>2.095</u>
	<u>0.35W</u>	(calc.)	<u>0.35W</u>

Company _____

Farm _____

Quad OSAGE (BU/E NE)

County Monongahela

District Cms

WELL LOCATION MAP

File No. 061-509A

Cass District, Monongalia County, W. Va.
 By Hope Natural Gas Co., 445 W. Main St., Clarksburg, W. Va.
 Abandoned under permit Mon-.....-17

On 40 acres.

Elevation, 1030' L.

Drilling commenced Sept. 30, 1912; completed Nov. 26, 1912.

Salt water at 1120 and 1205'.

10" casing, 315' (pulled); 8 1/2", 1215' (600' left in); 6 3/4", 1354';
 5", 1581'; 2" tubing, 2220'.

Casing not cemented.

Coal was encountered at 135-140 and 240-250'.

Gas well. Record to Dept. of Mines dated July 5, 1951.

Record to WGT from Mrs. Griffith Aug. 27, 1951. Old File No. 553.

	Top.	Bottom.
Mapletown (Sewickley) Coal	135	140
Pittsburgh Coal	240	250
Little Dunkard Sand	640	650
Gas Sand	948	972
Salt Sands (water, 1120 and 1205', hole fall)	1105	1300
Big Lime	1516	1581
Big Injun Sand (gas, 1681 and 1696')	1581	1755
Gantz Sand	1790	1893
Fifty-foot Sand (gas, 2168')	2167	2215
Total depth		2220



553

STATE OF WEST VIRGINIA
DEPARTMENT OF MINES
OIL AND GAS DIVISION

WELL RECORD

Permit No. MON-507-A

~~Oil~~ Gas Well (KIND)


Company Hope Natural Gas Company.
 Address 445 West Main St. Clarksburg, W. Va.
 Farm H.G. Donley Acres 40
 Location (waters) _____
 Well No. 9618 N.P. 310 Elev. 1000
 District Cass County Monongalia.
 The surface of tract is owned in fee by _____
 Address _____
 Mineral rights are owned by _____
 Address _____
 Drilling commenced Sept. 30, 1912
 Drilling completed Nov. 26, 1912
 Date Shot _____ From _____ To _____
 With _____
 Open Flow _____ /10ths Water in _____ Inch
 _____ /10ths Merc. in _____ Inch
 Volume _____ Cu. Ft.
 Rock Pressure _____ lbs. _____ hrs.
 Oil _____ bbls., 1st 24 hrs.
 Fresh water _____ feet _____ feet
 Salt water 1120 1205 feet _____ feet

Casing and Tubing	Used in Drilling	Left in Well	Packers
Size			
16			Kind of Packer _____
13			
10	<u>315</u>	<u>Pulled</u>	Size of _____
8 1/4	<u>1215</u>	<u>600</u>	
6 5/8	<u>1351</u>	<u>1351</u>	Depth set _____
5 3/16	<u>1581</u>	<u>1581</u>	
3			Perf. top _____
2	<u>2220</u>	<u>2220</u>	Perf. bottom _____
Liners Used			Perf. top _____
			Perf. bottom _____

~~NOT~~
CASING CEMENTED _____ SIZE _____ No. Ft. _____ Date _____

COAL WAS ENCOUNTERED AT 135 FEET 60 INCHES
240 FEET 120 INCHES FEET INCHES
FEET INCHES FEET INCHES

Formation	Color	Hard or Soft	Top	Bottom	Oil, Gas or Water	Depth Found	Remarks
Mapletown Coal			<u>135</u>	<u>140</u>			
Pittsburgh Coal			<u>240</u>	<u>250</u>			
Little Dunkard			<u>640</u>	<u>650</u>			
Gas sand			<u>948</u>	<u>972</u>			
Salt sands			<u>1105</u>	<u>1300</u>	<u>water</u>	<u>1120</u> <u>1205</u>	<u>hole fall</u>
Big Lime			<u>1516</u>	<u>1581</u>			
Big Injun			<u>1581</u>	<u>1755</u>	<u>gas</u>	<u>1681</u> <u>1696</u>	
Gantz			<u>1790</u>	<u>1893</u>			
Fifty foot			<u>2167</u>	<u>2215</u>	<u>gas</u>	<u>2168</u>	
Total depth				<u>2220</u>			

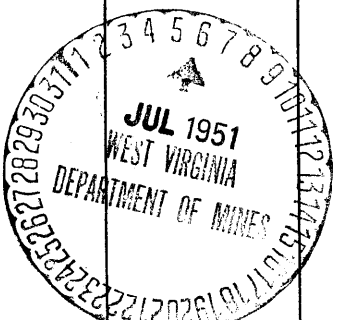

Formation	Color	Hard or Soft	Top	Bottom	Oil, Gas or Water	Depth Found	Remarks

Date July 5, 1951., 19__

APPROVED Hope Natural Gas Company., Owner

By _____

(T. J. H.)

STATE OF WEST VIRGINIA
DEPARTMENT OF MINES
OIL AND GAS DIVISION

AFFIDAVIT OF PLUGGING AND FILLING WELL.

AFFIDAVIT SHOULD BE MADE IN TRIPLICATE. ONE COPY SHALL BE TO THE DEPARTMENT, ONE COPY TO BE RETURNED TO THE WELL OPERATOR AND THE THIRD COPY AND CERTA COPIES IF REQUIRED, SHOULD BE SHOWN TO EACH WELL OPERATOR AT THEIR RESPECTIVE LOCATIONS.

Lodge Creek Collieries Company, Hope Natural Gas Company,
WELL OPERATOR OR OWNER NAME OF WELL OPERATOR
Maidenville, W. Va. 145 West Main St., Clarksburg, W. Va.
ADDRESS COMPLETE ADDRESS
_____ WELL AND LOCATION 19
_____ District
_____ County
_____ Monongalia
WELL NO. 9618
_____ Well No. _____
_____ Farm H. G. Doniphan

STATE INSPECTOR SUPERVISING PLUGGING _____

AFFIDAVIT

STATE OF WEST VIRGINIA.

County of Monongalia

I, Guy Barnett and William J. Snodgrass
being first duly sworn according to law depose and say that they are experienced in the work of
plugging and filling oil and gas wells and were employed by Hope Natural Gas Co.
well operator, and participated in the work of plugging and filling the above well, that said work
was commenced on the 17th day of July, 1931, and that the well was plugged
and filled in the following manner:

WELL OR HOLE DESIGN	FILLING MATERIAL		FOULS USED	SAGGING	
	QUANTITY	WELL TO		SEE PAGE	SEE PAGE
<u>Wagon</u>	<u>120-140</u>	<u>Acemast</u>	<u>2220</u>	<u>2147</u>	<u>2-3/8"</u>
<u>Veh. Gals.</u>	<u>240-260</u>	<u>Cement</u>	<u>2147</u>	<u>2127</u>	<u>None</u>
<u>Little Tank</u>	<u>240-260</u>	<u>Acemast</u>	<u>2127</u>	<u>2091</u>	<u>200' Net.</u>
<u>Gas Gals</u>	<u>240-278</u>	<u>Cement</u>	<u>1227</u>	<u>1203</u>	<u>7"</u>
<u>1st Gals</u>	<u>120-1300</u>	<u>Acemast</u>	<u>1283</u>	<u>1254</u>	<u>None - 1254'</u>
<u>2nd Gals</u>	<u></u>	<u>Cement</u>	<u>1264</u>	<u>1284</u>	<u></u>
<u>Big Line</u>	<u>1216-1221</u>	<u>Left open to surface</u>	<u>7"</u>	<u></u>	<u>51"</u>
<u>Injns</u>	<u>1221-1225</u>	<u>Sagging perforated at 240'</u>	<u></u>	<u></u>	<u>1487' - 94'</u>
<u>Gun W</u>	<u>1770-1825</u>	<u>600', 200' and 240', 5"</u>	<u></u>	<u></u>	<u></u>
<u>0070</u>	<u>2127-2218</u>	<u>Test run through marker</u>	<u></u>	<u></u>	<u>2-3/8" thru</u>
<u>Total Depth</u>	<u>2220</u>	<u>into air.</u>	<u></u>	<u></u>	<u>2220' None</u>
WELL DESIGN	DESCRIPTION OF REMEDY				
	Concrete Well Stopper created				
	over top of hole with 2" vent				
	into air. (Marked H. V. G. Co. Well				
	# 9618)				

and that the work of plugging and filling said well was completed on the 24th day of
July, 1931.

And further deponents with not.

Sworn to and subscribed before me this _____

18th day of Sept., 1931

My commission expires _____

_____ H. Wilson