


Latitude 39° 45'

Longitude 80° 10'

4.90 S
3.36 W

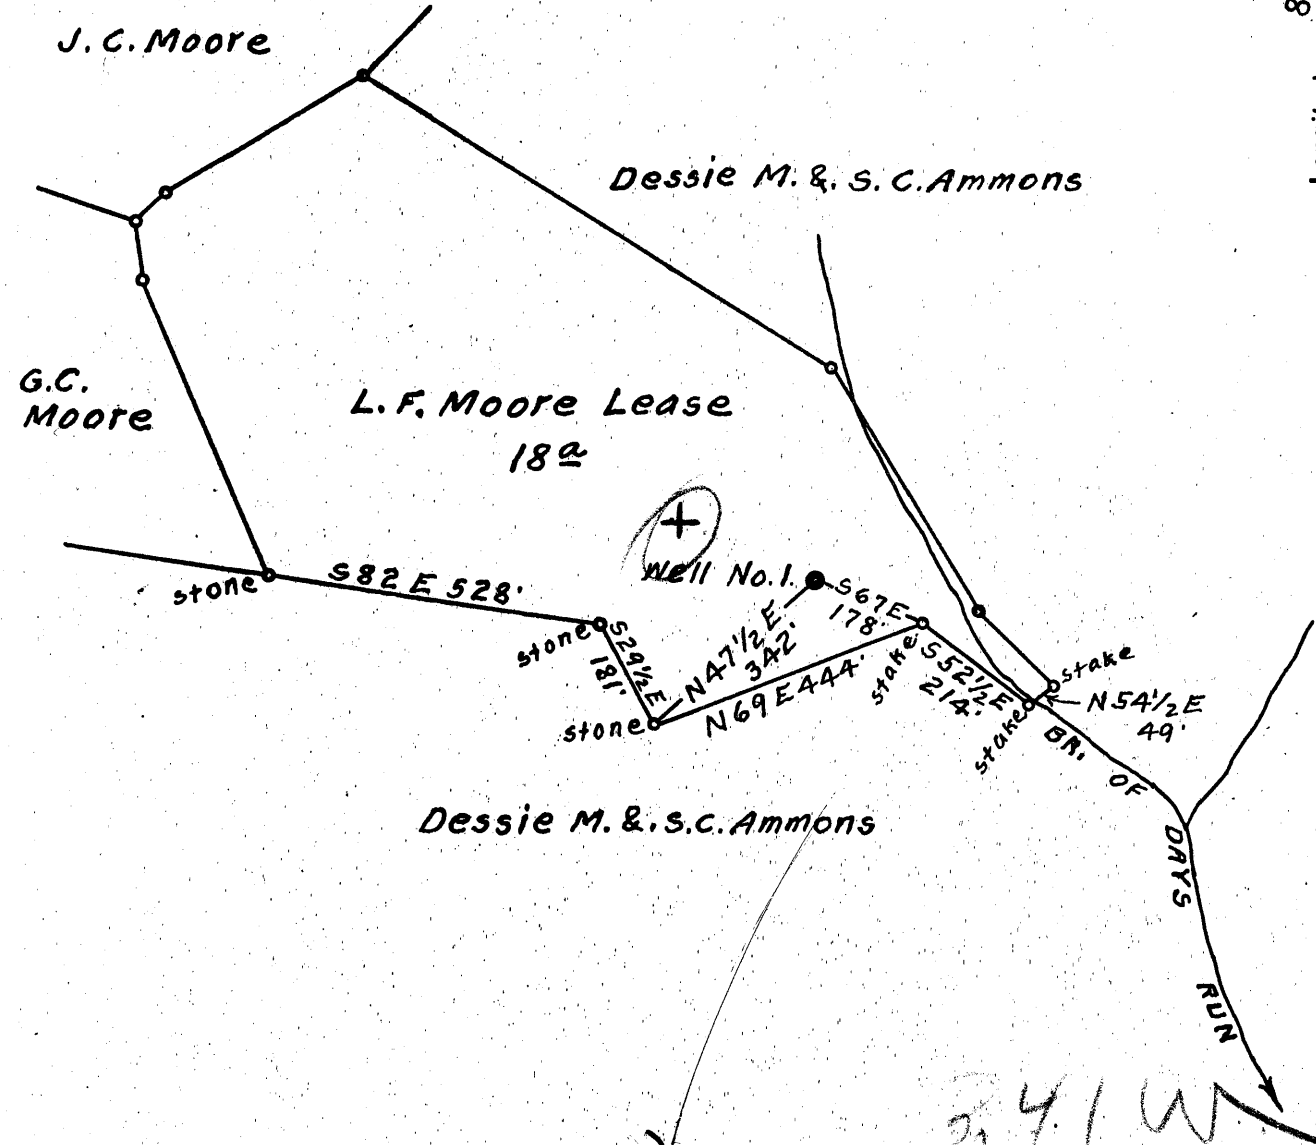

Surface owned by L.F. Moore.
 Address: Mr. L.F. Moore, Zanesfield, Ohio.
 Coal owned by Consolidation Coal Co. (W.Va.)
 Address: Room No. 800, Watson Bldg. Fairmont, W.Va.

New Location...
 Drill Deeper.....
 Abandonment.....

NOV 2 1953
 On 800' Map Sqs. N 16 E 22

Company	<u>William Moses</u>
Address	<u>Salem, W.Va.</u>
Farm	<u>L.F. Moore</u>
Tract	Acres <u>18</u> Lease No. _____
Well (Farm) No.	<u>L</u> Serial No. <u>5274</u>
Elevation (Spirit Level)	Floor - - <u>1226.66</u> Ground - <u>1223.66</u>
Quadrangle	<u>Blacksville</u>
County	<u>Monongalia</u> District <u>Clay</u>
Engineer	<u>Elsworth Haines</u>
Engineer's Registration No.	<u>2221</u>
File No.	_____ Drawing No. _____
Date	<u>Oct. 8th, 1953</u> Scale <u>1" = 300 Feet</u>

STATE OF WEST VIRGINIA
 DEPARTMENT OF MINES
 OIL AND GAS DIVISION
 CHARLESTON

WELL LOCATION MAP
 FILE NO. MON-576-A


+ Denotes location of well on United States Topographic Maps, scale 1 to 62,500, latitude and longitude lines being represented by border lines as shown.

- Denotes one inch spaces on border line of original tracing.

L.F. MOORE No. 1 (5274) - WILLIAM MOSES - MON-576-A

Latitude

Longitude

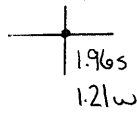

Topo Location

7.5' Loc. _____ 15' Loc. _____
 _____ (calc.) _____

Company W^m Moses

Farm LF Moore #1

15' Quad _____
(sec.)

7.5' Quad Blacksville

District Clay

WELL LOCATION PLAT

County 061 **Permit** 30576



STATE OF WEST VIRGINIA
DEPARTMENT OF MINES
OIL AND GAS DIVISION

WELL RECORD

614

Permit No. 576A Oil or Gas Well _____ (KIND)


Company William Moses
Address Salem, West Va.
Farm L.F. Moore Acres 18
Location (waters) _____
Well No. _____ Elev. 1276.60
District One County Monongalia
The surface of tract is owned in fee by _____
Address _____
Mineral rights are owned by _____
Address _____
Drilling commenced _____
Drilling completed _____
Date Shot _____ From 1915 To _____
With _____

Casing and Tubing	Used in Drilling	Left in Well	Packers
Size			Kind of Packer
16			
13			
10			Size of
8 1/4		1215	
6 5/8		1890	Depth set
5 3/16		2094	
3			Perf. top
2			Perf. bottom
Liners Used			Perf. top
			Perf. bottom

Open Flow _____ /10ths Water in _____ Inch
_____ /10ths Merc. in _____ Inch
Volume _____ Cu. Ft.
Rock Pressure _____ lbs. _____ hrs.
Oil _____ bbls., 1st 24 hrs.
Fresh water _____ feet _____ feet
Salt water _____ feet _____ feet

CASING CEMENTED _____ SIZE _____ No. Ft. _____ Date _____
COAL WAS ENCOUNTERED AT _____ FEET _____ INCHES
_____ FEET _____ INCHES 530 60
795 60 885 84
_____ FEET _____ INCHES _____ FEET _____ INCHES

Formation	Color	Hard or Soft	Top	Bottom	Oil, Gas or Water	Depth Found	Remarks
Fairview Coal			530	535			
Mapletown Coal			795	800			
Pgh. Coal			885	892			
Murphy Sand			1080	1095			
Lt. Dunkard			1210	1240			
Big. "			1375	1410			
1st Gas Sand			1570	1620			
Salt. ss			1670	1995			
Lt. Line			2064	2084			
Big Line			2094	2177			
Big Injun			2177	2389			
Total Depth.				2470			

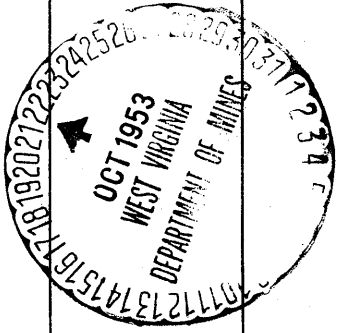

(Over) JAN 2 1954
JAN 2 REC'D