

New Location...
 Drill Deeper.....
 Abandonment.....

DEC 27 1954

MAP SH. 16-N 11, E 29 FB 1105 p 26, 27

Company	HOPE NATURAL GAS CO.		
Address	CLARKSBURG, W. VA.		
Farm	W. E. LYNCH		
Tract	Acres	Lease No.	2868
Well (Farm) No.	Serial No.		2729
Elevation (Spirit Level)	1082'		
Quadrangle	BLACKSVILLE		
County	District	GRANT	
Engineer	Guy H. Bradley		
Engineer's Registration No.	2425		
File No.	Drawing No.		
Date	12-8-54	Scale	1" = 20p.

STATE OF WEST VIRGINIA
 DEPARTMENT OF MINES
 OIL AND GAS DIVISION
 CHARLESTON

WELL LOCATION MAP
 FILE NO. MON-584-A

+ Denotes location of well on United States Topographic Maps, scale 1 to 62,500, latitude and longitude lines being represented by border lines as shown.

- Denotes one inch spaces on border line of original tracing.

W, E. LYNCH No. 2729 - HOPE N. G. Co. - MON-584A



STATE OF WEST VIRGINIA
DEPARTMENT OF MINES
OIL AND GAS DIVISION

632

Quadrangle Blacksville

Permit No. 5847

WELL RECORD

Oil or Gas Well Gas
(KIND)

Company Hope Natural Gas Company
Address 445 West Main St., Clarksburg, W. Va.
Farm W. E. Lynch Acres 58
Location (waters) _____
Well No. 2729 Elev. 1082'
District Grant County Monongalia
The surface of tract is owned in fee by _____
Address _____
Mineral rights are owned by _____
Address _____
Drilling commenced 9-4-12
Drilling completed 10-26-12
Date Shot 11-17-19 From Fifth Sand
With 15 Qts.


Casing and Tubing	Used in Drilling	Left in Well	Packers
Size			Kind of Packer
16			
13			
10	510	510	Size of
8 1/4	1644	1644	Depth set
6 5/8	2577	2577	
5 3/16			
3			Perf. top
2	2848		Perf. bottom
Liners Used	2848		Perf. top
			Perf. bottom

Open Flow _____ /10ths Water in _____ Inch
_____ /10ths Merc. in _____ Inch
Volume ~~Day~~ _____ Cu. Ft.
Rock Pressure _____ lbs. _____ hrs.
Oil _____ bbls., 1st 24 hrs.
Fresh water 280', 490, 515' feet _____ feet
Salt water 1247, 1443 feet _____ feet

CASING CEMENTED _____ SIZE _____ No. Ft. _____ Date
10" casing cemented with 52 bags

COAL WAS ENCOUNTERED AT 294 FEET 72" INCHES
618 FEET 72 INCHES 955 FEET 69 INCHES
1081 FEET 48 INCHES _____ FEET _____ INCHES

Formation	Color	Hard or Soft	Top	Bottom	Oil, Gas or Water	Depth Found	Remarks
Coal			294	300	Water	280	
Pittsburgh Coal			371	377	Water	490	
Coal			618	624			
Little Dunkard			655	675	Water	515	
Coal			955	961			
Big Dunkard			960	1025			
Gas Sand			1044	1076			
Coal			1081	1085			
First Salt			1145	1207			
Second Salt			1229	1272	Water	1247	
Sand			1313	1379	Water	1343	
MAXON			1525	1534			
LITTLE LIME			1584	1598			
Pencil Cave			1598	1626			
BIG LIME			1626	1688			
BIG INJUN			1688	1804	Gas	1774	
BEREA			1890	1920			
GANTZ			2190	2282	Gas	2210	
Fifty Foot			2290	2340			
Thirty Foot			2390	2418			
Gordon Stray			Shells				
Gordon			2518	2595			
Fourth			2650	2665			
Fifth			2724	2780	Gas	2745	
TOTAL DEPTH				2829'			

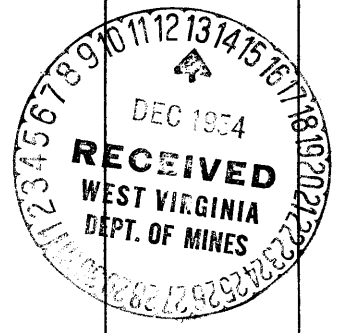

JAN 7 1955

Formation	Color	Hard or Soft	Top	Bottom	Oil, Gas or Water	Depth Found	Remarks

Date December 9th, 1954

APPROVED Hope Natural Gas Company, Owner

By _____ (Title)

Pailey