

- New Location...
- Drill Deeper.....
- Abandonment.....

MAP SH. 2: N. 17 E. 35: F.B. 1049 P. 3-4.

STATE OF WEST VIRGINIA  
DEPARTMENT OF MINES  
OIL AND GAS DIVISION  
CHARLESTON

**WELL LOCATION MAP**

FILE NO. MON-602-A

*253 m 1912 Co. Rpt  
50-7371*

+ Denotes location of well on United States Topographic Maps, scale 1 to 62,500, latitude and longitude lines being represented by border lines as shown.

- Denotes one inch spaces on border line of original tracing.

*duc*

Company HOPE NATURAL GAS CO.  
 Address CLARKSBURG, W. VA.  
 Farm KEENAN BROS.  
 Tract \_\_\_\_\_ Acres 180 Lease No. 61875  
 Well (Farm) No. \_\_\_\_\_ Serial No. 9575  
 Elevation (Spirit Level) 1036'  
 Quadrangle MORGANTOWN  
 County MONONGALIA District CASS  
 Engineer Guy H. Bradley  
 Engineer's Registration No. 2425  
 File No. \_\_\_\_\_ Drawing No. \_\_\_\_\_  
 Date July 18, 1955 Scale 1"=40 POLES



STATE OF WEST VIRGINIA  
DEPARTMENT OF MINES  
OIL AND GAS DIVISION

646

WELL RECORD

Permit No. 1007A

Oil or Gas Well Gas  
(KIND)

Company Hope Natural Gas Company  
Address 445 West Main St., Clarksburg, W. Va.  
Farm Keenan Bros. Acres 180  
Location (waters) \_\_\_\_\_  
Well No. 9575 Elev. 1036'  
District Cass County Monongalia  
The surface of tract is owned in fee by \_\_\_\_\_  
Address \_\_\_\_\_  
Mineral rights are owned by \_\_\_\_\_  
Address \_\_\_\_\_

Drilling commenced Oct. 3, 1911  
Drilling completed Nov. 7, 1911  
Date Shot No record From \_\_\_\_\_ To \_\_\_\_\_  
With \_\_\_\_\_


Open Flow \_\_\_\_\_ /10ths Water in \_\_\_\_\_ Inch  
\_\_\_\_\_ /10ths Merc. in \_\_\_\_\_ Inch  
Volume Exhausted Cu. Ft. \_\_\_\_\_  
Rock Pressure \_\_\_\_\_ lbs. \_\_\_\_\_ hrs.  
Oil None bbls., 1st 24 hrs. \_\_\_\_\_  
Fresh water None Rec. feet \_\_\_\_\_ feet  
Salt water do feet \_\_\_\_\_ feet

Casing and Tubing	Used in Drilling	Left in Well	Packers
Size			Kind of Packer
16			
13			
10			Size of
8 1/4			
6 3/8			Depth set
5 3/16	<u>1495</u>	<u>1495</u>	
3			Perf. top
2	<u>1550</u>	<u>1550</u>	Perf. bottom
Liners Used			Perf. top
			Perf. bottom

CASING CEMENTED \_\_\_\_\_ SIZE \_\_\_\_\_ No. Ft. \_\_\_\_\_ Date \_\_\_\_\_  
No record of cementing

COAL WAS ENCOUNTERED AT 18 FEET 60 INCHES  
86 FEET 48 INCHES 117 FEET 84 INCHES  
857 FEET \_\_\_\_\_ INCHES 756 FEET \_\_\_\_\_ INCHES

Formation	Color	Hard or Soft	Top	Bottom	Oil, Gas or Water	Depth Found	Remarks
Surface			0	14			
Slate			14	18			
Coal			18	23			
Lime			23	57			
Slate			57	86			
Coal			86	90			
Lime			90	117			
Coal			117	124			
Slate & Lime			124	168			
Sand			168	176			
Slate & Shells			176	285			
Sand			285	340			
Slate & Red Rock			340	587			
Little Dunkard			587	618			
Slate & Shells			618	682			
Big Dunkard			682	837			
Coal			837	840			
Slate & Shells			840	956			
Coal			956	960			
1st. & 2nd. Salt Sand			960	1138			
Sandy Lime			1138	1207			
Red Rock			1207	1222			
Gritty Lime			1222	1268			
Red Rock			1268	1354			
Little Lime			1354	1369			
Pencil Cave			1369	1374			
BIG LIME			1374	1452			
BIG INJUN			1452	1545'	<u>Gas</u>	<u>1542</u>	
TOTAL DEPTH				1592'			

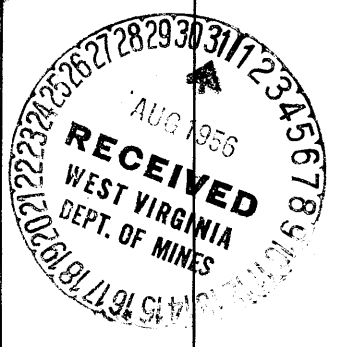

August 23, 1956  
Jack Bailey  
Hope Natural Gas Company

OCT 26 1956