


Latitude 39° 40'

Longitude 80° 15'



1.395
1.80 W

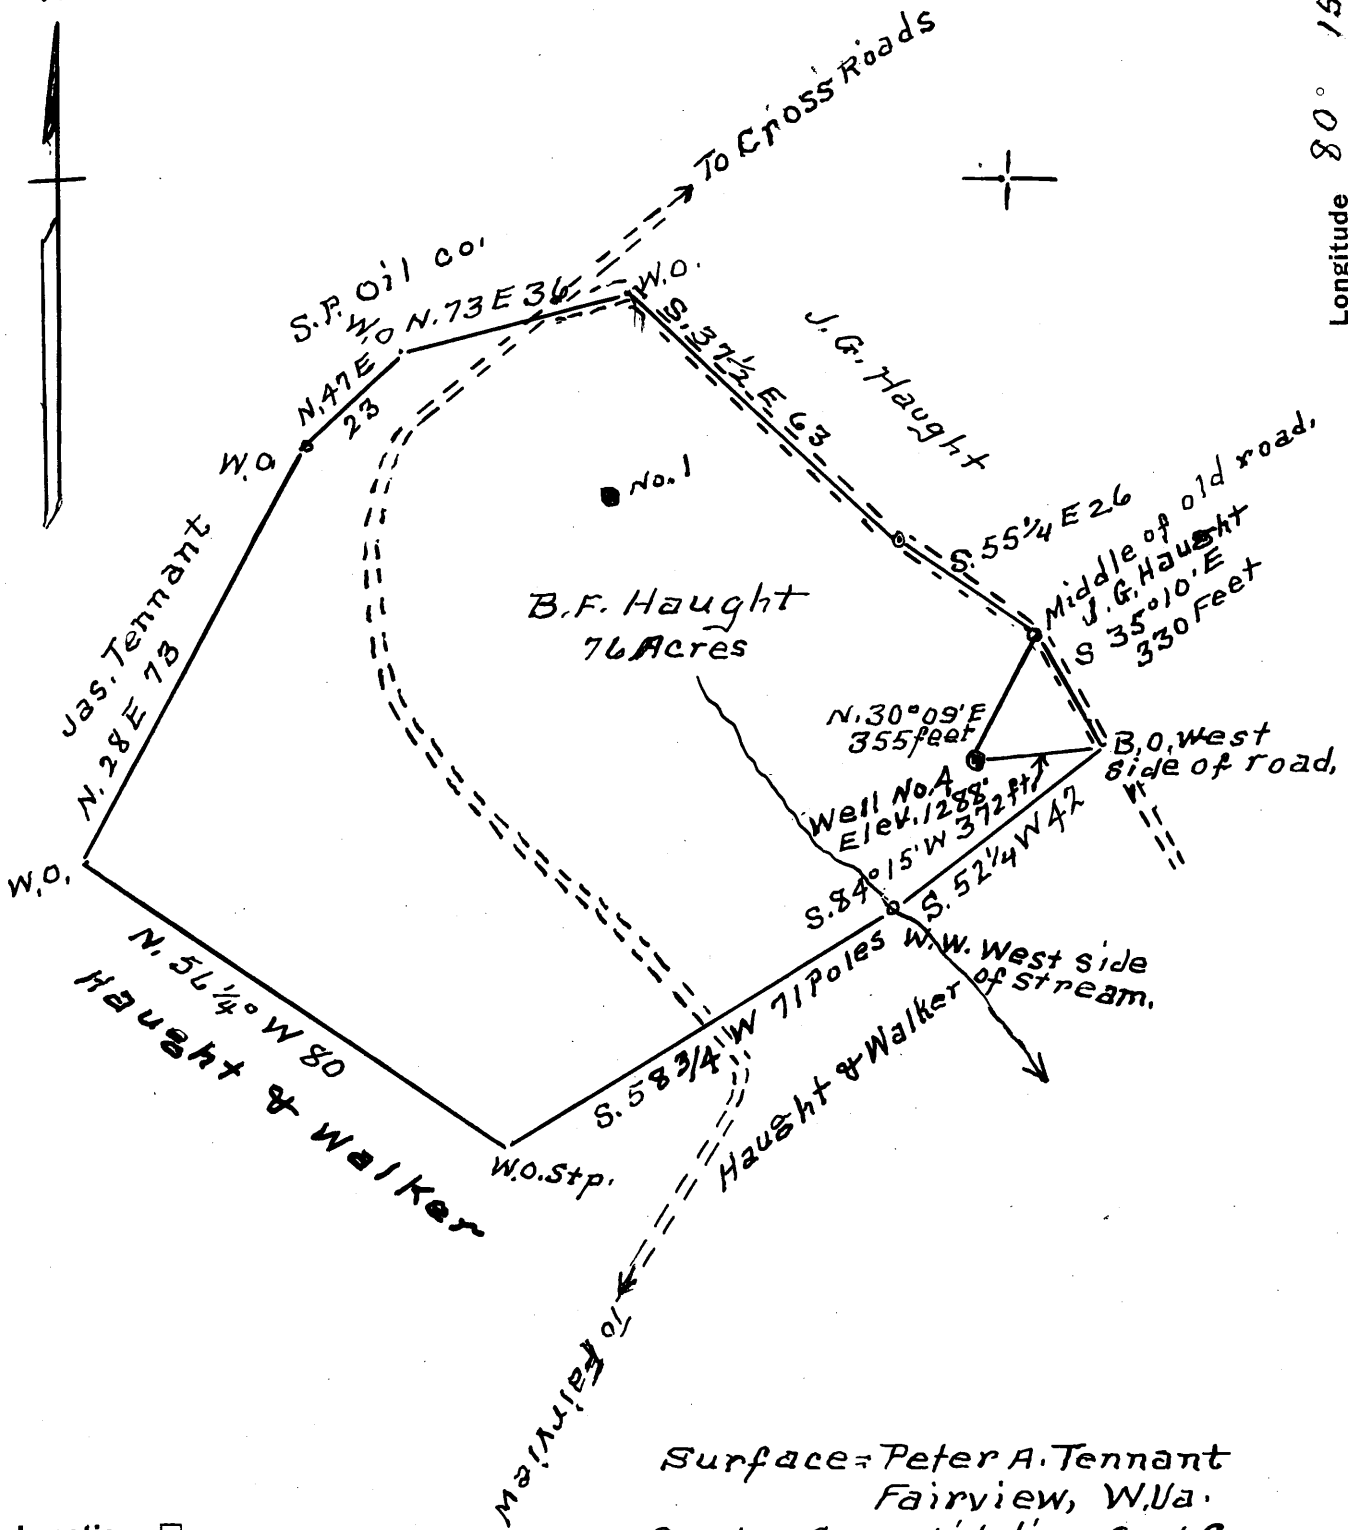

New Location
 Drill Deeper
 Abandonment

Surface = Peter A. Tennant
 Fairview, W.Va.
 Coal = Consolidation Coal Co
 c/o Bernard & Sampson
 Fairmont W.Va.

Company Cecil Chisler & Son
 Address R. #. 2. Fairview, W. Va.
 Farm B. F. Haught
 Tract 1 Acres 76 Lease No. _____
 Well (Farm) No. 4 Serial No. _____
 Elevation (Spirit Level) 1288'
 Quadrangle MANNINGTON
 County Monongalia District Battelle
 Engineer A. L. Headley
 Engineer's Registration No. 2021
 File No. _____ Drawing No. _____
 Date 7-11-62 Scale 1" = 500'

STATE OF WEST VIRGINIA
 DEPARTMENT OF MINES
 OIL AND GAS DIVISION
 CHARLESTON

WELL LOCATION MAP
 FILE NO. MON-654-A

+ Denotes location of well on United States Topographic Maps, scale 1 to 62,500, latitude and longitude lines being represented by border lines as shown.

- Denotes one inch spaces on border line of original tracing.