


LATITUDE 39°32'30"

"081506L"

LONGITUDE

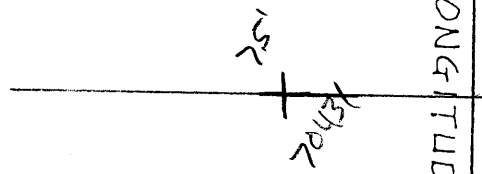

7'5 OGIS topo location

7.5' LOC	<u>1.80S</u>	15' LOC	<u>4.68S</u>
	<u>0.37W</u>	(calc.)	<u>2.59W</u>

#342 in 1912 G Rpt

Company _____

Farm _____

Quad Morgantown South SW

County Monongalia

District Clinton

WELL LOCATION MAP

File No. 061-70431