



---

west virginia department of environmental protection

---

Office of Oil and Gas  
601 57<sup>th</sup> Street, S.E.  
Charleston, WV 25304  
(304) 926-0450  
fax: (304) 926-0452

Austin Caperton, Cabinet Secretary  
[www.dep.wv.gov](http://www.dep.wv.gov)

Wednesday, August 1, 2018  
WELL WORK PERMIT  
Horizontal 6A / New Drill

SWN PRODUCTION COMPANY, LLC  
POST OFFICE BOX 12359

SPRING, TX 773914954

Re: Permit approval for DALLAS HALL OHI 1H  
47-069-00281-00-00

This well work permit is evidence of permission granted to perform the specified well work at the location described on the attached pages and located on the attached plat, subject to the provisions of Chapter 22 of the West Virginia Code of 1931, as amended, and all rules and regulations promulgated thereunder, and to any additional specific conditions and provisions outlined in the pages attached hereto. Notification shall be given by the operator to the Oil and Gas Inspector at least 24 hours prior to the construction of roads, locations, and/or pits for any permitted work. In addition, the well operator shall notify the same inspector 24 hours before any actual well work is commenced and prior to running and cementing casing. Spills or emergency discharges must be promptly reported by the operator to 1-800-642-3074 and to the Oil and Gas Inspector.

Please be advised that form WR-35, Well Operators Report of Well Work is to be submitted to this office within 90 days of completion of permitted well work, as should form WR-34 Discharge Monitoring Report within 30 days of discharge of pits, if applicable. Failure to abide by all statutory and regulatory provisions governing all duties and operations hereunder may result in suspension or revocation of this permit and, in addition, may result in civil and/or criminal penalties being imposed upon the operators.

Per 35 CSR 4-5.2.g this permit will expire in two (2) years from the issue date unless permitted well work is commenced. If there are any questions, please feel free to contact me at (304) 926- 0450.

James A. Martin  
Chief

Operator's Well Number: DALLAS HALL OHI 1H  
Farm Name: HALL, AGNES L  
U.S. WELL NUMBER: 47-069-00281-00-00  
Horizontal 6A New Drill  
Date Issued: 8/1/2018

# PERMIT CONDITIONS

West Virginia Code § 22-6A-8(d) allows the Office of Oil and Gas to place specific conditions upon this permit. Permit conditions have the same effect as law. Failure to adhere to the specified permit conditions may result in enforcement action.

## CONDITIONS

---

1. This proposed activity may require permit coverage from the United States Army Corps of Engineers (USACE). Through this permit, you are hereby being advised to consult with USACE regarding this proposed activity.
2. If the operator encounters an unanticipated void, or an anticipated void at an unanticipated depth, the operator shall notify the inspector within 24 hours. Modifications to the casing program may be necessary to comply with W. Va. Code § 22-6A-5a (12), which requires drilling to a minimum depth of thirty feet below the bottom of the void, and installing a minimum of twenty (20) feet of casing. Under no circumstance should the operator drill more than one hundred (100) feet below the bottom of the void or install less than twenty (20) feet of casing below the bottom of the void.
3. When compacting fills, each lift before compaction shall not be more than 12 inches in height, and the moisture content of the fill material shall be within limits as determined by the Standard Proctor Density test of the actual soils used in specific engineered fill, ASTM D698, Standard Test Method for Laboratory Compaction Characteristics of Soil Using Standard Effort, to achieve 95 % compaction of the optimum density. Each lift shall be tested for compaction, with a minimum of two tests per lift per acre of fill. All test results shall be maintained on site and available for review.
4. Operator shall install signage per § 22-6A-8g (6) (B) at all source water locations included in their approved water management plan within 24 hours of water management plan activation.
5. Oil and gas water supply wells will be registered with the Office of Oil and Gas and all such wells will be constructed and plugged in accordance with the standards of the Bureau for Public Health set forth in its Legislative rule entitled *Water Well Regulations*, 64 C.S.R. 19. Operator is to contact the Bureau of Public Health regarding permit requirements. In lieu of plugging, the operator may transfer the well to the surface owner upon agreement of the parties. All drinking water wells within fifteen hundred feet of the water supply well shall be flow tested by the operator upon request of the drinking well owner prior to operating the water supply well.
6. Pursuant to the requirements pertaining to the sampling of domestic water supply wells/springs the operator shall, no later than thirty (30) days after receipt of analytical data provide a written copy to the Chief and any of the users who may have requested such analyses.
7. 24 hours prior to the initiation of the completion process the operator shall notify the Chief or his designee.
8. During the completion process the operator shall monitor annular pressures and report any anomaly noticed to the chief or his designee immediately.
9. If any explosion or other accident causing loss of life or serious personal injury occurs in or about a well or well work on a well, the well operator or its contractor shall give notice, stating the particulars of the explosion or accident, to the oil and gas inspector and the Chief, within 24 hours of said accident.
10. During the casing and cementing process, in the event cement does not return to the surface, the oil and gas inspector shall be notified within 24 hours.

## PERMIT CONDITIONS

11. The operator shall provide to the Office of Oil and Gas the dates of each of the following within 30 days of their occurrence: completion of construction of the well pad, commencement of drilling, cessation of drilling, completion of any other permitted well work, and completion of the well. Such notice shall be provided by sending an email to [DEPOOGNotify@wv.gov](mailto:DEPOOGNotify@wv.gov).

STATE OF WEST VIRGINIA  
DEPARTMENT OF ENVIRONMENTAL PROTECTION, OFFICE OF OIL AND GAS  
WELL WORK PERMIT APPLICATION

1) Well Operator: SWN Production Co., LLC 494512924 069-Ohio 3-Liberty 247-Bethany  
Operator ID County District Quadrangle

2) Operator's Well Number: Dallas Hall OHI 1H Well Pad Name: Dallas Hall OHI Pad

3) Farm Name/Surface Owner: Agnes L. Hall Public Road Access: G C & P Road

4) Elevation, current ground: 1275' Elevation, proposed post-construction: 1275'

5) Well Type (a) Gas  Oil  Underground Storage   
Other

(b) If Gas Shallow  Deep   
Horizontal

6) Existing Pad: Yes or No Yes

*C. Bell 5-7-18*

7) Proposed Target Formation(s), Depth(s), Anticipated Thickness and Expected Pressure(s):  
Target Formation- Marcellus, Up-Dip to the North, Target Top TVD- 6109', Target Base TVD- 6149', Anticipated Thickness- 40', Associated Pressure- 3996

8) Proposed Total Vertical Depth: 6129'

9) Formation at Total Vertical Depth: Marcellus

10) Proposed Total Measured Depth: 16700'

11) Proposed Horizontal Leg Length: 10054.20'

12) Approximate Fresh Water Strata Depths: 410'

13) Method to Determine Fresh Water Depths: water well

14) Approximate Saltwater Depths: 601' SWN salinity profile

15) Approximate Coal Seam Depths: 446'

16) Approximate Depth to Possible Void (coal mine, karst, other): Possible Void 446'

17) Does Proposed well location contain coal seams directly overlying or adjacent to an active mine? Yes  No

(a) If Yes, provide Mine Info: Name: \_\_\_\_\_  
Depth: \_\_\_\_\_  
Seam: \_\_\_\_\_  
Owner: \_\_\_\_\_

RECEIVED  
Office of Oil and Gas  
MAY 21 2018  
WV Department of  
Environmental Protection

18)

**CASING AND TUBING PROGRAM**

TYPE	Size (in)	New or Used	Grade	Weight per ft. (lb/ft)	FOOTAGE: For Drilling (ft)	INTERVALS: Left in Well (ft)	CEMENT: Fill-up (Cu. Ft.)/CTS
Conductor	20"	New	H-40	94#	100'	100' ✓	CTS
Fresh Water	13 3/8"	New	H-40	48#	520'	520' ✓	496 sx/CTS
Coal							
Intermediate	9 5/8"	New	J-55	36#	1920'	1920' ✓	732 sx/CTS
Production	5 1/2"	New	HCP-110	20#	16700'	16700'	load 822# Tall 2461# Inside Intermediate
Tubing							
Liners							

*Done 5-7-18*

TYPE	Size (in)	Wellbore Diameter (in)	Wall Thickness (in)	Burst Pressure (psi)	Anticipated Max. Internal Pressure (psi)	Cement Type	Cement Yield (cu. ft./k)
Conductor	20"	30"	0.25	2120	81	Class A	1.19/50% Excess
Fresh Water	13 3/8"	17.5"	0.380	2740	633	Class A	1.19/50% Excess
Coal	9 5/8"	12 1/4"	0.395	3950	1768	Class A	1.19/50% Excess
Intermediate	7"	8 3/4"	0.317	4360	3250	Class A	1.20/50% Excess
Production	5 1/2"	8 3/4"	0.361	12360	9500	Class A	1.20/50% Excess
Tubing							
Liners							

**PACKERS**

Kind:				
Sizes:				
Depths Set:				

RECEIVED  
Office of Oil and Gas  
MAY 21 2018  
WV Department of  
Environmental Protection

19) Describe proposed well work, including the drilling and plugging back of any pilot hole:

Drill and stimulate any potential zones between and including the Benson to Marcellus. \*\*If we should encounter a void place basket above and below void area- balance cement to bottom of void and grout from basket to surface or run external casing packer/cementing stage tool above void interval and perform 2 stage cementing operation dependent upon depth of void. Run casing not less than 20' below void nor more than 100' below void. (\*If freshwater is encountered deeper than anticipated it must be protected, set casing a minimum of 50' below freshwater interval and cement to surface.)

20) Describe fracturing/stimulating methods in detail, including anticipated max pressure and max rate:

Well will be perforated within the target formation and stimulated with a slurry of water, sand, and chemical additives at a high rate. This will be performed in stages with the plug and perf method along the wellbore until the entire lateral has been stimulated within the target formation. All stage plugs are then drilled out and the well is flowed back to surface. The well is produced through surface facilities consisting of high pressure production units, vertical separation units, water and oil storage tanks. Max press and anticipated max rate- 9000 lbs @ 100 barrels a minute.

21) Total Area to be disturbed, including roads, stockpile area, pits, etc., (acres): 22.60

22) Area to be disturbed for well pad only, less access road (acres): 8.54

23) Describe centralizer placement for each casing string:

All casing strings will be ran with a centralizer at a minimum of 1 per every 3 joints of casing.

24) Describe all cement additives associated with each cement type:

See Attachment \*\*\*

25) Proposed borehole conditioning procedures:

All boreholes will be conditioned with circulation and rotation for a minimum of one bottoms up and continuing until operator is satisfied with borehole conditions.

RECEIVED  
Office of Oil and Gas  
MAY 21 2018  
WV Department of  
Environmental Protection

\*Note: Attach additional sheets as needed.



SWN Production Company, LLC  
179 Innovation Drive  
Jane Lew, WV 26378  
Tel: 304 884 1610  
Fax: 304 471 2497  
www.swn.com

May 1, 2018

Ms. Laura Adkins  
Office of Oil & Gas  
601 57<sup>th</sup> Street  
Charleston, WV 25304

**RE:** Proposed New Well Dallas Hall OHI 1H

Dear Ms. Adkins

SWN has reviewed the area of the above mentioned well and discovered no shallow wells within 500' of the lateral. This well is situated on the Hall's property, in Liberty District, Ohio County, West Virginia.

If you have any questions or desire additional information, please me at 304-884-1614.

Thank you.

Sincerely,


Dee Southall  
Senior Regulatory Analyst  
Southwestern Energy Production Company, LLC

RECEIVED  
Office of Oil and Gas

MAY 21 2018

WV Department of  
Environmental Protection

<b>Southwestern Energy Company</b>			<b>Proposed Drilling Program</b>		
Well:	DALLAS HALL OHI 1		Re-entry Rig:	TBD	
Field:	PANHANDLE FIELD \		Prospect:	PANHANDLE	
County:	OHIO		State:	WV	
SHL:	40.1334 Latitude	-80.6129 Longitude			
BHL:	40.1603 Latitude	-80.6273 Longitude			
KB Elev:	1,301 ft MSL	KB: 26 ft AGL	GL Elev:	1,275 ft MSL	

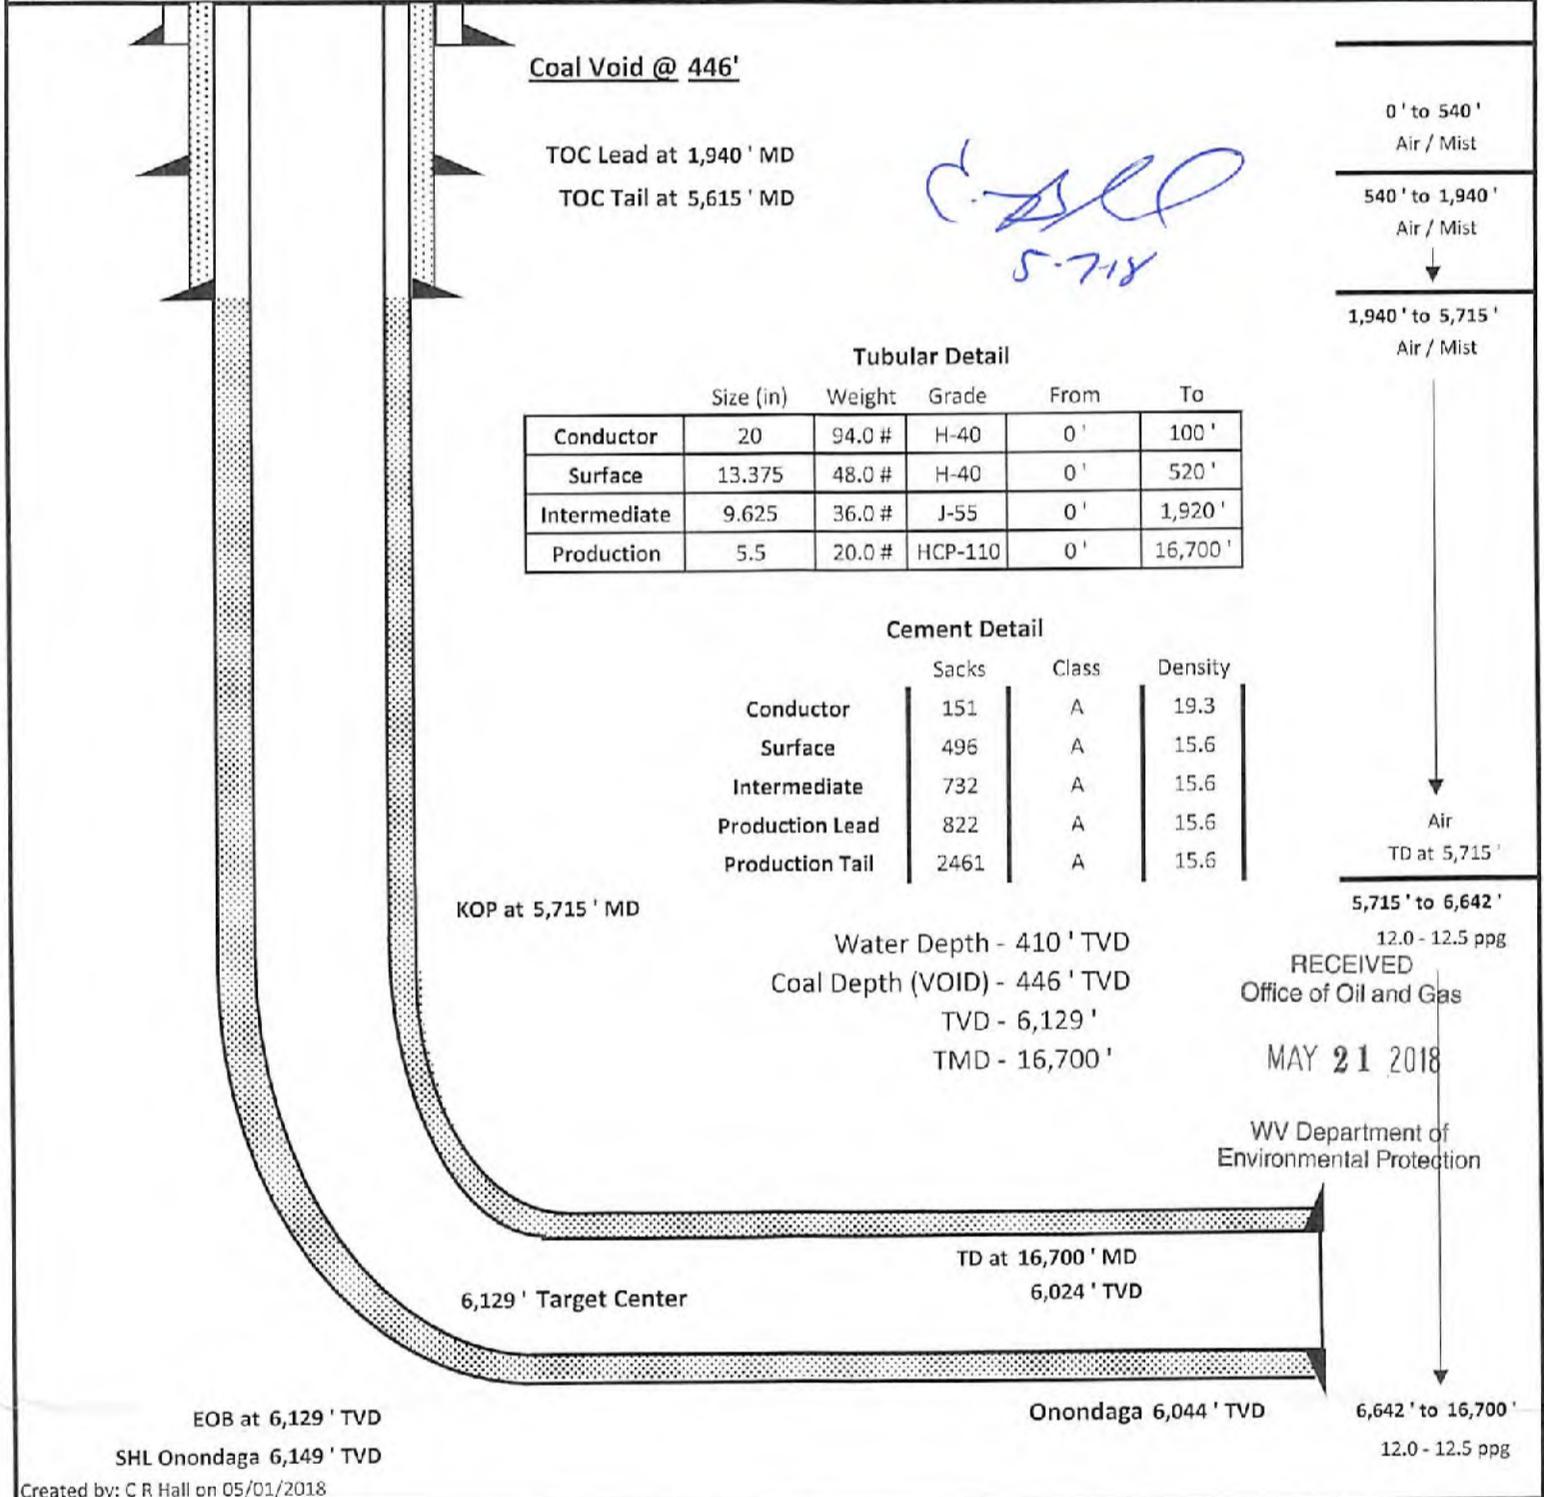

08/03/2018

## Schlumberger Cement Additives

	Product Name	Product Use	Chemical Name	CAS Number
Intermediate Surface	S001	accelerator	calcium chloride	10043-52-4
	S001	accelerator	calcium chloride	10043-52-4
Kick Off Plug	D080	dispersant	sodium polynaphthalene sulfonate	9008-63-3
	D801	retarder	aromatic polymer derivative	proprietary
	D047	antifoam	polypropylene glycol	25322-69-4
Production-Lead	D167	fluid loss	aliphatic amide polymer	proprietary
	D154	extender	non-crystalline silica	7631-86-9
	D400	gas migration	boric acid	10043-35-3
			polypropylene glycol	25322-69-4
	D046	antifoam	fullers earth (attapulgate)	8031-18-3
			chrystalline silica	14808-60-7
	D201	retarder	metal oxide	proprietary
			sulphonated synthetic polymer	proprietary
	D202	dispersant	formaldehyde (impurity)	proprietary
Production-Tail			polypropylene glycol	25322-69-4
	D046	antifoam	fullers earth (attapulgate)	8031-18-3
	D167	fluid loss	aliphatic amide polymer	proprietary
			sodium polynaphthalene sulfonate	9008-63-3
	D065	dispersant	sodium sulfate	7757-82-6
			chrystalline silica	14808-60-7
		metal oxide	proprietary	
D153	anti-settling	chrystalline silica	14808-60-7	

RECEIVED  
Office of Oil and Gas

MAY 21 2018

WV Department of  
Environmental Protection

WW-9  
(2/15)

API Number 47 - 069 - \_\_\_\_\_  
Operator's Well No. Dallas Hall OHI 1H

STATE OF WEST VIRGINIA  
DEPARTMENT OF ENVIRONMENTAL PROTECTION  
OFFICE OF OIL AND GAS

FLUIDS/ CUTTINGS DISPOSAL & RECLAMATION PLAN

RECEIVED  
Office of Oil and Gas  
MAY 21 2018  
WV Department of  
Environmental Protection

Operator Name SWN Production Co., LLC OP Code 494512924

Watershed (HUC 10) Upper Ohio South Quadrangle Bethany

Do you anticipate using more than 5,000 bbls of water to complete the proposed well work? Yes  No

Will a pit be used? Yes  No

If so, please describe anticipated pit waste: \_\_\_\_\_

Will a synthetic liner be used in the pit? Yes  No  If so, what ml.? \_\_\_\_\_

Proposed Disposal Method For Treated Pit Wastes:

- Land Application
- Underground Injection ( UIC Permit Number 34-155-22403, 34-059-24067, 34-119-20776, 34-167-20962, 34-155-23795, 34-121-23995, 34-155-21803 )
- Reuse (at API Number \_\_\_\_\_ at next anticipated well, API# will be included with the WR-34/DDMR &/or permit addendum. )
- Off Site Disposal (Supply form WW-9 for disposal location)
- Other (Explain flow back fluids will be put in steel tanks and reused or taken to a permitted disposal facility )

Will closed loop system be used? If so, describe: Yes

Drilling medium anticipated for this well (vertical and horizontal)? Air, freshwater, oil based, etc. Air and salt saturate mud

-If oil based, what type? Synthetic, petroleum, etc. Synthetic Oil Base

Additives to be used in drilling medium? Attachment 3A

Drill cuttings disposal method? Leave in pit, landfill, removed offsite, etc. landfill

-If left in pit and plan to solidify what medium will be used? (cement, lime, sawdust) \_\_\_\_\_

-Landfill or offsite name/permit number? Meadowfill SWF- 1032, Short Creek SWF-1034, Carbon Limestone MSWL018781, Wetzel County 1021 Arden Landfill 10072, Apex Sanitary Landfill 06-08438, Brooke Co SWF-1013, Valley 100280

Permittee shall provide written notice to the Office of Oil and Gas of any load of drill cuttings or associated waste rejected at any West Virginia solid waste facility. The notice shall be provided within 24 hours of rejection and the permittee shall also disclose where it was properly disposed.

I certify that I understand and agree to the terms and conditions of the GENERAL WATER POLLUTION PERMIT issued on August 1, 2005, by the Office of Oil and Gas of the West Virginia Department of Environmental Protection. I understand that the provisions of the permit are enforceable by law. Violations of any term or condition of the general permit and/or other applicable law or regulation can lead to enforcement action.

I certify under penalty of law that I have personally examined and am familiar with the information submitted on this application form and all attachments thereto and that, based on my inquiry of those individuals immediately responsible for obtaining the information, I believe that the information is true, accurate, and complete. I am aware that there are significant penalties for submitting false information, including the possibility of fine or imprisonment.

Company Official Signature \_\_\_\_\_

Company Official (Typed Name) Dee Southall

Company Official Title Senior Regulatory Analyst



Subscribed and sworn before me this 30th day of April, 2018

Brittany R. Woody Notary Public

My commission expires 11/27/22

SWN Production Co., LLC

Proposed Revegetation Treatment: Acres Disturbed 22.60 Prevegetation pH \_\_\_\_\_

Lime as determined by pH test m.n. 2 Tons/acre or to correct to pH 8.54

Fertilizer type 10-20-20

Fertilizer amount 600 lbs/acre

Mulch Hay/Straw 2.5 Tons/acre

Seed Mixtures

**Temporary**

**Permanent**

Seed Type lbs/acre

Seed Type lbs/acre

Attachment 3B

Attach:

Drawing(s) of road, location, pit and proposed area for land application (unless engineered plans including this info have been provided)

Photocopied section of involved 7.5' topographic sheet.

Plan Approved by: \_\_\_\_\_

*[Handwritten Signature]* 5-7-18

Comments: \_\_\_\_\_

RECEIVED  
Office of Oil and Gas  
MAY 21 2018  
WV Department of  
Environmental Protection

Title: Oil and Gas Inspector

Date: 5-7-18

Field Reviewed? (  ) Yes (  ) No

**Drilling Mediums**

Synthetic Oil

Brine

Barite

Calcium Chloride

Lime

Organophilic Bentonite

Primary and Secondary Emulsifiers

Gilsonite

Calcium Carbonate

Friction Reducers

RECEIVED  
Office of Oil and Gas  
MAY 21 2018  
WV Department of  
Environmental Protection



# WVD Seeding Specification

*R<sup>2</sup> → V<sup>+</sup>*

To Order Seed contact Lyndsi Eddy Flipppo office 570-996-4271 cell 501-269-5451 lyndsi\_eddy@swn.com (please allow 7 to 10 days for delivery)

## NON-ORGANIC PROPERTIES

Seed Mixture: ROW Mix	SWN Supplied
Orchardgrass	40%
Timothy	15%
Annual Ryegrass	15%
Brown Top Millet	5%
Red Top	5%
Medium Red Clover	5%
White Clover	5%
Birdsfoot Trefoil	5%
Rough Bluegrass	5%

All legumes are  
innoculated at 5x normal  
rate

Apply @ 100lbs per acre  
April 16th- Oct. 14th

Apply @ 200lbs per acre  
Oct. 15th- April 15th PLUS  
50lbs per acre of Winter Wheat

## SOIL AMENDMENTS

10-20-20 Fertilizer	*Apply @ 500lbs per Acre
Pelletized Lime	Apply @ 2 Tons per Acre

\*unless otherwise dictated by soil test results

## Seeding Calculation Information:

1452' of 30' ROW/LOD is One Acre  
871' of 50' ROW/LOD is One Acre  
622' of 70' ROW/LOD is One Acre

## Synopsis:

Every 622 linear feet in a 70' ROW/LOD, you should be using (2) 50lb bags of seed, (4) 50lb bags of fertilizer and (80) 50lb bags of Lime (2x seed in winter months + 50lb Winter Wheat/ac).

## Special Considerations:

Landowner Special Considerations including CREP program participants require additional guidance that is not given here. Discuss these requirements with SWN supervision at the beginning of the project to allow time for special seed delivery.

## ORGANIC PROPERTIES

Seed Mixture: SWN Production Organic Mix	SWN Supplied
Organic Timothy	50%
Organic Red or White Clover	50%
OR	
Organic Perennial Ryegrass	50%
Organic Red or White Clover	50%

Apply @ 100lbs per acre  
April 16th- Oct. 14th

Organic Fertilizer @ 200lbs per Acre

Apply @ 200lbs per acre  
Oct. 15th- April 15th

Pelletized Lime @ 2 Tons per Acre

## WETLANDS (delineated as jurisdictional wetlands)

Seed Mixture: Wetland Mix	SWN Supplied
VA Wild Ryegrass	20%
Annual Ryegrass	20%
Fowl Bluegrass	20%
Cosmos 'Sensation'	10%
Redtop	5%
Golden Tickseed	5%
Maryland Senna	5%
Showy Tickseed	5%
Fox Sedge	2.5%
Soft Rush	2.5%
Woolgrass	2.5%
Swamp Verbena	2.5%

Apply @ 25lbs per acre  
April 16th- Oct. 14th

Apply @ 50lbs per acre  
Oct. 15th- April 15th

NO FERTILIZER OR LIME INSIDE WETLAND LIMITS

RECEIVED  
 Office of Oil and Gas  
 MAY 21 2018  
 WV Department of  
 Environmental Protection

4706900281

# MARCELLUS WELL DRILLING PROCEDURES AND WELL SITE SAFETY PLAN



SWN Production Company, LLC  
179 Innovation Drive  
Jane Lew, West Virginia 26378

**API NO. 47-XXX-XXXXX**  
**WELL NAME: Dallas Hall OHI 1H**  
**Bethany QUAD**  
**Liberty DISTRICT**  
**Ohio COUNTY, WEST VIRGINIA**

Submitted by:

4/23/2018

Dee Southall

Date:

Senior Regulatory

Title: Analyst

SWN Production Co., LLC

Approved by:

Date:

5-7-18


Title: District Gas Inspector

Approved by:

Date:

Title:

RECEIVED  
Office of Oil and Gas  
MAY 21 2018  
WV Department of  
Environmental Protection

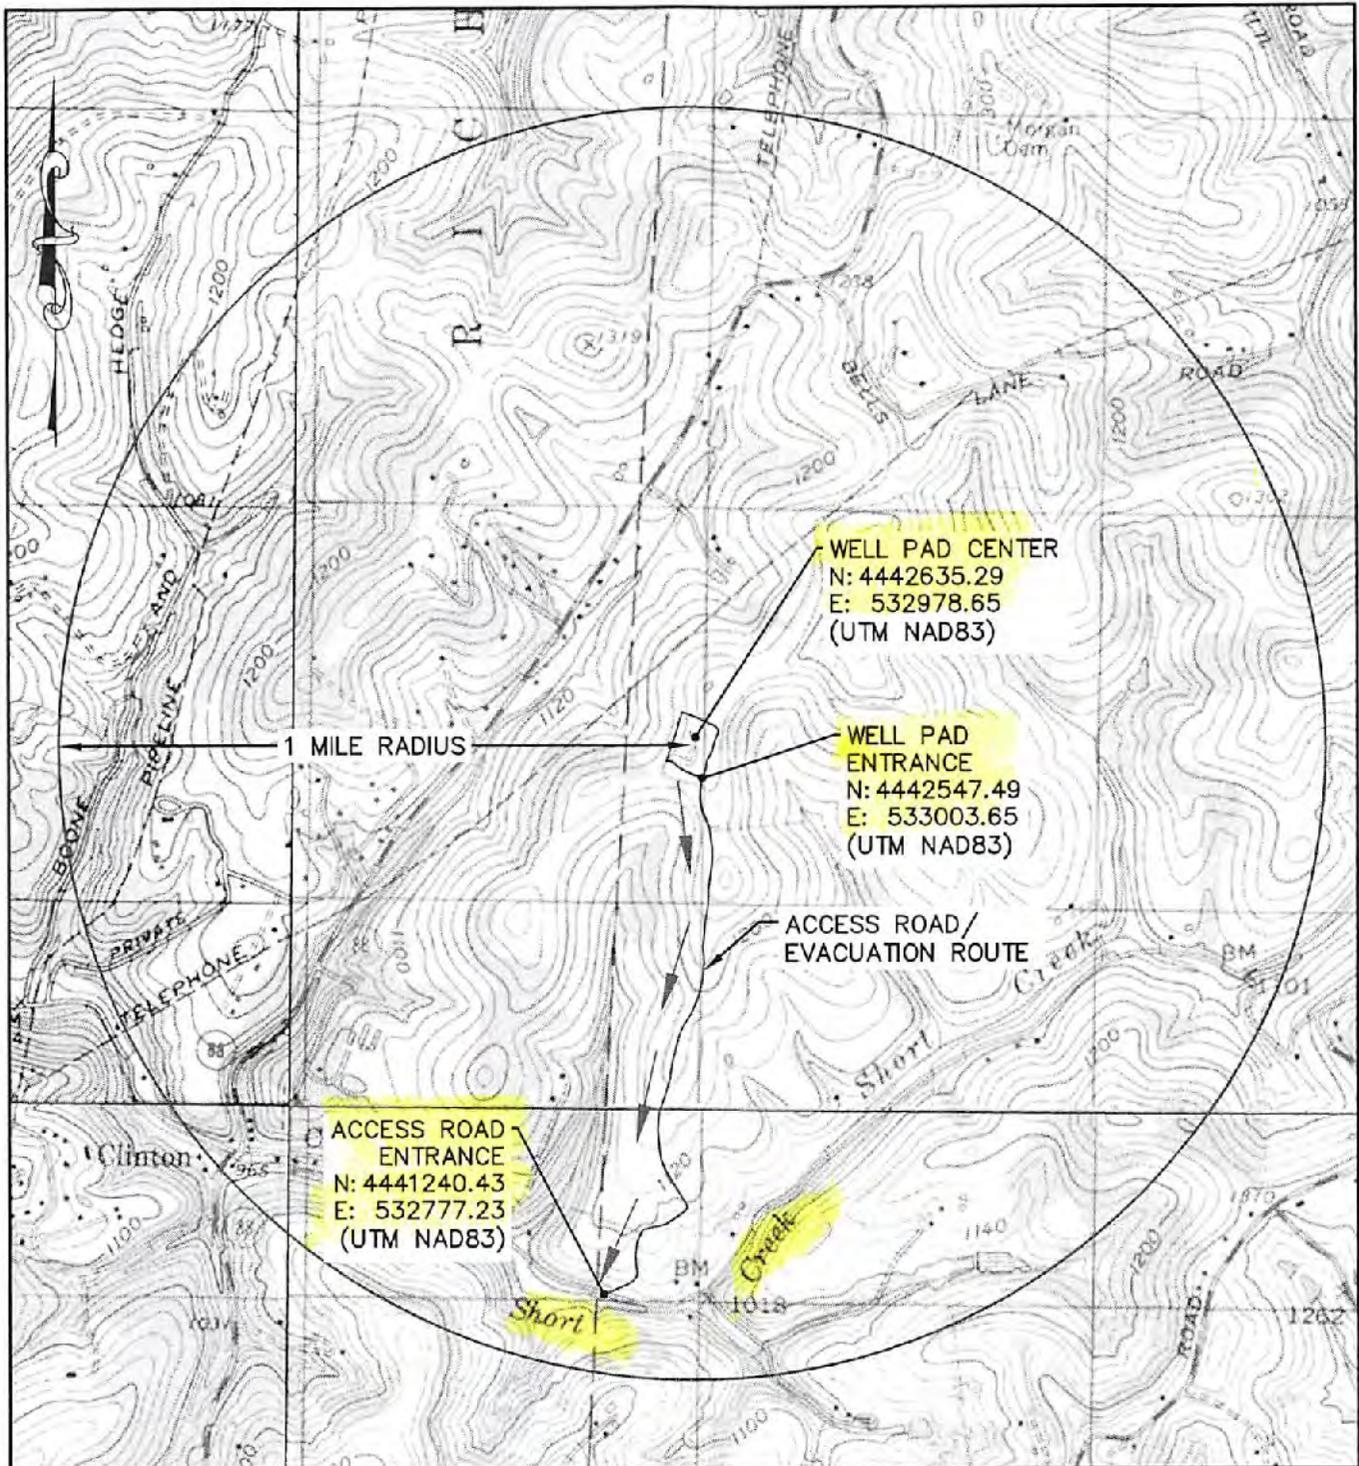

1500 0 1500 3000 FEET



SCALE





Architects Engineers Surveyors  
 1000 Commerce Park Drive • Suite 201  
 Williamsport, PA 17701  
 PHONE 570.323.6603  
 TOLL FREE 877.323.6603  
 FAX 570.323.9902  
 www.larsondesigngroup.com

DALLAS HALL OHI PAD  
 SITE SAFETY PLAN  
 1 MILE BUFFER MAP  
 OHIO COUNTY, WEST VIRGINIA  
 FOR  
 SWN PRODUCTION COMPANY, LLC

DATE: 2018-07-19  
 SHEET NO.:  
**EXH-1**  
 PROJECT NO.:  
 7688-016-011  
 SCALE:  
 AS NOTED

47-069-00281

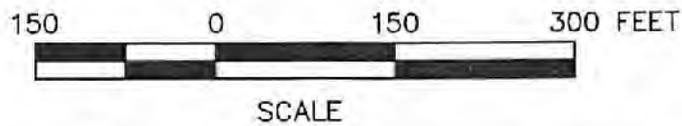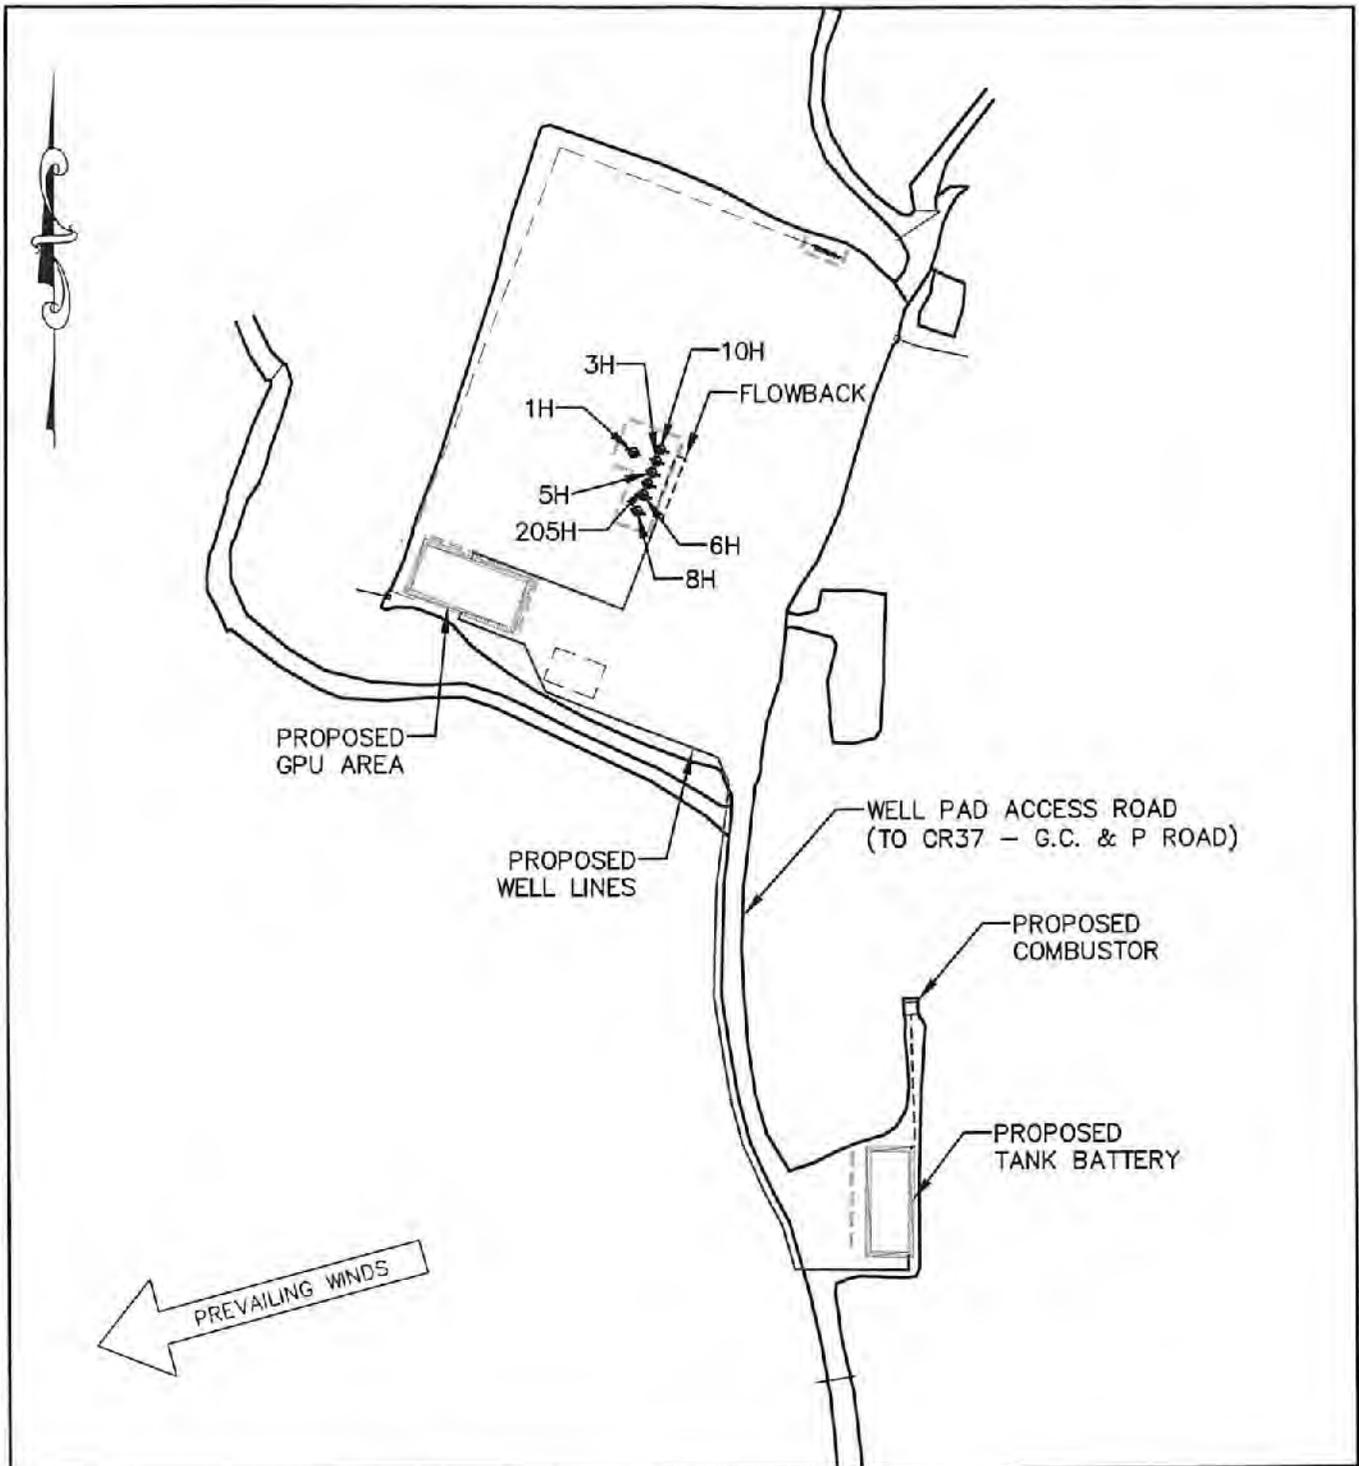

**LDC**  
Architects Engineers Surveyors  
1000 Commerce Park Drive • Suite 201  
Williamsport, PA 17701  
PHONE 570.323.6603  
TOLL FREE 877.323.6603  
FAX 570.323.9902  
www.larsondesigngroup.com

DALLAS HALL OHI PAD  
SITE SAFETY PLAN  
FLARE MAP  
OHIO COUNTY, WEST VIRGINIA  
FOR  
SWN PRODUCTION COMPANY, LLC

DATE: 2018-07-19  
SHEET NO.:  
**EXH-1**  
PROJECT NO.:  
7688-016-011  
SCALE:  
AS NOTED

08/03/2018

Latitude: 40°10'00"

SURFACE HOLE 8283'


# ELK LAKE SERVICES, LLC

280 Indian Springs Road,  
Suite 123 Indiana, PA 15701  
Phone: (724) 463-7303

Latitude: 40°10'00"

BOTTOM HOLE 648'


<b>SURFACE HOLE LOCATION (SHL):</b>
UTM (NAD83, ZONE 17, METERS):
NORTHING: 4,442,633.70
EASTING: 532,973.70
<b>LANDING POINT (LPL):</b>
UTM (NAD83, ZONE 17, METERS):
NORTHING: 4,442,666.63
EASTING: 532,589.81
<b>BOTTOM HOLE LOCATION (BHL):</b>
UTM (NAD83, ZONE 17, METERS):
NORTHING: 4,445,610.22
EASTING: 531,737.40

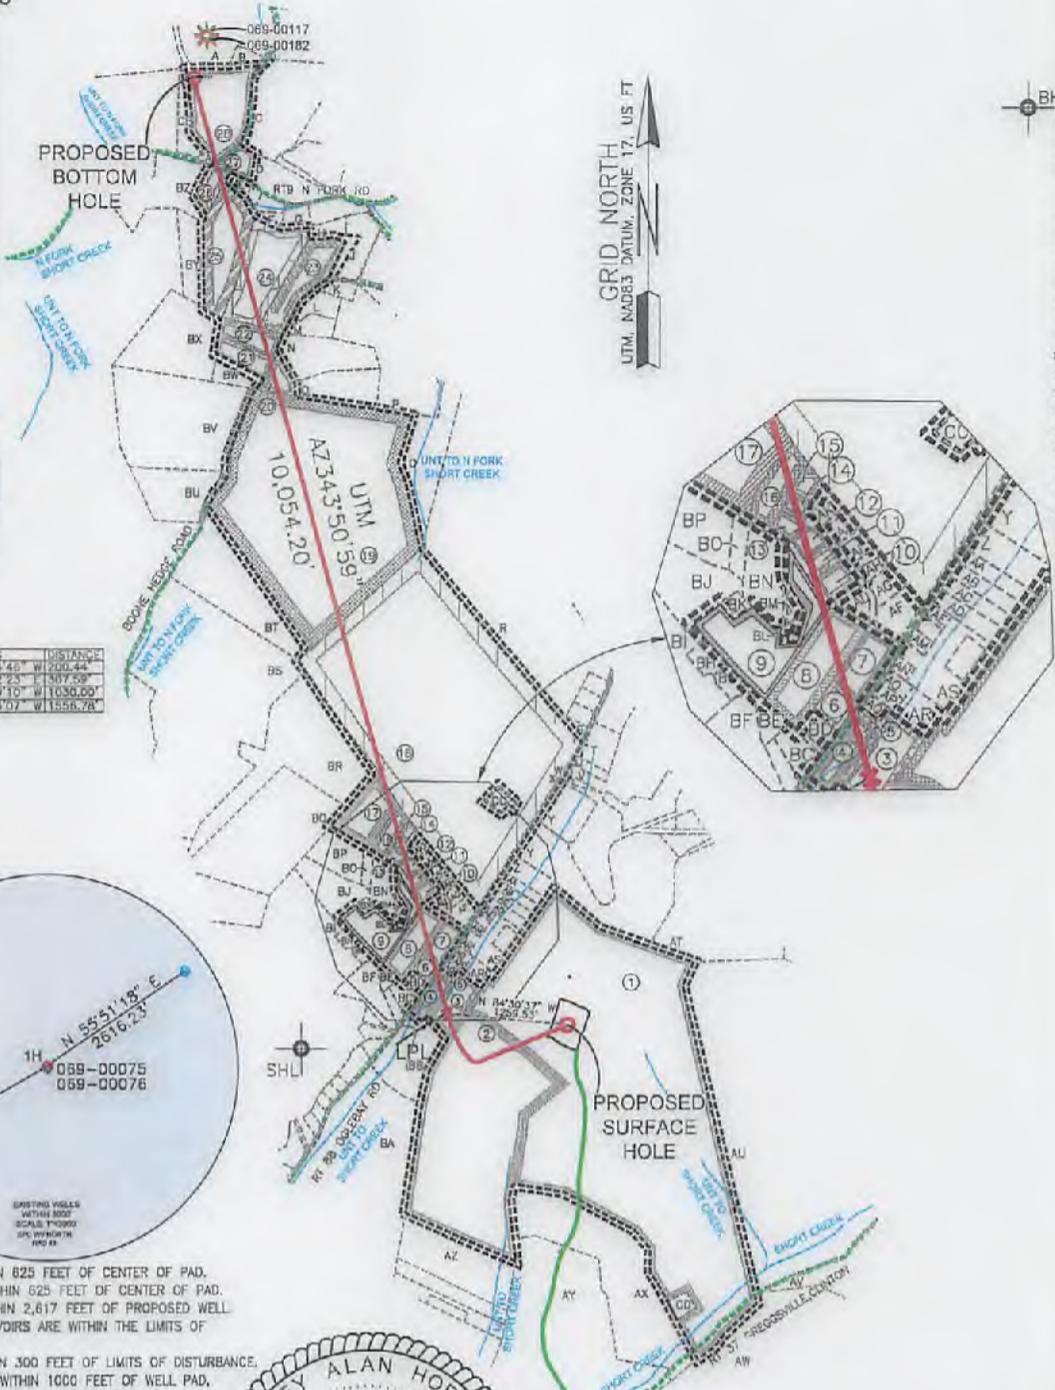



GRID NORTH  
UTM, NAD83 DATUM, ZONE 17, US FT

Longitude: 80°37'30" BOTTOM HOLE 2338'

Longitude: 80°35'00" SURFACE HOLE 12124'

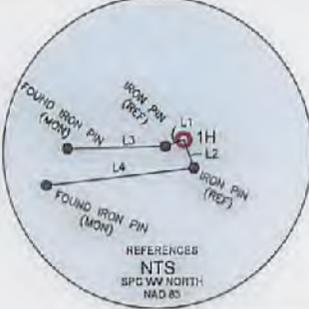

LINE/BEARING	DISTANCE
L1 S 89°14'46" W	200.44
L2 S 20°02'23" W	307.59
L3 S 86°49'10" W	1030.00
L4 S 83°15'07" W	1556.76

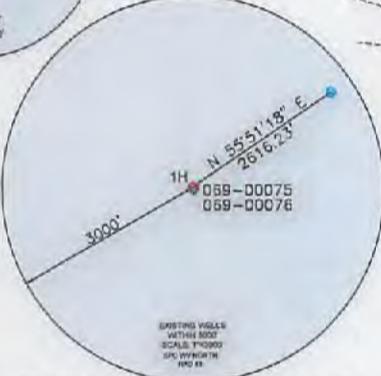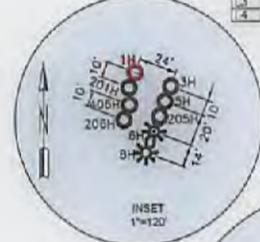

### WELL RESTRICTIONS

1. NO OCCUPIED DWELLINGS > 2500 SQ FT. WITHIN 625 FEET OF CENTER OF PAD.
2. NO AGRICULTURE BUILDINGS > 2500 SQ FT. WITHIN 625 FEET OF CENTER OF PAD.
3. WATER WELLS OR DEVELOPED SPRINGS ARE WITHIN 2,617 FEET OF PROPOSED WELL.
4. PERENNIAL STREAMS, LAKES, PONDS, OR RESERVOIRS ARE WITHIN THE LIMITS OF DISTURBANCE.
5. NO NATURALLY PRODUCING TROUT STREAM WITHIN 300 FEET OF LIMITS OF DISTURBANCE.
6. NO GROUND INTAKE OR PUBLIC WATER SUPPLY WITHIN 1000 FEET OF WELL PAD, LIMITS OF DISTURBANCE, E & S CONTROLS OR PUBLIC WATER SUPPLY.

### NOTES ON SURVEY

1. SURFACE AND ROYALTY OWNER INFORMATION AND THEIR BOUNDARIES SHOWN HEREDON WERE PLOTTED FROM DEEDS AND/OR TAX PARCEL MAPS PROVIDED BY CLIENT AND/OR FIELD LOCATIONS.
2. THIS PLAT DOES NOT REPRESENT A BOUNDARY SURVEY OF THE PARCELS SHOWN HEREDON.
3. ALL INSETS ARE GRID NORTH UNLESS OTHERWISE DEPICTED.

I, THE UNDERSIGNED, HEREBY CERTIFY THAT THIS PLAT IS CORRECT TO THE BEST OF MY KNOWLEDGE AND BELIEF AND SHOWS ALL THE INFORMATION REQUIRED BY LAW AND REGULATIONS ISSUED AND PRESCRIBED BY THE DEPARTMENT OF ENVIRONMENTAL PROTECTION.



P.S. 2164

<p>(+) DENOTES LOCATION OF WELL ON UNITED STATES TOPOGRAPHIC MAPS</p> <p>WVDEP OFFICE OF OIL &amp; GAS 601 57TH STREET CHARLESTON, WV 25034</p>	MINIMUM DEGREE OF ACCURACY: 1/200 PROVEN SOURCE OF ELEVATION: SURVEY GRADE GPS (NAVD 88, US FT)	COMPANY: <b>SWN</b> Production Company, LLC OPERATOR'S WELL #: 1H API WELL #: 47 69 00281 STATE COUNTY PERMIT
	WELL TYPE: OIL <input type="checkbox"/> WASTE DISPOSAL <input type="checkbox"/> PRODUCTION <input checked="" type="checkbox"/> DEEP <input type="checkbox"/> GAS <input checked="" type="checkbox"/> LIQUID INJECTION <input type="checkbox"/> STORAGE <input type="checkbox"/> SHALLOW <input checked="" type="checkbox"/>	WATERSHED: UPPER OHIO SOUTH DISTRICT: LIBERTY COUNTY: OHIO COUNTY SURFACE OWNER: HALL, AGNES L OIL & GAS ROYALTY OWNER: HALL, AGNES L

DRILL <input checked="" type="checkbox"/> DRILL DEEPER <input type="checkbox"/> REDRILL <input type="checkbox"/> FRACTURE OR STIMULATE <input checked="" type="checkbox"/> PLUG OFF OLD FORMATION <input type="checkbox"/> PERFORATE NEW FORMATION <input type="checkbox"/> CONVERT <input type="checkbox"/> PLUG & ABANDON <input type="checkbox"/> CLEAN OUT & REPLUG <input type="checkbox"/> OTHER CHANGE <input type="checkbox"/> (SPECIFY) _____ TARGET FORMATION: MARCELLUS	ESTIMATED DEPTH: 6,129' TMD 16,706' TMD
--	---

WELL OPERATOR: SWN PRODUCTION COMPANY, LLC ADDRESS: P.O. BOX 1300 CITY: JANE LEW STATE: WV ZIP CODE: 26378	DESIGNATED AGENT: DEE SOUTHALL ADDRESS: P.O. BOX 1300 CITY: JANE LEW STATE: WV ZIP CODE: 26378
--	--

<b>LEGEND:</b> ○ PROPOSED SURFACE HOLE / BOTTOM HOLE * EXISTING / PRODUCING WELLHEAD LPL * LANDING POINT LOCATION (W) EXISTING WATER WELL (S) EXISTING SPRING — SURVEYED BOUNDARY [---] DRILLING UNIT [---] LEASE BOUNDARY [---] PROPOSED PATH	<b>REVISIONS:</b> DATE: 05-03-2018 FILE NO: 17-033 DRAWN BY: N. LASSAK SCALE: 1" = 2000' DRAWING NO: 1 WELL LOCATION PLAT 1
---	---

08/03/2018 H16A

**ELK LAKE SERVICES, LLC**

280 Indian Springs Road,  
Suite 123 Indiana, PA 15701  
Phone: (724) 463-7303

WELL BORE TABLE FOR SURFACE / ROYALTY OWNERS		
TRACT	SURFACE OWNER / ROYALTY OWNER	TAX PARCEL
1	HALL, AGNES L	3-L7-19
2	HALL, AGNES L	3-L7-21.1
3	PYLE, JOHN R SR AND THERESA A	4-R12B-1.1
4	ERNEST, DOUGLAS J & JAMIE S	4-R12B-1.2
5	PYLE, JOHN R & THERESA A	4-R12B-5
6	WEEKS, BRADLEY & NANCY	4-R9-34.1
7	LAURELWOOD HOMEOWNERS ASSN INC	4-R9-33
8	HUGHES, DONALD P AND MARY E	4-R9-34
9	HUGHES, DONALD P & MARY E	4-R9-32
10	KANTERS, ROBERT P W AND MARGARETHA J E	4-R9-36
11	MADAMA, DENNIS	4-R9-37
12	BLAKE, EDDIE L AND JAMIE R	4-R9-38
13	BLEIFUS, BRIAN A AND MARY ANN	4-R9-39
14	CHENOWETH, JOYCE A	4-R9-40
15	LATOS, GARY S & CATHLEEN M	4-R9-41
16	PAJAK, CLARK & SHARON L	4-R9-32.1
17	PAJAK, CLARK & SHARON L	4-R9-28
18	BROWN, LILLIAN W TRUST	3-L4-1.1
19	CAVENY, CLAIRE M	4-R9-3
20	SWIGER, MARK J & DAWN S	4-R9-22.14
21	KELLAM, CHARLES R & PHYLLIS J	4-R9-22.12
22	KELLAM, CHARLES R & PHYLLIS J	4-R9-22.11
23	HALEY, RODNEY W & RHONDA L	4-R9-22.8
24	WEST, SR JAMES L AND KATHY L	4-R9-22.7
25	DELVEGCHIO, DAVID A	4-R9-22.6
26	CRUPE, TERRY LEE	4-R6-21
27	CRABTREE, RANDALL LEE	4-R6-24
28	WOOD, RICHARD A JR	4-R6-24.6

ADJOINING OWNERS TABLE		
TRACT	SURFACE OWNER	TAX PARCEL
A	RAYLE COAL COMPANY	4-R6-17.4
B	WINDSOR COAL COMPANY	4-R6-25
C	GOFF, WINDELL & GLADYS	4-R6-24.3
D	HUNT, LESLIE A	4-R6-29
E	CRUPE, JOHN D & J D	4-R6-38
F	GALLOWAY, BRANDON C & CYNTHIA A	4-R6-39.2
G	GALLOWAY, BRADON C & CYNTHIA A	4-R6-39.1
H	KLAPKA, JOSHUA M	4-R9-19
I	TAGGART, VELMA L	4-R9-18
J	BOYNES, LARRY & TERRY	4-R9-22.9
K	TAYLOR, JEFFREY C & G K	4-R9-20
L	TAYLOR, JEFFREY C & GINGER K	4-R9-22.18
M	RATCLIFFE, JOHN C & KATHY J	4-R9-22.17
N	WOOD, GEORGE E & CAROL A	4-R9-22.16
O	SWIGER, MARK J & DAWN S	4-R9-22.15
P	RATCLIFFE, JOHN C	4-R9-22.20
Q	MCKAY, PAUL M & DEBORAH A	4-R9-51
R	MCKAY, PAUL M & DEBORAH A	3-L4-1
S	BLAKE, REBECCA L	3-L4-1.7
T	MCKAY, PAUL M & DEBORAH A	3-L4-10.1
U	MCKAY, PAUL M & DEBORAH A	3-L4-10
V	ROSE, JAMES F & ANN C	3-L4-12
W	ROSE, JAMES F AND ANN C	3-L4-14
X	WEAVER, DAVID M & BETH R	3-L4-13
Y	WEAVER, DAVID M & BETH R	3-L4-15
Z	OPIC CRYSTAL	3-L4-20
AA	RUTHERS, DAVID G & LINDA F	3-L4-22
AB	STROMATOS, GEORGE	3-L4-24.2
AC	STROMATOS, GEORGE	3-L4-24.1
AD	STROMATOS, GEORGE	3-L4-24
AE	BLEND, ERIC N	4-R12B-2
AF	FRID, JAMES W & KAREN L	4-R9-47
AG	HICKEY, BRIAN P, HICKEY, JOHN P	4-R9-46
AH	SONNEFELD, DAVID W & TERRI A	4-R9-45
AI	SONNEFELD, DAVID W & TERRI A	4-R9-44
AJ	BECK, ROBERT	4-R9-43
AK	PISSOS, MARK E & J L	4-R9-42
AL	WILLIAMS, JOHN WAYNE	4-R9-35
AM	TAYLOR, DAVID L & ESTELLA ANN	4-R12B-1.7
AN	TAYLOR, DAVID L & ESTELLA ANN	4-R12B-4
AO	KOZUSNIK, MARK A	4-R12B-1.8
AP	HASTINGS, MARY ANN	4-R12B-1.4
AQ	JARVIS, WILLIAM R & SANDRA K	4-R12B-6
AR	KELLAS, STEVE	4-R12B-1.5
AS	GOSSETT, MATHEW H	4-R12B-1
AT	EVANS, CATHERINE & DAVID	3-L4-13.1
AU	CLUSER, MARY HELEN; TR	3-L7-20
AV	JONES, JAMES R & JUNE M	3-L7-18
AW	WHTAKER GEORGE & ANITA	3-L7-27
AX	HALL, DALLAS J & AGNES L	3-L7-20
AY	HALL, DALLAS J & AGNES L	3-L7-21
AZ	MEALY, MELISSA	4-R12-39
BA	WELTY, JOHN P	4-R12-35
BB	CASTLE, KEITH D	4-R12B-1.3
BC	CARTISANO, JOSEPH S & S P	4-R12-36.4
BD	PETTIE, BERNARD R	4-R12-48
BE	BURKHART, MARY J G & M J	4-R12-36.3
BF	CROFT, JAMES E & J J	4-R12-36
BG	CROFT, JAMES & JOANNE	4-R12B-1
BH	GREATHOUSE, WILLIAM J & SUSAN M	4-R12B-1.7
BI	HARTLEY, BRADFORD & NANNETTA	4-R9-1.3
BJ	HART, MARY ANN	4-R9-29.1
BK	FUNKHOUSER, DAWNA M	4-R9-32.3
BL	SHILLING, KATHY SUE H	4-R9-32.4
BM	HUFFMAN, VICKI H & D L	4-R9-32.2
BN	BENLINE, JOSEPH WAYNE	4-R9-31
BO	MILLER, JEFFREY L & CATHY	4-R9-30
BP	JOHNSON, JUDY K	4-R9-29
BQ	RCK 2 GROUP LLC	4-R9-1
BR	RCK 2 GROUP LLC	4-R9-27
BS	EVANS, LA DONNA MARTIN	4-R9-3.5
BT	WESBANCO TRUST & INVESTMENT SERVICE	4-R9-16.1
BU	MAIN, DAVID B & L M	4-R9-10
BV	MAIN, DAVID B & L M	4-R9-10.1
BX	KELLAM, CHARLES R & PHYLLIS J	4-R9-22.1
BY	MILTON, JASON D	4-R9-22.5
BZ	CRUPE, TERRY LEE	4-R6-21
CA	GODDARD, GWENDOLYN	4-R6-24.5
CB	WOOD, EDITH M	4-R6-22
CC	BROWN, ROBERT E	3-L4-1.3
CD	HALL, DALLAS J & AGNES L	3-L7-1

08/03/2018

REVISIONS:	COMPANY:	 	
	OPERATOR'S	DALLAS HALL	DATE: 05-03-2018
	WELL #:	1H	FILE NO: 17-033
	DISTRICT:	LIBERTY	DRAWN BY: N. LASSAK
	COUNTY:	OHIO COUNTY	SCALE: N/A
	STATE:	WV	DRAWING NO: 1
			WELL LOCATION PLAT 1

WW-6A1  
(5/13)

Operator's Well No. Dallas Hall OHI 1H

**INFORMATION SUPPLIED UNDER WEST VIRGINIA CODE  
Chapter 22, Article 6A, Section 5(a)(5)  
IN LIEU OF FILING LEASE(S) AND OTHER CONTINUING CONTRACT(S)**

Under the oath required to make the verification on page 1 of this Notice and Application, I depose and say that I am the person who signed the Notice and Application for the Applicant, and that -

- (1) the tract of land is the same tract described in this Application, partly or wholly depicted in the accompanying plat, and described in the Construction and Reclamation Plan;
- (2) the parties and recordation data (if recorded) for lease(s) or other continuing contract(s) by which the Applicant claims the right to extract, produce or market the oil or gas are as follows:

Lease Name or Number	Grantor, Lessor, etc.	Grantee, Lessee, etc.	Royalty	Book/Page
See Exhibit				

RECEIVED  
 Office of Oil and Gas  
 MAY 21 2018  
 WV Department of  
 Environmental Protection

**Acknowledgement of Possible Permitting/Approval  
In Addition to the Office of Oil and Gas**

The permit applicant for the proposed well work addressed in this application hereby acknowledges the possibility of the need for permits and/or approvals from local, state, or federal entities in addition to the DEP, Office of Oil and Gas, including but not limited to the following:

- WV Division of Water and Waste Management
- WV Division of Natural Resources WV Division of Highways
- U.S. Army Corps of Engineers
- U.S. Fish and Wildlife Service
- County Floodplain Coordinator

The applicant further acknowledges that any Office of Oil and Gas permit in no way overrides, replaces, or nullifies the need for other permits/approvals that may be necessary and further affirms that all needed permits/approvals should be acquired from the appropriate authority before the affected activity is initiated.

Well Operator: SWN Production Company, LLC.  
 By:   
 Its: Landman

4706000281

MAY 21 2018

WV Department of  
Environmental Protection

**Exhibit "A"**

Attached to and made a part of the State of West Virginia Oil and Gas Permit Form, WW-6A1, by SWN Production Company, LLC, Operator  
**Dallas Hall OHI 1H**  
Ohio County, West Virginia

#	TAX ID	LESSOR	LESSEE	ROYALTY	BK/PG
1	03-L7-19	Dallas J. Hall and Agnes L. Hall, husband and wife	Chesapeake Appalachia, L.L.C. SWN Production Company, LLC	18.5%	811/34 884/61
2	03-L7-21.1	Dallas J. Hall and Agnes L. Hall, husband and wife	Chesapeake Appalachia, L.L.C. SWN Production Company, LLC	18.5%	811/34 884/61
3	04-R12B-1.1	John R. Pyle Sr. and Theresa A. Pyle, husband and wife	Chesapeake Appalachia, L.L.C. SWN Production Company, LLC	18%	813/328 884/133
4	04-R12B-1.2	Douglas J. Ernest and Jamie S. Ernest, husband and wife	Chesapeake Appalachia, L.L.C. SWN Production Company, LLC	18%	831/534 884/729
5	04-R12B-5	John R. Pyle and Theresa A. Pyle, husband and wife	Chesapeake Appalachia, L.L.C. SWN Production Company, LLC	18%	813/83 884/121
6	04-R9-34.1	Bradley C. Weeks and Nancy K. Weeks, husband and wife	Chesapeake Appalachia, L.L.C. SWN Production Company, LLC	18%	817/391 884/681
7	04-R9-33	Laurel Homes of West Virginia, Inc., a/k/a Laurelwood Homeowners Association, Inc.	Chesapeake Appalachia, L.L.C. SWN Production Company, LLC	18%	814/476 884/669
8	04-R9-34	Donald P. Hughes and Mary Ellen Hughes, husband and wife	Mountaineer Natural Gas Company Chesapeake Appalachia, L.L.C. SWN Production Company, LLC	16%	832/330 862/28 885/77
9	04-R9-32	Donald P. Hughes and Mary Ellen Hughes, husband and wife	Mountaineer Natural Gas Company Chesapeake Appalachia, L.L.C. SWN Production Company, LLC	16%	832/334 862/28 885/77
10	04-R9-36	Robert P. W. Kanters and Margaretha J. E. Kanters, husband and wife	Chesapeake Appalachia, L.L.C. SWN Production Company, LLC	18%	814/378 884/445
11	04-R9-37	Dennis Madama, a single man	Chesapeake Appalachia, L.L.C. SWN Production Company, LLC	18%	815/621 884/445

**Exhibit "A"**

Attached to and made a part of the State of West Virginia Oil and Gas Permit Form, WW-6A1, by SWN Production Company, LLC, Operator  
 Dallas Hall OHI 1H  
 Ohio County, West Virginia

#	TAX ID	LESSOR	LESSEE	ROYALTY	BK/PG
12	04-R9-38	Mark K. Hayes and Rhonda J. Hayes, husband and wife	Chesapeake Appalachia, L.L.C. SWN Production Company, LLC	18%	813/182 884/133
13	04-R9-39	Brian A. Bleifus and Mary Ann Bleifus, husband and wife	Chesapeake Appalachia, L.L.C. SWN Production Company, LLC	18%	813/315 884/445
14	04-R9-40	Joyce A. Chenoweth, a widow	Chesapeake Appalachia, L.L.C. SWN Production Company, LLC	18%	816/195 884/469
15	04-R9-41	Gary S. Latos and Cathleen M. Latos, husband and wife	Chesapeake Appalachia, L.L.C. SWN Production Company, LLC	18%	816/522 884/457
16	04-R9-32.1	Clark Pajak a/k/a Clark W. Pajak and Sharon L. Pajak, husband and wife	Chesapeake Appalachia, L.L.C. SWN Production Company, LLC	18%	818/489 885/584
17	04-R9-28	Clark Pajak a/k/a Clark W. Pajak and Sharon L. Pajak, husband and wife	Chesapeake Appalachia, L.L.C. SWN Production Company, LLC	18%	818/489 885/584
18	03-L4-1.1	Robert O. Rogers, a married man dealing in his sole and separate property	SWN Production Company, LLC	18%	902/502
18	03-L4-1.1	Rome H. Brown and Lillian W. Brown, his wife	Great Lakes Energy Partners, L.L.C. Chesapeake Appalachia, L.L.C. SWN Production Company, LLC	15.5%	768/508 808/434 883/527

WV Department of  
 Environmental Protection

Dallas Hall Northwest Unit  
 2 of 4

MAY 21 2018

RECEIVED  
 Office of Oil and Gas

4706900281

**Exhibit "A"**

Attached to and made a part of the State of West Virginia Oil and Gas Permit Form, WW-6A1, by SWN Production Company, LLC, Operator  
 Dallas Hall OHI 1H  
 Ohio County, West Virginia

#	TAX ID	LESSOR	LESSEE	ROYALTY	BK/PG
12	04-R9-38	Mark K. Hayes and Rhonda J. Hayes, husband and wife	Chesapeake Appalachia, L.L.C. SWN Production Company, LLC	18%	813/182 884/133
13	04-R9-39	Brian A. Bleifus and Mary Ann Bleifus, husband and wife	Chesapeake Appalachia, L.L.C. SWN Production Company, LLC	18%	813/315 884/445
14	04-R9-40	Joyce A. Chenoweth, a widow	Chesapeake Appalachia, L.L.C. SWN Production Company, LLC	18%	816/195 884/469
15	04-R9-41	Gary S. Latos and Cathleen M. Latos, husband and wife	Chesapeake Appalachia, L.L.C. SWN Production Company, LLC	18%	816/522 884/457
16	04-R9-32.1	Clark Pajak a/k/a Clark W. Pajak and Sharon L. Pajak, husband and wife	Chesapeake Appalachia, L.L.C. SWN Production Company, LLC	18%	818/489 885/584
17	04-R9-28	Clark Pajak a/k/a Clark W. Pajak and Sharon L. Pajak, husband and wife	Chesapeake Appalachia, L.L.C. SWN Production Company, LLC	18%	818/489 885/584
18	03-L4-1.1	Robert O. Rogers, a married man dealing in his sole and separate property	SWN Production Company, LLC	18%	902/502
18	03-L4-1.1	Rome H. Brown and Lillian W. Brown, his wife	Great Lakes Energy Partners, L.L.C. Chesapeake Appalachia, L.L.C. SWN Production Company, LLC	15.5%	768/508 808/434 883/527

WV Department of  
 Environmental Protection

Dallas Hall Northwest Unit  
 2 of 4

MAY 21 2018

RECEIVED  
 Office of Oil and Gas

4706900281

**Exhibit "A"**

Attached to and made a part of the State of West Virginia Oil and Gas Permit Form, WW-6A1, by SWN Production Company, LLC, Operator  
 Dallas Hall OHI 1H  
 Ohio County, West Virginia

#	TAX ID	LESSOR	LESSEE	ROYALTY	BK/PG
18	03-L4-1.1	Ohio Valley Medical Center, Inc.; The Parks System Trust Fund of Wheeling; Children's Home of Wheeling, Inc.; Elmhurst, the House of Friendship, Inc.; Vance Memorial Presbyterian Church; Young Women's Christian Association of Wheeling, W. Va., Inc.	SWN Production Company, LLC	18%	908/708
18	03-L4-1.1	Wheeling Young Men's Christian Association	SWN Production Company, LLC	18%	926/299
19	04-R9-3	Robert O. Rogers, a married man dealing in his sole and separate property	SWN Production Company, LLC	18%	902/502
19	04-R9-3	Claire M. Caveney, a married woman dealing in her sole and separate property	Chesapeake Appalachia, L.L.C. SWN Production Company, LLC	18%	826/773 884/717
19	04-R9-3	Ohio Valley Medical Center, Inc.; The Parks System Trust Fund of Wheeling; Children's Home of Wheeling, Inc.; Elmhurst, the House of Friendship, Inc.; Vance Memorial Presbyterian Church; Young Women's Christian Association of Wheeling, W. Va., Inc.	SWN Production Company, LLC	18%	908/708
19	04-R9-3	Wheeling Young Men's Christian Association	SWN Production Company, LLC	18%	926/299
20	04-R9-22.14	Mark J. Swiger and Dawn S. Swiger, husband and wife	Chesapeake Appalachia, L.L.C. SWN Production Company, LLC	18%	817/395 884/529

MAY 21 2018

4706900281

**Exhibit "A"**

Attached to and made a part of the State of West Virginia Oil and Gas Permit Form, WW-6A1, by SWN Production Company, LLC, Operator  
**Dallas Hall OHI 1H**  
 Ohio County, West Virginia

#	TAX ID	LESSOR	LESSEE	ROYALTY	BK/PG
21	04-R9-22.12	Charles R. Kellam and Phyllis J. Kellam, his wife	Great Lakes Energy Partners, L.L.C.	12.5%	780/154
			Chesapeake Appalachia, L.L.C.		808/570
			SWN Production Company, LLC		884/169
22	04-R9-22.11	Charles R. Kellam and Phyllis J. Kellam, his wife	Great Lakes Energy Partners, L.L.C.	12.5%	780/154
			Chesapeake Appalachia, L.L.C.		808/570
			SWN Production Company, LLC		884/169
23	04-R9-22.8	Rodney W. Haley and Rhonda L. Haley, husband and wife	Chesapeake Appalachia, L.L.C.	18%	812/254
			SWN Production Company, LLC		884/181
24	04-R9-22.7	James L. West Sr. and Kathy L. West, husband and wife	Chesapeake Appalachia, L.L.C.	18%	822/366
			SWN Production Company, LLC		884/693
25	04-R9-22.6	David A. Delvecchio, a married man dealing in his sole and separate property	Chesapeake Appalachia, L.L.C.	18%	814/759
			SWN Production Company, LLC		884/193
26	04-R6-21	Heidi M. Twaddle, a single woman	Chesapeake Appalachia, L.L.C.	18%	811/792
			SWN Production Company, LLC		884/169
27	04-R6-24	Randall Crabtree a/k/a Randall Lee Crabtree, a single man	SWN Production Company, LLC	16%	920/610
28	04-R6-24.6	Richard Allen Wood, Jr., a married man dealing in his sole and separate property	Chesapeake Appalachia, L.L.C.	18%	811/420
			SWN Production Company, LLC		884/157

RECEIVED  
 Office of Oil and Gas  
 MAY 21 2018  
 WV Department of  
 Environmental Protection

4706900281



SWN Production Company, LLC  
P.O. Box 12359  
Spring, Texas 77391-2359  
www.swn.com

May 8, 2018

Ms. Laura Adkins  
WV DEP Office of Oil & Gas  
601 57<sup>th</sup> St., SE  
Charleston, WV 25304

**RE:** SWN's proposed New Well: Dallas Hall OHI 1H in Ohio County, West Virginia, Drilling under RT9 Fork Road, Boone Hedge Road, and RT 88 Oglebay Road.

Dear Ms. Adkins:

SWN Production Company, LLC ("SWN") is applying for a drilling permit for the above referenced well. The State of West Virginia has raised some concern as to SWN's right to drill under RT9 Fork Road, Boone Hedge Road, and RT 88 Oglebay Road. Please be advised that SWN has leased all mineral owners under said route as it relates to the above-referenced well and unit.

Thank you.

Sincerely,

Bradley Wilson  
Landman  
SWN Production Company, LLC  
PO Box 12359  
Spring, TX 77391-2359

RECEIVED  
Office of Oil and Gas  
MAY 21 2018  
WV Department of  
Environmental Protection



10000 Energy Drive  
Spring, TX 77389-4854

The Right People doing the Right Things.  
Wisely Investing the cash flow from our  
underlying Assets, will create Value.<sup>®</sup>

MAY 21 2018

WW-6AC  
(1/12)

**STATE OF WEST VIRGINIA**  
**DEPARTMENT OF ENVIRONMENTAL PROTECTION, OFFICE OF OIL AND GAS**  
NOTICE CERTIFICATION

Department of  
Environmental Protection

Date of Notice Certification:

5/18/18

API No. 47- 069 -

Operator's Well No. Dallas Hall OHI 1H

Well Pad Name: Dallas Hall OHI Pad

**Notice has been given:**

Pursuant to the provisions in West Virginia Code § 22-6A, the Operator has provided the required parties with the Notice Forms listed below for the tract of land as follows:

State:	West Virginia	UTM NAD 83	Eastings:	532974
County:	069-Ohio		Northing:	4442634
District:	Liberty	Public Road Access:	G C & P Road	
Quadrangle:	Bethany	Generally used farm name:	Dallas Hall	
Watershed:	Upper Ohio South			

Pursuant to West Virginia Code § 22-6A-7(b), every permit application filed under this section shall be on a form as may be prescribed by the secretary, shall be verified and shall contain the following information: (14) A certification from the operator that (i) it has provided the owners of the surface described in subdivisions (1), (2) and (4), subsection (b), section ten of this article, the information required by subsections (b) and (c), section sixteen of this article; (ii) that the requirement was deemed satisfied as a result of giving the surface owner notice of entry to survey pursuant to subsection (a), section ten of this article six-a; or (iii) the notice requirements of subsection (b), section sixteen of this article were waived in writing by the surface owner; and Pursuant to West Virginia Code § 22-6A-11(b), the applicant shall tender proof of and certify to the secretary that the notice requirements of section ten of this article have been completed by the applicant.

Pursuant to West Virginia Code § 22-6A, the Operator has attached proof to this Notice Certification that the Operator has properly served the required parties with the following:

\*PLEASE CHECK ALL THAT APPLY

1. NOTICE OF SEISMIC ACTIVITY or  NOTICE NOT REQUIRED BECAUSE NO SEISMIC ACTIVITY WAS CONDUCTED
2. NOTICE OF ENTRY FOR PLAT SURVEY or  NO PLAT SURVEY WAS CONDUCTED
3. NOTICE OF INTENT TO DRILL or  NOTICE NOT REQUIRED BECAUSE NOTICE OF ENTRY FOR PLAT SURVEY WAS CONDUCTED or
- WRITTEN WAIVER BY SURFACE OWNER (PLEASE ATTACH)
4. NOTICE OF PLANNED OPERATION
5. PUBLIC NOTICE
6. NOTICE OF APPLICATION

OOG OFFICE USE  
ONLY

- RECEIVED/  
NOT REQUIRED
- RECEIVED
- RECEIVED/  
NOT REQUIRED
- RECEIVED
- RECEIVED
- RECEIVED

**Required Attachments:**

The Operator shall attach to this Notice Certification Form all Notice Forms and Certifications of Notice that have been provided to the required parties and/or any associated written waivers. For the Public Notice, the operator shall attach a copy of the Class II Legal Advertisement with publication date verification or the associated Affidavit of Publication. The attached Notice Forms and Certifications of Notice shall serve as proof that the required parties have been noticed as required under West Virginia Code § 22-6A. Pursuant to West Virginia Code § 22-6A-11(b), the Certification of Notice to the person may be made by affidavit of personal service, the return receipt card or other postal receipt for certified mailing.


08/03/2018

WW-6AC  
(1/12)

**Certification of Notice is hereby given:**

THEREFORE, I Dee Southall, have read and understand the notice requirements within West Virginia Code § 22-6A. I certify that as required under West Virginia Code § 22-6A, I have served the attached copies of the Notice Forms, identified above, to the required parties through personal service, by registered mail or by any method of delivery that requires a receipt or signature confirmation. I certify under penalty of law that I have personally examined and am familiar with the information submitted in this Notice Certification and all attachments, and that based on my inquiry of those individuals immediately responsible for obtaining the information, I believe that the information is true, accurate and complete. I am aware that there are significant penalties for submitting false information, including the possibility of fine and imprisonment.

Well Operator:	<u>SWN Production Co., LLC</u>	Address:	<u>P.O. Box 1300</u>
By:	<u>Dee Southall</u>		<u>Jane Lew, WV 26378</u>
Its:	<u>Senior Regulatory Analyst</u>	Facsimile:	<u>304-884-1690</u>
Telephone:	<u>304-884-1614</u>	Email:	<u>Dee_Southall@swn.com</u>

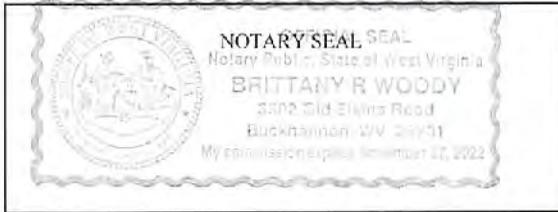

Subscribed and sworn before me this 30<sup>th</sup> day of April 2018.  
Brittany R. Woody Notary Public  
 My Commission Expires 11/27/2022

**Oil and Gas Privacy Notice:**

The Office of Oil and Gas processes your personal information, such as name, address and telephone number, as part of our regulatory duties. Your personal information may be disclosed to other State agencies or third parties in the normal course of business or as needed to comply with statutory or regulatory requirements, including Freedom of Information Act requests. Our office will appropriately secure your personal information. If you have any questions about our use or your personal information, please contact DEP's Chief Privacy Officer at [depprivacyofficer@wv.gov](mailto:depprivacyofficer@wv.gov).

RECEIVED  
 Office of Oil and Gas  
 MAY 21 2018  
 WV Department of  
 Environmental Protection

**STATE OF WEST VIRGINIA  
DEPARTMENT OF ENVIRONMENTAL PROTECTION, OFFICE OF OIL AND GAS  
NOTICE OF APPLICATION**

**Notice Time Requirement:** notice shall be provided no later than the **filing date of permit application.**

**Date of Notice:** 5/18/18 **Date Permit Application Filed:** 5/18/18

**Notice of:**

- PERMIT FOR ANY WELL WORK
- CERTIFICATE OF APPROVAL FOR THE CONSTRUCTION OF AN IMPOUNDMENT OR PIT

**Delivery method pursuant to West Virginia Code § 22-6A-10(b)**

- PERSONAL SERVICE
- REGISTERED MAIL
- METHOD OF DELIVERY THAT REQUIRES A RECEIPT OR SIGNATURE CONFIRMATION

RECEIVED  
Office of Oil and Gas  
MAY 21 2018  
WV Department of  
Environmental Protection

Pursuant to W. Va. Code § 22-6A-10(b) no later than the filing date of the application, the applicant for a permit for any well work or for a certificate of approval for the construction of an impoundment or pit as required by this article shall deliver, by personal service or by registered mail or by any method of delivery that requires a receipt or signature confirmation, copies of the application, the erosion and sediment control plan required by section seven of this article, and the well plat to each of the following persons: (1) The owners of record of the surface of the tract on which the well is or is proposed to be located; (2) The owners of record of the surface tract or tracts overlying the oil and gas leasehold being developed by the proposed well work, if the surface tract is to be used for roads or other land disturbance as described in the erosion and sediment control plan submitted pursuant to subsection (c), section seven of this article; (3) The coal owner, operator or lessee, in the event the tract of land on which the well proposed to be drilled is located [sic] is known to be underlain by one or more coal seams; (4) The owners of record of the surface tract or tracts overlying the oil and gas leasehold being developed by the proposed well work, if the surface tract is to be used for the placement, construction, enlargement, alteration, repair, removal or abandonment of any impoundment or pit as described in section nine of this article; (5) Any surface owner or water purveyor who is known to the applicant to have a water well, spring or water supply source located within one thousand five hundred feet of the center of the well pad which is used to provide water for consumption by humans or domestic animals; and (6) The operator of any natural gas storage field within which the proposed well work activity is to take place. (c)(1) If more than three tenants in common or other co-owners of interests described in subsection (b) of this section hold interests in the lands, the applicant may serve the documents required upon the person described in the records of the sheriff required to be maintained pursuant to section eight, article one, chapter eleven-a of this code. (2) Notwithstanding any provision of this article to the contrary, notice to a lien holder is not notice to a landowner, unless the lien holder is the landowner. W. Va. Code R. § 35-8-5.7.a requires, in part, that the operator shall also provide the Well Site Safety Plan ("WSSP") to the surface owner and any water purveyor or surface owner subject to notice and water testing as provided in section 15 of this rule.

Application Notice  WSSP Notice  E&S Plan Notice  Well Plat Notice is hereby provided to:

SURFACE OWNER(s)  
Name: Agnes L. Hall  
Address: 1953 G C and P Road  
Triadelphia, WV 26059

Name: \_\_\_\_\_  
Address: \_\_\_\_\_

SURFACE OWNER(s) (Road and/or Other Disturbance)

Name: \_\_\_\_\_  
Address: \_\_\_\_\_

Name: \_\_\_\_\_  
Address: \_\_\_\_\_

SURFACE OWNER(s) (Impoundments or Pits)

Name: \_\_\_\_\_  
Address: \_\_\_\_\_

COAL OWNER OR LESSEE  
Name: Alliance Resources, GP LLC, Attn: Evan Midler  
Address: 2596 Battle Run Road  
Triadelphia, WV 26059

COAL OPERATOR  
Name: \_\_\_\_\_  
Address: \_\_\_\_\_

SURFACE OWNER OF WATER WELL AND/OR WATER PURVEYOR(s)  
Name: none  
Address: \_\_\_\_\_

OPERATOR OF ANY NATURAL GAS STORAGE FIELD

Name: \_\_\_\_\_  
Address: \_\_\_\_\_

\*Please attach additional forms if necessary

STATE OF WEST VIRGINIA  
DEPARTMENT OF ENVIRONMENTAL PROTECTION, OFFICE OF OIL AND GAS  
NOTICE OF APPLICATION

Notice Time Requirement: notice shall be provided no later than the filing date of permit application.

Date of Notice 5/18/18 Date Permit Application Filed 5/18/18

Notice of:

- PERMIT FOR ANY WELL WORK
- CERTIFICATE OF APPROVAL FOR THE CONSTRUCTION OF AN IMPOUNDMENT OR PIT

Delivery method pursuant to West Virginia Code § 22-6A-10(b)

- PERSONAL SERVICE
- REGISTERED MAIL
- METHOD OF DELIVERY THAT REQUIRES A RECEIPT OR SIGNATURE CONFIRMATION

Pursuant to W. Va. Code § 22-6A-10(b) no later than the filing date of the application, the applicant for a permit for any well work or for a certificate of approval for the construction of an impoundment or pit as required by this article shall deliver, by personal service or by registered mail or by any method of delivery that requires a receipt or signature confirmation, copies of the application, the erosion and sediment control plan required by section seven of this article, and the well plat to each of the following persons: (1) The owners of record of the surface of the tract on which the well is or is proposed to be located; (2) The owners of record of the surface tract or tracts overlying the oil and gas leasehold being developed by the proposed well work, if the surface tract is to be used for roads or other land disturbance as described in the erosion and sediment control plan submitted pursuant to subsection (c), section seven of this article; (3) The coal owner, operator or lessee, in the event the tract of land on which the well proposed to be drilled is located [sic] is known to be underlain by one or more coal seams; (4) The owners of record of the surface tract or tracts overlying the oil and gas leasehold being developed by the proposed well work, if the surface tract is to be used for the placement, construction, enlargement, alteration, repair, removal or abandonment of any impoundment or pit as described in section nine of this article; (5) Any surface owner or water purveyor who is known to the applicant to have a water well, spring or water supply source located within one thousand five hundred feet of the center of the well pad which is used to provide water for consumption by humans or domestic animals; and (6) The operator of any natural gas storage field within which the proposed well work activity is to take place. (c)(1) If more than three tenants in common or other co-owners of interests described in subsection (b) of this section hold interests in the lands, the applicant may serve the documents required upon the person described in the records of the sheriff required to be maintained pursuant to section eight, article one, chapter eleven-a of this code. (2) Notwithstanding any provision of this article to the contrary, notice to a lien holder is not notice to a landowner, unless the lien holder is the landowner. W. Va. Code R. § 35-8-5.7.a requires, in part, that the operator shall also provide the Well Site Safety Plan ("WSSP") to the surface owner and any water purveyor or surface owner subject to notice and water testing as provided in section 15 of this rule.

Application Notice  WSSP Notice  E&S Plan Notice  Well Plat Notice is hereby provided to:

SURFACE OWNER(s)  
Name: \_\_\_\_\_  
Address: \_\_\_\_\_  
Name: \_\_\_\_\_  
Address: \_\_\_\_\_

COAL OWNER OR LESSEE  
Name: Windsor Coal Company  
Address: 1000 Consol Energy Drive  
Canonsburg, PA 15317

COAL OPERATOR  
Name: \_\_\_\_\_  
Address: \_\_\_\_\_

SURFACE OWNER(s) (Road and/or Other Disturbance)  
Name: \_\_\_\_\_  
Address: \_\_\_\_\_  
Name: \_\_\_\_\_  
Address: \_\_\_\_\_

SURFACE OWNER OF WATER WELL AND/OR WATER PURVEYOR(s)  
Name: \_\_\_\_\_  
Address: \_\_\_\_\_

SURFACE OWNER(s) (Impoundments or Pits)  
Name: \_\_\_\_\_  
Address: \_\_\_\_\_

OPERATOR OF ANY NATURAL GAS STORAGE FIELD  
Name: \_\_\_\_\_  
Address: \_\_\_\_\_

\*Please attach additional forms if necessary

RECEIVED  
Office of Oil and Gas  
MAY 21 2018  
WV Department of Environmental Protection

WW-6A  
(8-13)

RECEIVED  
Office of Oil and Gas

API NO. 47-069 -  
OPERATOR WELL NO. Dallas Hall OHI 1H  
Well Pad Name: Dallas Hall OHI Pad

**Notice is hereby given:**

Pursuant to West Virginia Code § 22-6A-10(b), notice is hereby given that the undersigned well operator has applied for a permit for well work or for a certificate of approval for the construction of an impoundment or pit.

MAY 21 2018

WV Department of  
Environmental Protection

**This Notice Shall Include:**

Pursuant to W. Va. Code § 22-6A-10(b), this notice shall include: (1) copies of the application; (2) the erosion and sediment control plan required by section seven of this article; and (3) the well plat.

Pursuant to W. Va. Code § 22-6A-10(f), this notice shall include: (1) a statement of the time limits for filing written comments; (2) who may file written comments; (3) the name and address of the secretary for the purpose of filing the comments and obtaining additional information; and (4) a statement that the persons may request, at the time of submitting written comments, notice of the permit decision and a list of persons qualified to test water.

Pursuant to W. Va. Code R. § 35-8-5.7.a, the operator shall provide the Well Site Safety Plan to the surface owner and any water purveyor or surface owner subject to notice and water testing as provided in section 15 of this rule.

Pursuant to W. Va. Code R. § 35-8-15.2.c, this notice shall: (1) contain a statement of the surface owner's and water purveyor's right to request sampling and analysis; (2) advise the surface owner and water purveyor of the rebuttable presumption for contamination or deprivation of a fresh water source or supply; advise the surface owner and water purveyor that refusal to allow the operator to conduct a pre-drilling water well test constitutes a method to rebut the presumption of liability; (3) advise the surface owner and water purveyor of his or her independent right to sample and analyze any water supply at his or her own expense; advise the surface owner and water purveyor whether or not the operator will utilize an independent laboratory to analyze any sample; and (4) advise the surface owner and or water purveyor that he or she can obtain from the Chief a list of water testing laboratories in the subject area capable of and qualified to test water supplies in accordance with standard acceptable methods.

Additional information related to horizontal drilling may be obtained from the Secretary, at the WV Department of Environmental Protection headquarters, located at 601 57<sup>th</sup> Street, SE, Charleston, WV 25304 (304-926-0450) or by visiting [www.dep.wv.gov/oil-and-gas/pages/default.aspx](http://www.dep.wv.gov/oil-and-gas/pages/default.aspx).

**Well Location Restrictions**

Pursuant to W. Va. Code § 22-6A-12, Wells may not be drilled within two hundred fifty feet measured horizontally from any existing water well or developed spring used for human or domestic animal consumption. The center of well pads may not be located within six hundred twenty-five feet of an occupied dwelling structure, or a building two thousand five hundred square feet or larger used to house or shelter dairy cattle or poultry husbandry. This limitation is applicable to those wells, developed springs, dwellings or agricultural buildings that existed on the date a notice to the surface owner of planned entry for surveying or staking as provided in section ten of this article or a notice of intent to drill a horizontal well as provided in subsection (b), section sixteen of this article was provided, whichever occurs first, and to any dwelling under construction prior to that date. This limitation may be waived by written consent of the surface owner transmitted to the department and recorded in the real property records maintained by the clerk of the county commission for the county in which such property is located. Furthermore, the well operator may be granted a variance by the secretary from these distance restrictions upon submission of a plan which identifies the sufficient measures, facilities or practices to be employed during well site construction, drilling and operations. The variance, if granted, shall include terms and conditions the department requires to ensure the safety and protection of affected persons and property. The terms and conditions may include insurance, bonding and indemnification, as well as technical requirements. (b) No well pad may be prepared or well drilled within one hundred feet measured horizontally from any perennial stream, natural or artificial lake, pond or reservoir, or a wetland, or within three hundred feet of a naturally reproducing trout stream. No well pad may be located within one thousand feet of a surface or ground water intake of a public water supply. The distance from the public water supply as identified by the department shall be measured as follows: (1) For a surface water intake on a lake or reservoir, the distance shall be measured from the boundary of the lake or reservoir. (2) For a surface water intake on a flowing stream, the distance shall be measured from a semicircular radius extending upstream of the surface water intake. (3) For a groundwater source, the distance shall be measured from the wellhead or spring. The department may, in its discretion, waive these distance restrictions upon submission of a plan identifying sufficient measures, facilities or practices to be employed during well site construction, drilling and operations to protect the waters of the state. A waiver, if granted, shall impose any permit conditions as the secretary considers necessary. (c) Notwithstanding the foregoing provisions of this section, nothing contained in this section prevents an operator from conducting the activities permitted or authorized by a Clean Water Act Section 404 permit or other approval from the United States Army Corps of Engineers within any waters of the state or within the restricted areas referenced in this section. (d) The well location restrictions set forth in this section shall not apply to any well on a multiple well pad if at least one of the wells was permitted prior to the effective date of this article. (e) The secretary shall, by December 31, 2012, report to the Legislature on the noise, light, dust and volatile organic compounds generated by the drilling of horizontal wells as they relate to the well location restrictions regarding occupied dwelling structures pursuant to this section. Upon a finding, if any, by the secretary that the well location restrictions regarding occupied dwelling structures are inadequate or otherwise require alteration to address the items

08/03/2018

WW-6A  
(8-13)

RECEIVED  
Office of Oil and Gas

API NO. 47-069 -  
OPERATOR WELL NO. Dallas Hall OHI 1H  
Well Pad Name: Dallas Hall OHI Pad

MAY 21 2018

examined in the study required by this subsection, the secretary shall have the authority to propose for promulgation legislative rules establishing guidelines and procedures regarding reasonable levels of noise, light, dust and volatile organic compounds relating to drilling horizontal wells, including reasonable means of mitigating such factors, as necessary.

**Water Well Testing:**

Pursuant to West Virginia Code § 22-6A-10(d), notification shall be made, with respect to surface landowners identified in subsection (b) or water purveyors identified in subdivision (5), subsection (b) of this section, of the opportunity for testing their water well. The operator shall provide an analysis to such surface landowner or water purveyor at their request.

**Water Testing Laboratories:**

Pursuant to West Virginia Code § 22-6A-10(i), persons entitled to notice pursuant to subsection (b) of this section may contact the department to ascertain the names and locations of water testing laboratories in the subject area capable and qualified to test water supplies in accordance with standard accepted methods. In compiling that list of names the department shall consult with the state Bureau for Public Health and local health departments. A surface owner and water purveyor has an independent right to sample and analyze any water supply at his or her own expense. The laboratory utilized by the operator shall be approved by the agency as being certified and capable of performing sample analyses in accordance with this section.

**Rebuttable Presumption for Contamination or Deprivation of a Fresh Water Source or Supply:**

W. Va. Code § 22-6A-18 requires that (b) unless rebutted by one of the defenses established in subsection (c) of this section, in any action for contamination or deprivation of a fresh water source or supply within one thousand five hundred feet of the center of the well pad for horizontal well, there is a rebuttable presumption that the drilling and the oil or gas well or either was the proximate cause of the contamination or deprivation of the fresh water source or supply. (c) In order to rebut the presumption of liability established in subsection (b) of this section, the operator must prove by a preponderance of the evidence one of the following defenses: (1) The pollution existed prior to the drilling or alteration activity as determined by a predrilling or prealteration water well test. (2) The landowner or water purveyor refused to allow the operator access to the property to conduct a predrilling or prealteration water well test. (3) The water supply is not within one thousand five hundred feet of the well. (4) The pollution occurred more than six months after completion of drilling or alteration activities. (5) The pollution occurred as the result of some cause other than the drilling or alteration activity. (d) Any operator electing to preserve its defenses under subdivision (1), subsection (c) of this section shall retain the services of an independent certified laboratory to conduct the predrilling or prealteration water well test. A copy of the results of the test shall be submitted to the department and the surface owner or water purveyor in a manner prescribed by the secretary. (e) Any operator shall replace the water supply of an owner of interest in real property who obtains all or part of that owner's supply of water for domestic, agricultural, industrial or other legitimate use from an underground or surface source with a comparable water supply where the secretary determines that the water supply has been affected by contamination, diminution or interruption proximately caused by the oil or gas operation, unless waived in writing by that owner. (f) The secretary may order the operator conducting the oil or gas operation to: (1) Provide an emergency drinking water supply within twenty-four hours; (2) Provide temporary water supply within seventy-two hours; (3) Within thirty days begin activities to establish a permanent water supply or submit a proposal to the secretary outlining the measures and timetables to be used in establishing a permanent supply. The total time in providing a permanent water supply may not exceed two years. If the operator demonstrates that providing a permanent replacement water supply cannot be completed within two years, the secretary may extend the time frame on case-by-case basis; and (4) Pay all reasonable costs incurred by the real property owner in securing a water supply. (g) A person as described in subsection (b) of this section aggrieved under the provisions of subsections (b), (e) or (f) of this section may seek relief in court... (i) Notwithstanding the denial of the operator of responsibility for the damage to the real property owner's water supply or the status of any appeal on determination of liability for the damage to the real property owner's water supply, the operator may not discontinue providing the required water service until authorized to do so by the secretary or a court of competent jurisdiction.

**Written Comment:**

Pursuant to West Virginia Code § 22-6A-11(a), all persons described in subsection (b), section ten of this article may file written comments with the secretary as to the location or construction of the applicant's proposed well work within thirty days after the application is filed with the secretary. All persons described in West Virginia Code § 22-6A-10(b) may file written comments as to the location or construction of the applicant's proposed well work to the Secretary at:

Chief, Office of Oil and Gas  
Department of Environmental Protection  
601 57<sup>th</sup> St. SE  
Charleston, WV 25304  
(304) 926-0450

Such persons may request, at the time of submitting written comments, notice of the permit decision and a list of persons qualified to test water. **NOTE: YOU ARE NOT REQUIRED TO FILE ANY COMMENT.**

**Time Limits and Methods for Filing Comments.**

The law requires these materials to be served on or before the date the operator files its Application. You have **THIRTY (30) DAYS** after the filing date to file your comments. Comments must be filed in person or received in the mail by the Chief's office by the time stated above. You may call the Chief's office to be sure of the date. Check with your postmaster to ensure adequate delivery time or to arrange special expedited handling. If you have been contacted by the well operator and you have signed a "voluntary statement of no objection" to the planned work described in these materials, then the permit may be issued at any time.

Pursuant to West Virginia Code § 22-6A-11(c)(2), Any objections of the affected coal operators and coal seam owners and lessees shall be addressed through the processes and procedures that exist under sections fifteen, seventeen and forty, article six of this chapter, as applicable and as incorporated into this article by section five of this article. The written comments filed by the parties entitled to notice under subdivisions (1), (2), (4), (5) and (6), subsection (b), section ten of this article shall be considered by the secretary in the permit issuance process, but the parties are not entitled to participate in the processes and proceedings that exist under sections fifteen, seventeen or forty, article six of this chapter, as applicable and as incorporated into this article by section five of this article.

**Comment Requirements**

Your comments must be in writing and include your name, address and telephone number, the well operator's name and well number and the approximate location of the proposed well site including district and county from the application. You may add other documents, such as sketches, maps or photographs to support your comments.

Disclaimer: All comments received will be placed on our web site <http://www.dep.wv.gov/oil-and-gas/Horizontal-Permits/Pages/default.aspx> and the applicant will automatically be forwarded an email notice that such comments have been submitted. The applicant will be expected to provide a response to comments submitted by any surface owner, water purveyor or natural gas storage operator noticed within the application.

**Permit Denial or Condition**

The Chief has the power to deny or condition a well work permit. Pursuant to West Virginia Code § 22-6A-8(d), the permit may not be issued or be conditioned, including conditions with respect to the location of the well and access roads prior to issuance if the director determines that:

- (1) The proposed well work will constitute a hazard to the safety of persons;
- (2) The plan for soil erosion and sediment control is not adequate or effective;
- (3) Damage would occur to publicly owned lands or resources; or
- (4) The proposed well work fails to protect fresh water sources or supplies.

A permit may also be denied under West Virginia Code § 22-6A-7(k), the secretary shall deny the issuance of a permit if the secretary determines that the applicant has committed a substantial violation of a previously issued permit for a horizontal well, including the applicable erosion and sediment control plan associated with the previously issued permit, or a substantial violation of one or more of the rules promulgated under this article, and in each instance has failed to abate or seek review of the violation within the time prescribed by the secretary pursuant to the provisions of subdivisions (1) and (2), subsection (a), section five of this article and the rules promulgated hereunder, which time may not be unreasonable.

Pursuant to West Virginia Code § 22-6A-10(g), any person entitled to submit written comments to the secretary pursuant to subsection (a), section eleven of this article, shall also be entitled to receive from the secretary a copy of the permit as issued or a copy of the order modifying or denying the permit if the person requests receipt of them as a part of the written comments submitted concerning the permit application. Such persons may request, at the time of submitting written comments, notice of the permit decision and a list of persons qualified to test water.

RECEIVED  
Office of Oil and Gas  
MAY 21 2018  
WV Department of  
Environmental Protection

4706900281

PARCEL_ID	OWNER	ADDRESS	CITY_STATE_ZIP	WATERSOURCES
03 L7001900000000	HALL DALLAS J & AGNES L	1953 G C AND P RD	TRIADELPHIA WV 26059	<input checked="" type="checkbox"/>
04 R12B000100010000	PYLE JOHN R SR & T A	4042 OGLEBAY DR	WHEELING WV 26003	<input checked="" type="checkbox"/>
03 L4002200000000	RUTHERS DAVID G & LINDA F	4196 OGLEBAY DR	WHEELING WV 26003	<input checked="" type="checkbox"/>
03 L4002000000000	OPIC CRYSTAL	112 AVALON EST	WHEELING WV 26003	<input checked="" type="checkbox"/>

RECEIVED  
Office of Oil and Gas  
MAY 21 2018  
WV Department of  
Environmental Protection

08/03/2018

WW-6A  
(8-13)

API NO. 47-069 -  
OPERATOR WELL NO. Dallas Hall OHI 1H  
Well Pad Name: Dallas Hall OHI Pad


**Notice is hereby given by:**

Well Operator: SWN Production Co., LLC  
Telephone: 304-884-1614  
Email: Dee\_Southall@swn.com

Address: P.O. Box 1300  
Jane Lew, WV 26378  
Facsimile: 304-884-1690

**Oil and Gas Privacy Notice:**

The Office of Oil and Gas processes your personal information, such as name, address and telephone number, as part of our regulatory duties. Your personal information may be disclosed to other State agencies or third parties in the normal course of business or as needed to comply with statutory or regulatory requirements, including Freedom of Information Act requests. Our office will appropriately secure your personal information. If you have any questions about our use or your personal information, please contact DEP's Chief Privacy Officer at [depprivacyofficer@wv.gov](mailto:depprivacyofficer@wv.gov).

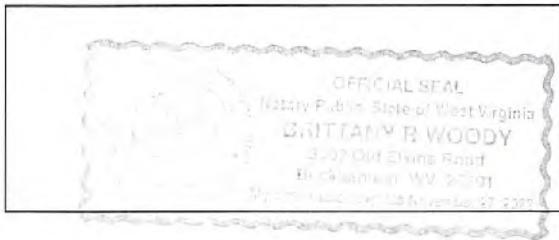

Subscribed and sworn before me this 30<sup>th</sup> day of April 2018.  
Brittany B. Woody Notary Public  
My Commission Expires 11/27/21

RECEIVED  
Office of Oil and Gas  
MAY 21 2018  
WV Department of  
Environmental Protection

**STATE OF WEST VIRGINIA  
DEPARTMENT OF ENVIRONMENTAL PROTECTION, OFFICE OF OIL AND GAS  
NOTICE OF ENTRY FOR PLAT SURVEY**

**Notice Time Requirement:** Notice shall be provided at least SEVEN (7) days but no more than FORTY-FIVE (45) days prior to entry

**Date of Notice:** 11/5/17      **Date of Planned Entry:** 11/13/2017

**Delivery method pursuant to West Virginia Code §.22-6A-10a**

- PERSONAL SERVICE       REGISTERED MAIL       METHOD OF DELIVERY THAT REQUIRES A RECEIPT OR SIGNATURE CONFIRMATION

Pursuant to West Virginia Code § 22-6A-10(a), Prior to filing a permit application, the operator shall provide notice of planned entry on to the surface tract to conduct any plat surveys required pursuant to this article. Such notice shall be provided at least seven days but no more than forty-five days prior to such entry to: (1) The surface owner of such tract; (2) to any owner or lessee of coal seams beneath such tract that has filed a declaration pursuant to section thirty-six, article six, chapter twenty-two of this code; and (3) any owner of minerals underlying such tract in the county tax records. The notice shall include a statement that copies of the state Erosion and Sediment Control Manual and the statutes and rules related to oil and gas exploration and production may be obtained from the Secretary, which statement shall include contact information, including the address for a web page on the Secretary's web site, to enable the surface owner to obtain copies from the secretary.

**Notice is hereby provided to:**

SURFACE OWNER(s)  
Name: Dallas J. Hall & Agnes L. Hall  
Address: 1953 G C and P Road  
Triadelphia, WV 26059-1317  
Name: \_\_\_\_\_  
Address: \_\_\_\_\_  
Name: \_\_\_\_\_  
Address: \_\_\_\_\_

COAL OWNER OR LESSEE  
Name: Alliance Resources GP, LLC Attn: Evan Midler  
Address: 2695 Battle Run Road  
Triadelphia, WV 26059

MINERAL OWNER(s)  
Name: Dallas J. Hall & Agnes L. Hall  
Address: 1953 G C and P Road  
Triadelphia, WV 26059-1317  
\*please attach additional forms if necessary

RECEIVED  
Office of Oil and Gas  
MAY 21 2018  
WV Department of  
Environmental Protection

**Notice is hereby given:**

Pursuant to West Virginia Code § 22-6A-10(a), notice is hereby given that the undersigned well operator is planning entry to conduct a plat survey on the tract of land as follows:

State: <u>West Virginia</u>	Approx. Latitude & Longitude: <u>40.133412, -80.612901</u>
County: <u>Ohio</u>	Public Road Access: <u>Bethany Pike</u>
District: <u>Liberty</u>	Watershed: <u>Short Creek</u>
Quadrangle: <u>Bethany</u>	Generally used farm name: <u>Dallas Hall OHI Pad</u>

Copies of the state Erosion and Sediment Control Manual and the statutes and rules related to oil and gas exploration and production may be obtained from the Secretary, at the WV Department of Environmental Protection headquarters, located at 601 57<sup>th</sup> Street, SE, Charleston, WV 25304 (304-926-0450). Copies of such documents or additional information related to horizontal drilling may be obtained from the Secretary by visiting [www.dep.wv.gov/oil-and-gas/pages/default.aspx](http://www.dep.wv.gov/oil-and-gas/pages/default.aspx).

**Notice is hereby given by:**

Well Operator: <u>SWN PRODUCTION COMPANY, LLC</u>	Address: <u>PO BOX 1300</u>
Telephone: <u>304-884-1810</u>	<u>JANE LEW, WV 26378</u>
Email: <u>dee_southall@swn.com or brittany_wocdy@swn.com</u>	Facsimile: _____

**Oil and Gas Privacy Notice:**

The Office of Oil and Gas processes your personal information, such as name, address and telephone number, as part of our regulatory duties. Your personal information may be disclosed to other State agencies or third parties in the normal course of business or as needed to comply with statutory or regulatory requirements, including Freedom of Information Act requests. Our office will appropriately secure your personal information. If you have any questions about our use of your personal information, please contact DEP's Chief Privacy Officer at [depprivacyofficer@wv.gov](mailto:depprivacyofficer@wv.gov).

STATE OF WEST VIRGINIA  
DEPARTMENT OF ENVIRONMENTAL PROTECTION, OFFICE OF OIL AND GAS  
NOTICE OF ENTRY FOR PLAT SURVEY

Notice Time Requirement: Notice shall be provided at least SEVEN (7) days but no more than FORTY-FIVE (45) days prior to entry

Date of Notice: 11/6/2017 Date of Planned Entry: 11/13/2017

Delivery method pursuant to West Virginia Code § 22-6A-10a

- PERSONAL SERVICE
- REGISTERED MAIL
- METHOD OF DELIVERY THAT REQUIRES A RECEIPT OR SIGNATURE CONFIRMATION

Pursuant to West Virginia Code § 22-6A-10(a), Prior to filing a permit application, the operator shall provide notice of planned entry on to the surface tract to conduct any plat surveys required pursuant to this article. Such notice shall be provided at least seven days but no more than forty-five days prior to such entry to: (1) The surface owner of such tract; (2) to any owner or lessee of coal seams beneath such tract that has filed a declaration pursuant to section thirty-six, article six, chapter twenty-two of this code; and (3) any owner of minerals underlying such tract in the county tax records. The notice shall include a statement that copies of the state Erosion and Sediment Control Manual and the statutes and rules related to oil and gas exploration and production may be obtained from the Secretary, which statement shall include contact information, including the address for a web page on the Secretary's web site, to enable the surface owner to obtain copies from the secretary.

Notice is hereby provided to:

SURFACE OWNER(S)  
 Name: Dallas J. Hall & Agnes L. Hall  
 Address: 1953 G C and P Road  
Triadelphia, WV 26059-1317  
 Name: \_\_\_\_\_  
 Address: \_\_\_\_\_  
 Name: \_\_\_\_\_  
 Address: \_\_\_\_\_

COAL OWNER OR LESSEE  
 Name: Windsor Coal Company  
 Address: 1000 Consol Energy Drive  
Canonsburg, PA 15317-6506

MINERAL OWNER(S)  
 Name: Dallas J. Hall & Agnes L. Hall  
 Address: 1953 G C and P Road  
Triadelphia, WV 26059-1317  
 \*please attach additional forms if necessary

RECEIVED  
Office of Oil and Gas  
MAY 21 2018  
WV Department of  
Environmental Protection

Notice is hereby given:

Pursuant to West Virginia Code § 22-6A-10(a), notice is hereby given that the undersigned well operator is planning entry to conduct a plat survey on the tract of land as follows:

State: <u>West Virginia</u>	Approx. Latitude & Longitude: <u>40.133412; -80.812301</u>
County: <u>Ohio</u>	Public Road Access: <u>Bethany Pike</u>
District: <u>Liberty</u>	Watershed: <u>Short Creek</u>
Quadrangle: <u>Bethany</u>	Generally used farm name: <u>Dallas Hall OHI Pad</u>

Copies of the state Erosion and Sediment Control Manual and the statutes and rules related to oil and gas exploration and production may be obtained from the Secretary, at the WV Department of Environmental Protection headquarters, located at 601 57<sup>th</sup> Street, SE, Charleston, WV 25304 (304-926-0450). Copies of such documents or additional information related to horizontal drilling may be obtained from the Secretary by visiting [www.dep.wv.gov/oil-and-gas/pages/default.aspx](http://www.dep.wv.gov/oil-and-gas/pages/default.aspx).

Notice is hereby given by:

Well Operator: <u>SWN PRODUCTION COMPANY, LLC</u>	Address: <u>PO BOX 1300</u>
Telephone: <u>304-884-1610</u>	<u>JANE LEW, WV 26376</u>
Email: <u>dee_southall@swn.com or brittany_woody@swn.com</u>	Facsimile: _____

Oil and Gas Privacy Notice:

The Office of Oil and Gas processes your personal information, such as name, address and telephone number, as part of our regulatory duties. Your personal information may be disclosed to other State agencies or third parties in the normal course of business or as needed to comply with statutory or regulatory requirements, including Freedom of Information Act requests. Our office will appropriately secure your personal information. If you have any questions about our use or your personal information, please contact DEP's Chief Privacy Officer at [depprivacyofficer@wv.gov](mailto:depprivacyofficer@wv.gov).

08/03/2018

STATE OF WEST VIRGINIA  
DEPARTMENT OF ENVIRONMENTAL PROTECTION, OFFICE OF OIL AND GAS  
NOTICE OF INTENT TO DRILL

Pursuant to W. Va. Code § 22-6A-16(b), the Notice of Intent to Drill is only required if the notice requirements of W. Va. Code § 22-6A-10(a) have NOT been met or if the Notice of Intent to Drill requirement has NOT been waived in writing by the surface owner.

Notice Time Requirement: Notice shall be provided at least TEN (10) days prior to filing a permit application.

Date of Notice: 05/09/2018 Date Permit Application Filed: 5/19/18

Delivery method pursuant to West Virginia Code § 22-6A-16(b)

- HAND DELIVERY
- CERTIFIED MAIL RETURN RECEIPT REQUESTED

Pursuant to W. Va. Code § 22-6A-16(b), at least ten days prior to filing a permit application, an operator shall, by receipt requested or hand delivery, give the surface owner notice of its intent to enter upon the surface owner's land for the purpose of drilling a horizontal well: *Provided*, That notice given pursuant to subsection (a), section ten of this article satisfies the requirements of this subsection as of the date the notice was provided to the surface owner: *Provided however*, That the notice requirements of this subsection may be waived in writing by the surface owner. The notice, if required, shall include the name, address, telephone number, and if available, facsimile number and electronic mail address of the operator and the operator's authorized representative.

Notice is hereby provided to the SURFACE OWNER(s):

Name: Agnes Hall  
Address: 1953 G C and P Rd  
Triadelphia, WV 26059

Name: \_\_\_\_\_  
Address: \_\_\_\_\_

Notice is hereby given:

Pursuant to West Virginia Code § 22-6A-16(b), notice is hereby given that the undersigned well operator has an intent to enter upon the surface owner's land for the purpose of drilling a horizontal well on the tract of land as follows:

State: West Virginia UTM NAD 83 Easting: 532,973.70  
County: Ohio Northing: 4,442,533.70  
District: Liberty Public Road Access: G C and P Road  
Quadrangle: Bethany Generally used farm name: Dallas Hall OHI  
Watershed: Upper Ohio South

This Notice Shall Include:

Pursuant to West Virginia Code § 22-6A-16(b), this notice shall include the name, address, telephone number, and if available, facsimile number and electronic mail address of the operator and the operator's authorized representative. Additional information related to horizontal drilling may be obtained from the Secretary, at the WV Department of Environmental Protection headquarters, located at 601 57<sup>th</sup> Street, SE, Charleston, WV 25304 (304-926-0450) or by visiting [www.dep.wv.gov/oil-and-gas/pages/default.aspx](http://www.dep.wv.gov/oil-and-gas/pages/default.aspx).

Notice is hereby given by:

Well Operator: SWN Production Company, LLC  
Address: PO Box 1300, 179 Innovation Drive  
Jane Lew, WV 26378  
Telephone: 304-439-1532  
Email: Randy\_Orsburn@swn.com  
Facsimile: 304-884-1691

Authorized Representative: Randy Orsburn  
Address: PO Box 1300, 179 Innovation Drive  
Jane Lew, WV 26378  
Telephone: 304-439-1532  
Email: Randy\_Orsburn@swn.com  
Facsimile: 304-884-1691

Oil and Gas Privacy Notice:

The Office of Oil and Gas processes your personal information, such as name, address and telephone number, as part of our regulatory duties. Your personal information may be disclosed to other State agencies or third parties in the normal course of business or as needed to comply with statutory or regulatory requirements, including Freedom of Information Act requests. Our office will appropriately secure your personal information. If you have any questions about our use or your personal information, please contact DEP's Chief Privacy Officer at [depprivacyofficer@wv.gov](mailto:depprivacyofficer@wv.gov).

RECEIVED  
Office of Oil and Gas  
Office of Oil and Gas  
MAY 21 2018  
MAY 21 2018  
WV Department of Environmental Protection

WW-6A5  
(1/12)

**STATE OF WEST VIRGINIA**  
**DEPARTMENT OF ENVIRONMENTAL PROTECTION, OFFICE OF OIL AND GAS**  
**NOTICE OF PLANNED OPERATION**

**Notice Time Requirement:** notice shall be provided no later than the **filing date of permit application.**

**Date of Notice:** 05/09/2018      **Date Permit Application Filed:** 5/19/18

**Delivery method pursuant to West Virginia Code § 22-6A-16(c)**

CERTIFIED MAIL                                       HAND  
RETURN RECEIPT REQUESTED                                      DELIVERY

Pursuant to W. Va. Code § 22-6A-16(c), no later than the date for filing the permit application, an operator shall, by certified mail return receipt requested or hand delivery, give the surface owner whose land will be used for the drilling of a horizontal well notice of the planned operation. The notice required by this subsection shall include: (1) A copy of this code section; (2) The information required to be provided by subsection (b), section ten of this article to a surface owner whose land will be used in conjunction with the drilling of a horizontal well; and (3) A proposed surface use and compensation agreement containing an offer of compensation for damages to the surface affected by oil and gas operations to the extent the damages are compensable under article six-b of this chapter. (d) The notices required by this section shall be given to the surface owner at the address listed in the records of the sheriff at the time of notice.

**Notice is hereby provided to the SURFACE OWNER(s)**  
(at the address listed in the records of the sheriff at the time of notice):

Name: Agnes Hall  
Address: 1953 G C and P Rd  
Triadelphia, WV 26059

Name: \_\_\_\_\_  
Address: \_\_\_\_\_

**Notice is hereby given:**

Pursuant to West Virginia Code § 22-6A-16(c), notice is hereby given that the undersigned well operator has developed a planned operation on the surface owner's land for the purpose of drilling a horizontal well on the tract of land as follows:

State:	<u>West Virginia</u>	UTM NAD 83	Easting:	<u>532,973.70</u>
County:	<u>Ohio</u>		Northing:	<u>4,442,633.70</u>
District:	<u>Liberty</u>	Public Road Access:	<u>G C and P Road</u>	
Quadrangle:	<u>Bethany</u>	Generally used farm name:	<u>Dallas Hall OH1</u>	
Watershed:	<u>Upper Ohio South</u>			

**This Notice Shall Include:**

Pursuant to West Virginia Code § 22-6A-16(c), this notice shall include: (1) A copy of this code section; (2) The information required to be provided by **W. Va. Code § 22-6A-10(b)** to a surface owner whose land will be used in conjunction with the drilling of a horizontal well; and (3) A proposed surface use and compensation agreement containing an offer of compensation for damages to the surface affected by oil and gas operations to the extent the damages are compensable under article six-b of this chapter. Additional information related to horizontal drilling may be obtained from the Secretary, at the WV Department of Environmental Protection headquarters, located at 601 57<sup>th</sup> Street, SE, Charleston, WV 25304 (304-926-0450) or by visiting [www.dep.wv.gov/oil-and-gas/pages/default.aspx](http://www.dep.wv.gov/oil-and-gas/pages/default.aspx).

Well Operator: SWN Production Company, LLC  
Telephone: 304-439-1532  
Email: Randy\_Orsburn@swn.com

Address: PO Box 1300, 179 Innovation Drive  
Jane Lew, WV 26378  
Facsimile: 304-884-1691

**Oil and Gas Privacy Notice:**

The Office of Oil and Gas processes your personal information, such as name, address and telephone number, as part of our regulatory duties. Your personal information may be disclosed to other State agencies or third parties in the normal course of business or as needed to comply with statutory or regulatory requirements, including Freedom of Information Act requests. Our office will appropriately secure your personal information. If you have any questions about our use or your personal information, please contact DEP's Chief Privacy Officer at [depprivacyofficer@wv.gov](mailto:depprivacyofficer@wv.gov).

RECEIVED  
Office of Oil and Gas  
RECEIVED  
Office of Oil and Gas  
MAY 21 2018  
WV Department of  
Environmental Protection  
Environmental Protection



4706900281

WEST VIRGINIA DEPARTMENT OF TRANSPORTATION

**Division of Highways**

1900 Kanawha Boulevard East • Building Five • Room 110  
Charleston, West Virginia 25305-0430 • (304) 558-3505

Jim Justice  
Governor

Thomas J. Smith, P. E.  
Secretary of Transportation/  
Commissioner of Highways

December 20, 2017

James A. Martin, Chief  
Office of Oil and Gas  
Department of Environmental Protection  
601 57<sup>th</sup> Street, SE  
Charleston, WV 25304

Subject: DOH Permit for the Dallas Hall Pad OHI 1H Well Site, Ohio County

Dear Mr. Martin,

The West Virginia Division of Highways has transferred #06-2011-0067 to the application for permit to Southwestern Energy for access to the State Road for the well site located off of Ohio County Route 37 SLS.

The operator has signed an OIL AND GAS ROAD MAINTENANCE BONDING AGREEMENT and provided the required Bond. This operator is currently in compliance with the DOH OIL AND GAS POLICY dated January 3, 2012.

Very Truly Yours,

Gary K. Clayton  
Regional Maintenance Engineer  
Central Office Oil & Gas Coordinator

Cc: Brittany Woody  
Southwestern Energy  
CH, OM, D-6  
File

E.E.O./AFFIRMATIVE ACTION EMPLOYER

08/03/2018


RECEIVED  
Office of Oil and Gas  
MAY 21 2018  
WV Department of  
Environmental Protection

RECEIVED  
Office of Oil and Gas  
MAY 21 2018  
Department of Environmental Protection

FRAC ADDITIVES			
Product Name	Product Use	Chemical Name	CAS Number
EC6734A (Champion Technologies)	Biocide	Hydrogen Peroxide	7722-84-7
		Acetic Acid	64-19-7
		Peroxyacetic Acid	79-21-0
GYPTRON T-390 (Champion Technologies)	Scale Inhibitor	Methanol	67-56-1
		Nonylphenol Ethoxylate	Proprietary
Bactron K-139 (Champion Technologies)	Biocide	Glutaraldehyde	111-30-8
		Quaternary Ammonium Compounds, Benzyl-C12-16-Alkyldimethyl, Chlorides	68424-85-1
		Ethanol	64-17-5
Bactron K-219 (Champion Technologies)	Biocide	Methanol	67-56-1
		Quaternary Ammonium Compounds, Benzyl-C12-16-Alkyldimethyl, Chlorides	68424-85-1
EC6486A (Nalco Champion)	Scale Inhibitor	Amine Triphosphate	Proprietary
		Ethylene Glycol	107-21-1
WFRA-2000 (U.S. Well Services)	Anionic Friction Reducer	Hydrotreated light distillate (petroleum)	64742-47-8
		Propenoic acid, polymer with propenamide	9003-06 9
AI-303 (U.S. Well Services)	Mixture	Ethylene glycol	107-21 1
		Cinnamaldehyde	104-55 2
		Butyl cellosolve	111-76 2
		Formic acid	64-18 6
		Polyether	Proprietary
		Acetophenone, thiourea, formaldehyde polymer	68527-49 1
AP ONE (U.S. Well Services)	Breaker	Ammonium persulfate	7727-54-0
OPTI-FLEX (U.S. Well Services)	Viscosifying Agent	Distillates, petroleum, hydrotreated light	64742-47-8
Econo-CI200 (SWN Well Services)	Corrosion Inhibitor	Methanol	67-56-1
		Oxyalkylated fatty acid	68951-67-7
		Fatty acids	61790-12-3
		Modified thiourea polymer	68527-49-1
		Water	7732-18-5
		Hydrochloric acid	7647-01-0
		Potassium acetate	127-08-2
		Formaldehyde	50-00-0
Ecopol-FEAC (SWN Well Services)	Iron Control	Acetic Acid	64-19-7
		Citric Acid	77-92-9
		Water	7732-18-5
HCL (SWN Well Services)	Hydrocholic Acid	Hydrochloric Acid	7647-01-0
		Water	7732-18-5
FLOJET DRP 1130X (SWN Well Services)	Friction Reducer	Proprietary	Proprietary
FLOJET DR900 LPP (SWN Well Services)	Friction Reducer	Distillates (petroleum) hydrotreated light	64674-47-8
		Ethylene Glycol	107-21-1
		Alcohols, C12-16, Exoxylated propoxylated	68213-24-1
		Fatty Alcohols ethoxylated	Proprietary
		Water	7732-18-5
FR-76 (Halliburton)	Friction Reducer	Hydrotreated light petroleum distillate	64742-47-8
		Inorganic Salt	Proprietary
HAI-150E (Halliburton)	Corrosion Inhibitor	No hazardous substance	N/A
FDP-S1176-15 (Halliburton)	Friction Reducer	Polyacrylate	Proprietary
		Hydrotreated light petroleum distillate	64742-47-8
LP-65 MC (Halliburton)	Scale Inhibitor	Organic phosphonate	Proprietary
		Ammonium Chloride	12125-02-9
CarboNRT	Tracer	Ceramic Proppant	66402-68-4



USGS 7.5 BETHANY/VALLEY GROVE QUAD MAPS

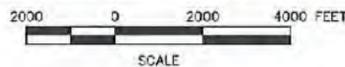

**WVDEP OOG  
ACCEPTED AS-BUILT**

*WJD* 2/21/2018

# DALLAS HALL OHI WELL PAD

## CONSTRUCTION AS-BUILT & RECLAMATION PLAN

LIBERTY DISTRICT, OHIO COUNTY, WV

OCTOBER 2017


**LOCATION COORDINATES:**

**ACCESS ROAD ENTRANCE**  
 LATITUDE: 40.120941 LONGITUDE: -80.615332 (NAD-83)  
 N 14570869.65 E 1747893.31 (UTM ZONE 17 METERS)


**WELL PAD CENTER**  
 LATITUDE: 40.133400 LONGITUDE: -80.612897 (NAD-83)  
 N 14575545.96 E 1748614.12 (UTM ZONE 17 METERS)

**NOTES:**

1. THE AS-BUILT INFORMATION SHOWN HEREON REFLECTS FIELD DATA COLLECTED RELATING TO THE FINAL GRADING OF THE DISTURBED AREA AS OF AUGUST 4, 2017. LARSON DESIGN GROUP IS NOT RESPONSIBLE FOR ANY CHANGES MADE TO THE SITE AFTER THE ABOVE MENTIONED DATE.
2. PROPERTY INFORMATION SHOWN HEREON WAS PROVIDED BY SOUTHWESTERN ENERGY AND MAY NOT REFLECT CURRENT BOUNDARY LOCATION.

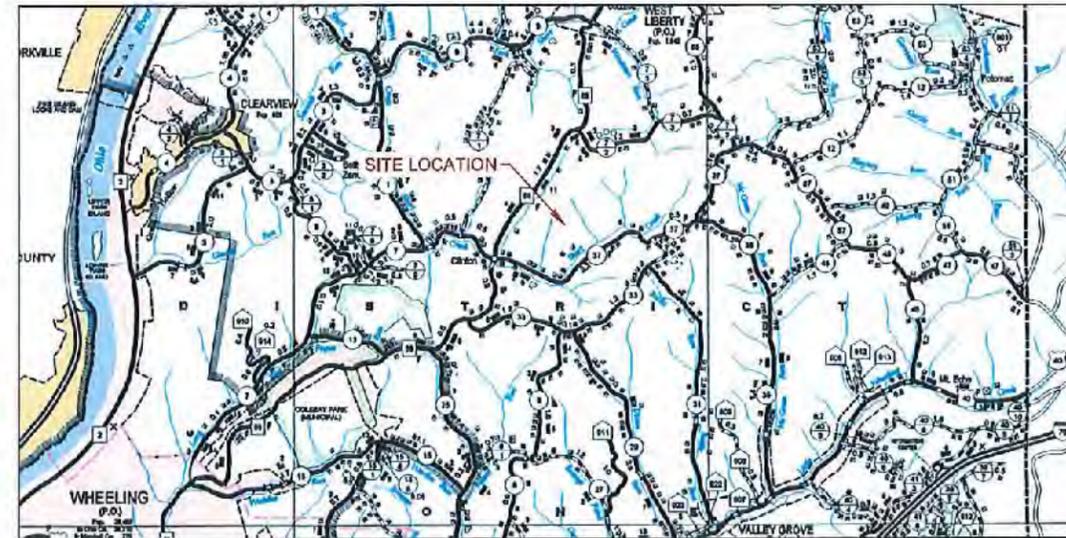

WEST VIRGINIA DIVISION OF HIGHWAYS COUNTY ROAD MAP

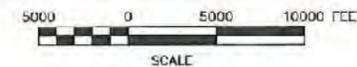

TOTAL DISTURBED AREA: 22.60 ACRES  
 ROAD DISTURBED AREA: 14.06 ACRES  
 PAD DISTURBED AREA: 8.54 ACRES

WELL NAMES	WV NORTH NAD 27	WV NORTH NAD 83	UTM (METERS) ZONE 17	NAD 83 LAT & LONG	ELEVATION (FEET)
AS-BUILT COORDINATES					
DALLAS HALL BH (ORIG) API# 47-069-00075	N 596797.18 E 1688759.01	N 596834.10 E 1657924.79	N 4442022.04 E 532977.51	LAT 40.133286° LONG -80.612911°	1276.47'
DALLAS HALL RH (ORIG) API# 47-069-00076	N 596784.13 E 1688754.42	N 596821.05 E 1657319.80	N 4442918.63 E 532976.00	LAT 40.133250° LONG -80.612920°	1276.71'

**SHEET INDEX**

- 1 COVER SHEET
- 2-3 EVACUATION ROUTE/PREVAILING WINDS
- 4 AS-BUILT OVERALL PLAN SHEET INDEX
- 5-7 ACCESS ROAD AS-BUILT PLAN
- 8 WELL PAD AS-BUILT PLAN
- 9-10 ACCESS ROAD AS-BUILT PROFILE
- 11 WELL PAD AS-BUILT PROFILE
- 12 AS-BUILT RECLAMATION PLAN OVERALL PLAN SHEET INDEX
- 13-15 AS-BUILT ACCESS ROAD RECLAMATION PLAN
- 16 AS-BUILT WELL PAD RECLAMATION PLAN
- 17 GENERAL NOTES AND DETAILS
- 18-19 DETAILS

**ENGINEERING ESTIMATE OF QUANTITIES**  
**WELL SITE PAD DATA (DRILLING)**

INSTALL MOUNTABLE BERM	87	CY
RAISE EXISTING CONTAINMENT BERM TO MIN. 2' HEIGHT	10	CY
SEED & MULCH DISTURBED AREAS	220	SY
18" COMPOST SOCK	342	LF
STONE FOR PAD SURFACE REPAIR AND MOUNTABLE BERM STONE SURFACING	38	CY

**WELL SITE PAD DATA (RECLAMATION)**

REMOVE SUMP	2	EA
BREACH BERM	2	EA
10' WIDE RIP-RAP DISCHARGE CHANNELS	18	CY

*C. J. All*  
12-19-17



WEST VIRGINIA COUNTY MAP  
NOT TO SCALE

**AS-BUILT CERTIFICATION**

THE DRAWINGS, CONSTRUCTION NOTES, AND REFERENCE DIAGRAMS ATTACHED HERETO HAVE BEEN PREPARED IN ACCORDANCE WITH THE WEST VIRGINIA CODE OF STATE RULES, DIVISION OF ENVIRONMENTAL PROTECTION, OFFICE OF OIL AND GAS CSR 35-8.



MISS Utility of West Virginia  
 1-800-245-4848  
 West Virginia State Law  
 (Section XIV: Chapter 24-C)  
 Requires that you call two  
 business days before you dig in  
 the state of West Virginia.  
 IT'S THE LAW!



ORIGINAL SHEET SIZE:  
ANSI FULL BLEED D  
(22.00 X 34.00 INCHES)  
SHEET NO.:  
1 OF 19  
PROJECT NO.:  
768R-016-011

**DALLAS HALL OHI WELL PAD**  
LIBERTY DISTRICT, OHIO COUNTY, WEST VIRGINIA

**Larson Design Group** - Architects Engineers Surveyors  
 2502 Cherry Square  
 Morgantown, WV 26508  
 PHONE 304.777.2940 TOLL FREE 877.323.5603  
 FAX 579.323.9902 • www.larsondesigngroup.com  
**SWN Production Company, LLC**  
 179 Innovation Drive  
 Jane Lew, WV 26378  
 PHONE 304.884.1622

NO.	DATE	ISSUE / REVISIONS
1	10/17/2017	FINAL AS-BUILT PLAN
2	9/29/2017	DRAFT AS-BUILT PLAN
		BY: RMR
		BLG: RMR




08/03/2018

# WELL PAD AS-BUILT PLAN



EXISTING LIMIT OF DISTURBANCE	---
EXISTING PROPERTY	---
EXISTING PAVEMENT	---
EXISTING GRAVEL	---
EXISTING GAS LINE	---
EXISTING WATER LINE	---
EXISTING FENCE	---
EXISTING ABOVE GROUND PIPE	---
EXISTING TREE LINE	---
EXISTING CHANNEL	---
18" COMPOST FILTER SOCK	---
EXISTING GAS WELL	---
EXISTING RIP RAP	---
EXISTING UNDERGROUND PIPING	---

**WVDEP OOG  
ACCEPTED AS-BUILT**  
*WJL* 2/21/2018

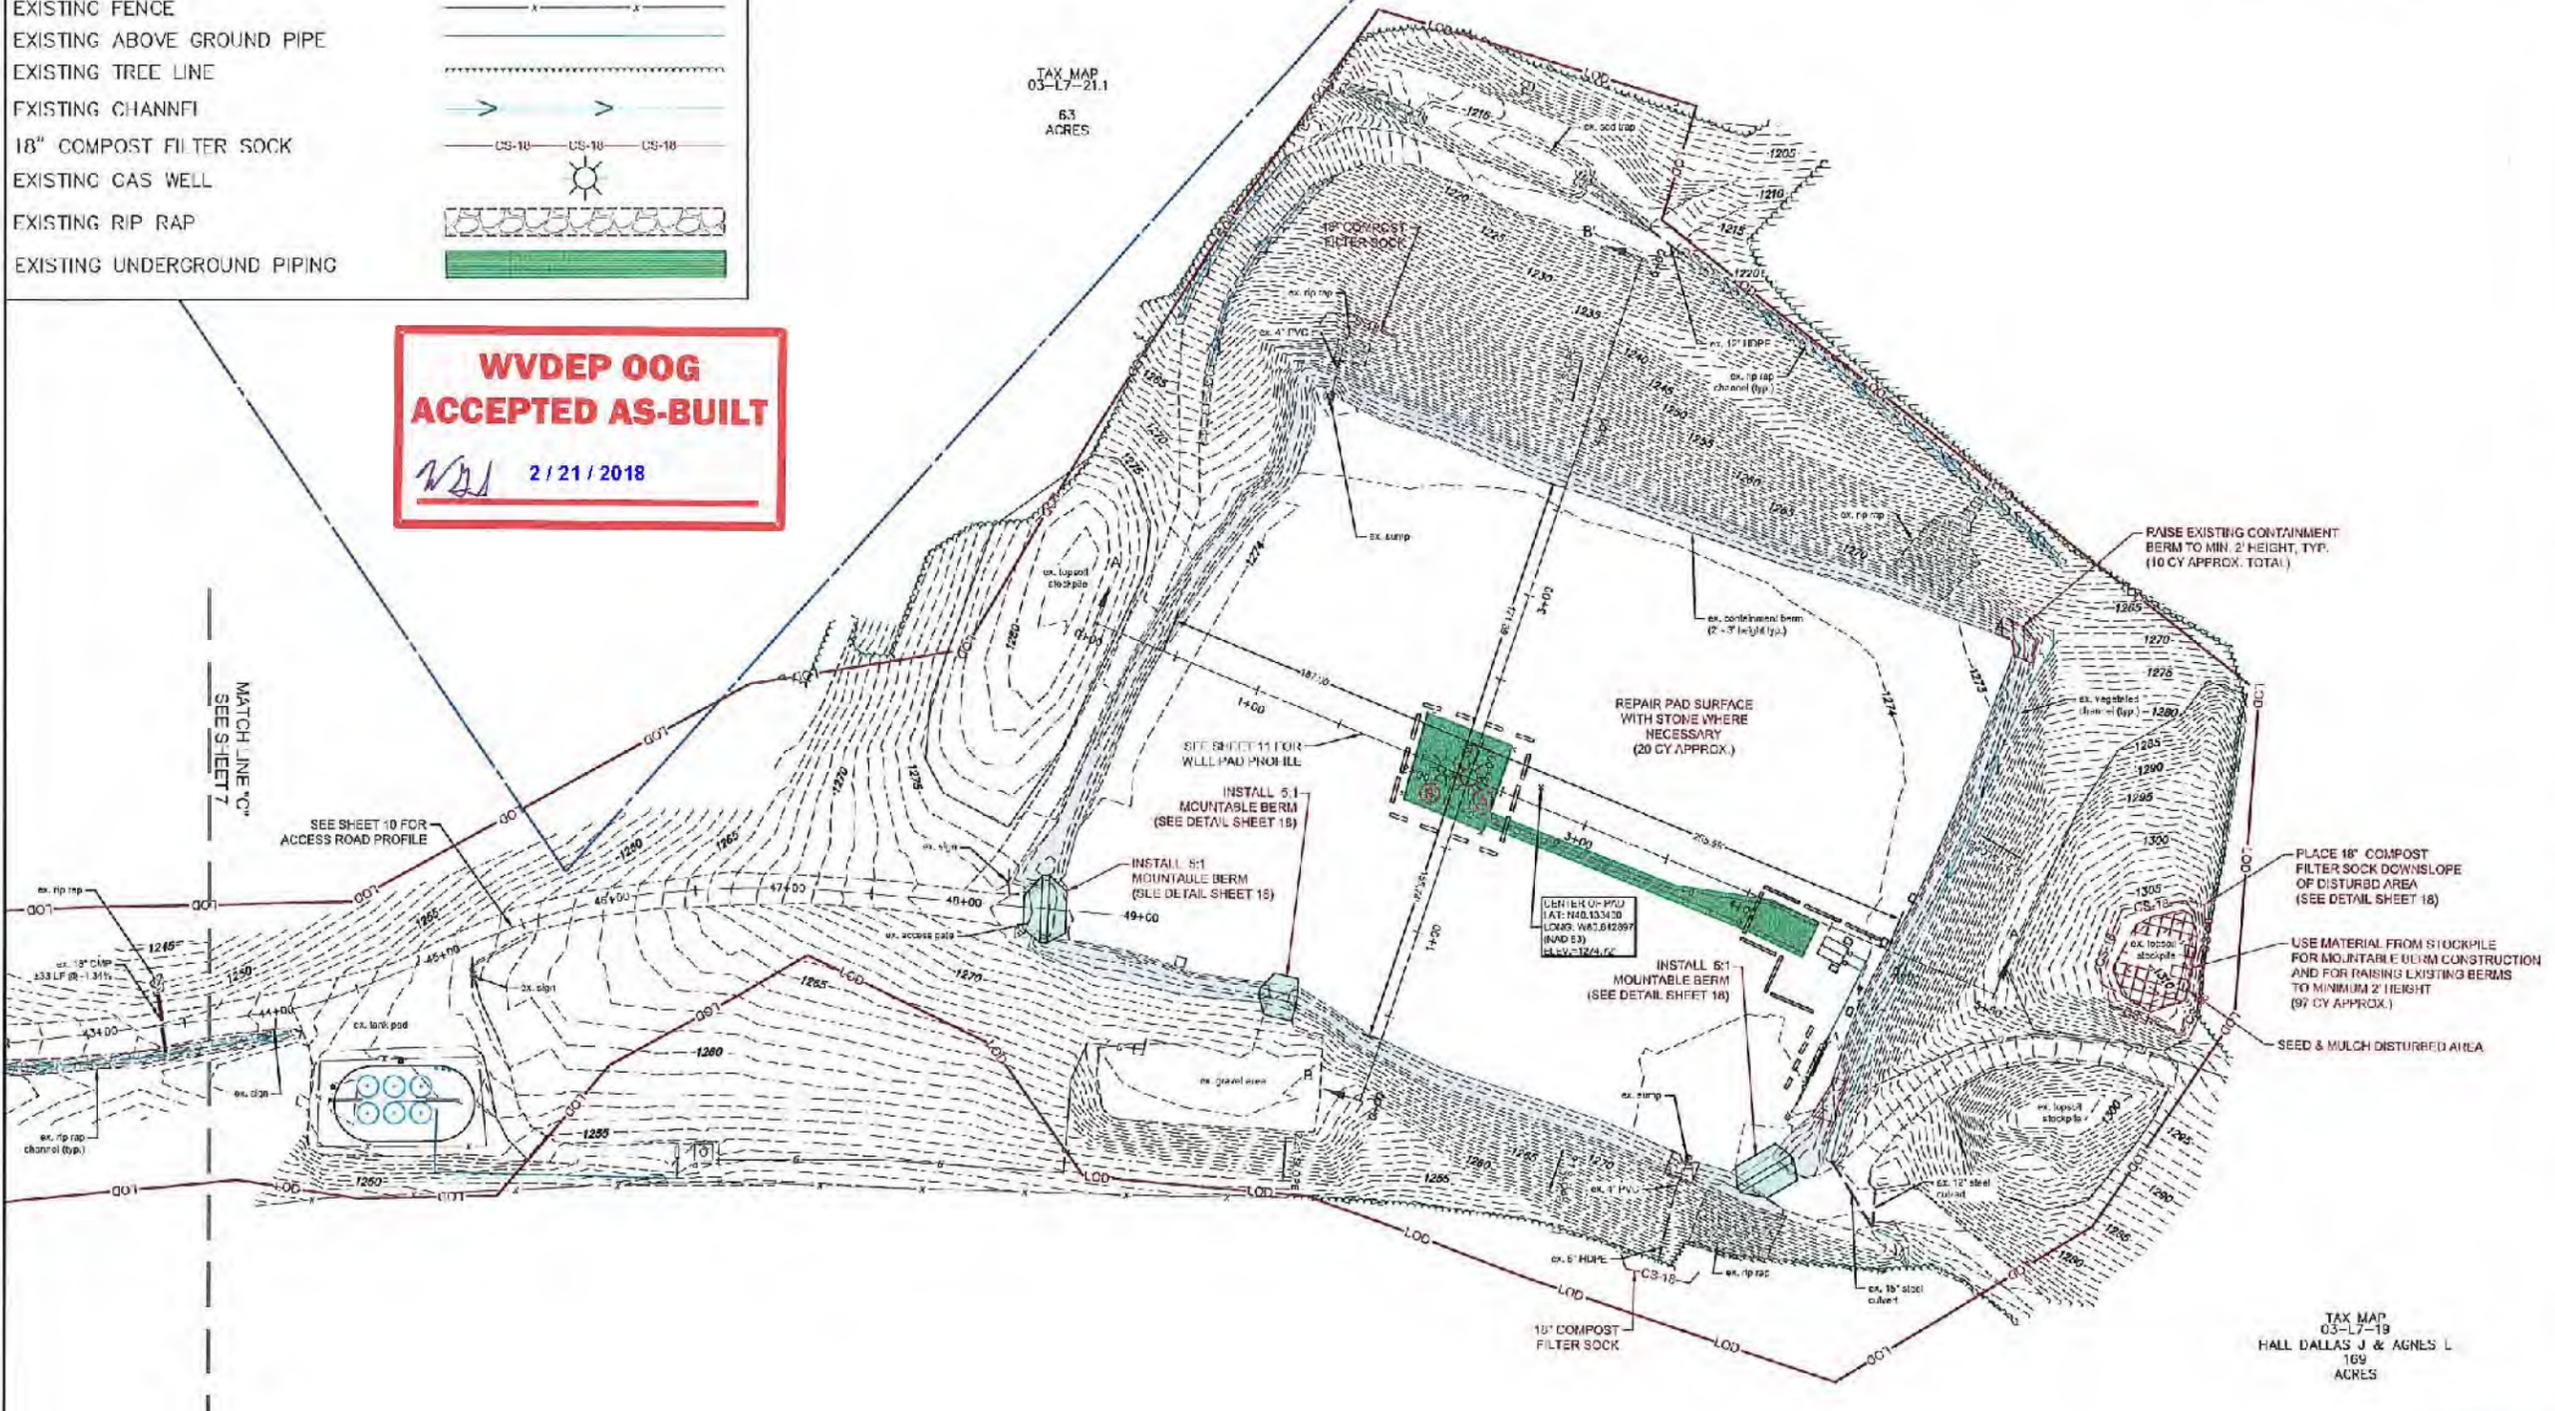

TAX MAP  
03-L7-21.1  
6.3  
ACRES



NO.	DATE	COMMENTS	BY	CHK
1	10/7/2017	FINAL AS-BUILT PLAN	BLG	RMR
3	5/25/2017	DRAFT AS-BUILT P-AN	BLG	RMR

ISSUE / REVISIONS

**WELL PAD AS-BUILT PLAN**

**DALLAS HALL OHI WELL PAD**  
LIBERTY DISTRICT, OHIO COUNTY, WEST VIRGINIA

Larson Design Group - Architects Engineers Surveyors  
2502 Cranberry Square  
Morgantown, WV 26508  
PHONE 304.777.2940 TOLL FREE 877.323.6503  
FAX 570.323.9502 • www.larsondesigngroup.com

SWN Production Company, LLC  
79 Innovation Drive  
Jama, WV 26375  
PHONE 304.884.1822

WELLHEAD INDEX

(A)	DALLAS HALL OHI 5H (DRILLED)
(B)	DALLAS HALL OHI 5H (DRILLED)



ORIGINAL SHEET SIZE:  
ANSI FULL BLEED D  
(22.00 X 34.00 INCHES)

SHEET NO.:  
8 OF 19

PROJECT NO.:  
7688 016 011

08/03/2018