

### west virginia department of environmental protection

Office of Oil and Gas 601 57th Street, S.E. Charleston, WV 25304 (304) 926-0450 fax: (304) 926-0452

Harold D. Ward, Cabinet Secretary www.dep.wv.gov

Monday, April 10, 2023 WELL WORK PERMIT Horizontal 6A / New Drill

SWN PRODUCTION COMPANY, LLC POST OFFICE BOX 12359

SPRING, TX 773914954

Re:

Permit approval for CARL ROTTER OHI 3H

47-069-00356-00-00

This well work permit is evidence of permission granted to perform the specified well work at the location described on the attached pages and located on the attached plat, subject to the provisions of Chapter 22 of the West Virginia Code of 1931, as amended, and all rules and regulations promulgated thereunder, and to any additional specific conditions and provisions outlined in the pages attached hereto. Notification shall be given by the operator to the Oil and Gas Inspector at least 24 hours prior to the construction of roads, locations, and/or pits for any permitted work. In addition, the well operator shall notify the same inspector 24 hours before any actual well work is commenced and prior to running and cementing easing. Spills or emergency discharges must be promptly reported by the operator to 1-800-642-3074 and to the Oil and Gas Inspector.

Please be advised that form WR-35, Well Operators Report of Well Work is to be submitted to this office within 90 days of completion of permitted well work, as should form WR-34 Discharge Monitoring Report within 30 days of discharge of pits, if applicable. Failure to abide by all statutory and regulatory provisions governing all duties and operations hereunder may result in suspension or revocation of this permit and, in addition, may result in civil and/or criminal penalties being imposed upon the operators.

Per 35 CSR 4-5.2.g this permit will expire in two (2) years from the issue date unless permitted well work is commenced. If there are any questions, please feel free to contact me at (304) 926-0450

Operator's Well Number: CARL ROTTER OHI 3H

Farm Name: CARL J & GRACE A ROTTER

U.S. WELL NUMBER: 47-069-00356-00-00

Horizontal 6A New Drill

Date Issued: 4/10/2023

Promoting a healthy environment.

4	7	0	6	9	0	0	3	5	6
API Number	:					-		"Opp"	8

### PERMIT CONDITIONS

West Virginia Code § 22-6A-8(d) allows the Office of Oil and Gas to place specific conditions upon this permit. Permit conditions have the same effect as law. Failure to adhere to the specified permit conditions may result in enforcement action.

### **CONDITIONS**

- This proposed activity may require permit coverage from the United States Army Corps of Engineers (USACE).
   Through this permit, you are hereby being advised to consult with USACE regarding this proposed activity.
- 2. If the operator encounters an unanticipated void, or an anticipated void at an unanticipated depth, the operator shall notify the inspector within 24 hours. Modifications to the casing program may be necessary to comply with W. Va. Code § 22-6A-5a (12), which requires drilling to a minimum depth of thirty feet below the bottom of the void, and installing a minimum of twenty (20) feet of casing. Under no circumstance should the operator drill more than one hundred (100) feet below the bottom of the void or install less than twenty (20) feet of casing below the bottom of the void.
- 3. When compacting fills, each lift before compaction shall not be more than 12 inches in height, and the moisture content of the fill material shall be within limits as determined by the Standard Proctor Density test of the actual soils used in specific engineered fill, ASTM D698, Standard Test Method for Laboratory Compaction Characteristics of Soil Using Standard Effort, to achieve 95 % compaction of the optimum density. Each lift shall be tested for compaction, with a minimum of two tests per lift per acre of fill. All test results shall be maintained on site and available for review.
- 4. Operator shall install signage per § 22-6A-8g (6) (B) at all source water locations included in their approved water management plan within 24 hours of water management plan activation.
- 5. Oil and gas water supply wells will be registered with the Office of Oil and Gas and all such wells will be constructed and plugged in accordance with the standards of the Bureau for Public Health set forth in its Legislative rule entitled Water Well Regulations, 64 C.S.R. 19. Operator is to contact the Bureau of Public Health regarding permit requirements. In lieu of plugging, the operator may transfer the well to the surface owner upon agreement of the parties. All drinking water wells within fifteen hundred feet of the water supply well shall be flow tested by the operator upon request of the drinking well owner prior to operating the water supply well.
- 6. Pursuant to the requirements pertaining to the sampling of domestic water supply wells/springs the operator shall, no later than thirty (30) days after receipt of analytical data provide a written copy to the Chief and any of the users who may have requested such analyses.
- 7. 24 hours prior to the initiation of the completion process the operator shall notify the Chief or his designee.
- 8. During the completion process the operator shall monitor annular pressures and report any anomaly noticed to the chief or his designee immediately.
- 9. If any explosion or other accident causing loss of life or serious personal injury occurs in or about a well or well work on a well, the well operator or its contractor shall give notice, stating the particulars of the explosion or accident, to the oil and gas inspector and the Chief, within 24 hours of said accident.
- 10. During the casing and cementing process, in the event cement does not return to the surface, the oil and gas inspector shall be notified within 24 hours.
- 11. The operator shall provide to the Office of Oil and Gas the dates of each of the following within 30 days of their occurrence: completion of construction of the well pad, commencement of drilling, cessation of drilling, completion of any other permitted well work, and completion of the well. Such notice shall be provided by sending an email to DEPOOGNotify@wv.gov.

Well Pad Name: Carl Rotter OHI

# STATE OF WEST VIRGINIA DEPARTMENT OF ENVIRONMENTAL PROTECTION, OFFICE OF OIL AND GAS WELL WORK PERMIT APPLICATION

				,			
1) Well Operato	r: SWN Produ	uction Co., LLC	494512924	069-Ohio	3-Liberty	648-Valley Grove	
			Operator ID	County	District	Quadrangle	
2) Operator's W	ell Number: Ca	arl Rotter OHI 3H	Well Pac	d Name: Carl F	Rotter OHI		
3) Farm Name/S	Surface Owner:	Carl J. & Grace A.	Rotter Public Roa	d Access: Rog	gers Road		
4) Elevation, cu	rrent ground:	1336' / E	levation, proposed	post-constructi	on: 1336'		
5) Well Type (a) Gas x Oil Underground Storage							
	Other						
		allow X	Deep				
6) Existing Pad:		rizontal X					
7) Proposed Tar	get Formation(s	), Depth(s), Antic	ipated Thickness a	and Expected Pr D- 6607', Anticipated	ressure(s): Thickness- 59', A	ssociated Pressure- 4295	
8) Proposed Tot	al Vertical Dept	<sub>th:</sub> 6580'					
9) Formation at	Total Vertical D	Depth: Marcellus	5				
10) Proposed To	otal Measured D	epth: 26,687'	/				
11) Proposed Ho	orizontal Leg Le	ength: 19715.46	5'				
12) Approximat	e Fresh Water S	trata Depths:	585'	96			
13) Method to D	etermine Fresh	Water Depths:	Salinity Profile wit	h nearby wate	r well 4	706900330	
14) Approximat	e Saltwater Dep	ths: 835' Salinity	/ Profile /		<b>D</b>		
15) Approximat	e Coal Seam De	epths: 722'	/		Office Of Oil	VED and Gas	
16) Approximat	e Depth to Possi	ible Void (coal m	ine, karst, other):	None that we a	are allares	ofo	
17) Does Propos	sed well location	n contain coal sea	ma	E	Wy Departmental Pr	nt ot	
		an active mine?	Yes	No	X	otection	
(a) If Yes, prov	vide Mine Info:	Name:					
		Depth:					
( )	lier	Seam:					
(100	LOW 3.	Owner:					
Crown Spark	1						
y gra	7						

API NO. 47-009 6 9 0 0 3 5 6
OPERATOR WELL NO. Carl Rotter OHI 3H

Well Pad Name: Carl Rotter OHI

18)

### **CASING AND TUBING PROGRAM**

TYPE	Size (in)	New or Used	Grade	Weight per ft. (lb/ft)	FOOTAGE: For Drilling (ft)	INTERVALS: Left in Well (ft)	CEMENT: Fill-up (Cu. Ft.)/CTS
Conductor	20"	New	J-55	94#	110'	110' /	CTS /
Fresh Water	13 3/8"	New	J-55	54.4#	767'	767' /	891 sx/CTS
Coal	See	Surface	Casing	***************************************			0010/010
Intermediate	9 5/8"	New	J-55	36#	2200'	2200' /	815 sx/CTS
Production	5 1/2"	New	P-110 HP	20#	26687'	26687' /	Tail 4760sx/ 100' Inside Intermediate
Tubing							
Liners							

TYPE	Size (in)	Wellbore Diameter (in)	Wall Thickness	Burst Pressure (psi)	Anticipated Max. Internal	Cement Type	Cement Yield
Conductor			<u>(in)</u>		Pressure (psi)	Type	(cu. ft./k)
Conductor	20"	30"	0.25	2120	81	Class A	1.20/30% Excess
Fresh Water	13 3/8"	17.5"	0.380	2730	633	Class A	1.20/30% Excess
Coal	See	Surface	Casing		000	0103371	1.20/00 /6 EXCESS
Intermediate	9 5/8"	12 1/4"	0.395	3950	1768	Class A	1.19/40% Excess
Production	5 1/2"	8 3/4"-8 1/2"	0.361	14360	10500	Class A	1.19/5% Excess
Tubing				7.4		0.0.00 / 1	
Liners							

RECEIVED
Office Of Oil and Gas

MAR 0 8 2023

### **PACKERS**

WV Department of Environmental Protection

Kind:		
Sizes:		
Depths Set:		



Page 2 of 3

### API NO. 47-497 0 6 9 0 0 3 5 6

OPERATOR WELL NO. Carl Rotter OHI 3H
Well Pad Name: Carl Rotter OHI

19) Describe proposed well work, including the drilling and	plugging back of any pilot hole:
---	----------------------------------

Drill and stimulate any potential zones between and including the Benson to Marcellus. \*\*If we should encounter a void place basket above and below void area- balance cement to bottom of void and grout from basket to surface or run external casing packer/cementing stage tool above void interval and perform 2 stage cementing operation dependent upon depth of void. Run casing not less than 20' below void nor more than 75' below void. (\*If freshwater is encountered deeper than anticipated it must be protected, set casing 50' below and cts.)

20) Describe fracturing/stimulating methods in detail, including anticipated max pressure and max rate:

Well will be perforated within the target formation and stimulated with a slurry of water, sand, and chemical additives at a high rate. This will be performed in stages with the plug and perf method along the wellbore until the entire lateral has been stimulated within the target formation. All stage plugs are then drilled out and the well is flowed back to surface. In some instances, additional toe prep may be performed by pumping additional water in the toe of the well prior to perforating and pumping Stage 1 to ensure that the toe guns/toe sleeves are fully open prior to pumping stage 1. The well is produced through surface facilities consisting of high pressure production units, horizontal separation units, water and oil storage tanks. Max press and anticipated max rate- 12,500 psi @ 100 barrels a minute.

21)	Total Area to	be disturbed,	including roads,	stockpile area,	pits,	etc.,	(acres):	14	1
-----	---------------	---------------	------------------	-----------------	-------	-------	----------	----	---

- 22) Area to be disturbed for well pad only, less access road (acres): 9
- 23) Describe centralizer placement for each casing string:

All casing strings will be ran with a centralizer at a minimum of 1 per every 3 joints of casing.

RECEIVED
Office Of Oil and Gas

MAR 08:02

24) Describe all cement additives associated with each cement type:

WV Department or Environmental Protection

See Attachment \*\*\*

25) Proposed borehole conditioning procedures:

All boreholes will be conditioned with circulation and rotation for a minimum of one bottoms up and continuing until operator is satisfied with borehole conditions.

\*Note: Attach additional sheets as needed.

5/2022 2/28/2023

Page 3 of 3

API Number 47 -	069	-
Operator	c Wall No	0.15 // 01/1011

# Operator's Well No. Carl Rotter OHI 3H STATE OF WEST VIRGINIA DEPARTMENT OF ENVIRONMENTAL PROTECTION OFFICE OF OIL AND GAS

### FLUIDS/ CUTTINGS DISPOSAL & RECLAMATION PLAN

Operator Name SWN Production Co., LLC OP Code 494512924
Watershed (HUC 10) Upper Ohio South Quadrangle Valley Grove
Do you anticipate using more than 5,000 bbls of water to complete the proposed well work? Yes Vo No
Will a pit be used? Yes No 🗸
If so, please describe anticipated pit waste:
Will a synthetic liner be used in the pit? Yes No If so, what ml.?
Proposed Disposal Method For Treated Pit Wastes:
Land Application
Underground Injection (UIC Permit Number Various Approved Facilities
Reuse (at API Number At the next anticpiated well
Off Site Disposal (Supply form WW-9 for disposal location)  Other (Explain recovery and solidification on site
Cater (Explain and contained on the
Will closed loop system be used? If so, describe: Yes- See Attachment 3A
Drilling medium anticipated for this well (vertical and horizontal)? Air, freshwater, oil based, etcAir drill to KOP, fluid drill with SOBM from KOP to TD
-If oil based, what type? Synthetic, petroleum, etc. Synthetic Oil Base  Additives to be used in drilling medium? Attachment 3B
Additives to be used in drilling medium? Attachment 3B MAR 18 3333
Drill cuttings disposal method? Leave in pit landfill removed offsite etc. landfill
-If left in pit and plan to solidify what medium will be used? (cement, lime, sawdust)  -If left in pit and plan to solidify what medium will be used? (cement, lime, sawdust)
-Landfill or offsite name/permit number? Meadowfill SWF- 1032, Short Creek SWF-1034, Carbon Limestone MSWL018781, Wetzel County 1021
Apex Sanitary Landill Uo-U8438, Brooke Co SWF-1U13, FIMS 3531UU
Permittee shall provide written notice to the Office of Oil and Gas of any load of drill cuttings or associated waste rejected at any West Virginia solid waste facility. The notice shall be provided within 24 hours of rejection and the permittee shall also disclose
where it was properly disposed.
I certify that I understand and agree to the terms and conditions of the GENERAL WATER POLLUTION PERMIT issued on August 1, 2005, by the Office of Oil and Gas of the West Virginia Department of Environmental Protection. I understand that the provisions of the permit are enforceable by law. Violations of any term or condition of the general permit and/or other applicable law or regulation can lead to enforcement action.  I certify under penalty of law that I have personally examined and am familiar with the information submitted on this application form and all attachments thereto and that, based on my inquiry of those individuals immediately responsible for obtaining the information, I believe that the information is true, accurate, and complete. I am aware that there are significant penalties for submitting false information, including the possibility of fine or imprisonment.  Company Official Signature  Brittany Woody  Company Official Title  Senior Regulatory Analyst
Subscribed and sworn before me this day of FEBRUARY, 20 23
Notary Public JUSTIN BOOTH
My commission expires  3 /10/2027  Notary Public Official Seal State of West Virginia My Comm. Expires Mar 10, 2027  141 Scenery Drive Morgantown WV 26505

Form WW-9	On anota da I	Well No. Carl Rotter OHI 3H
SWN Production Co., LLC	Operator's v	well No
Proposed Revegetation Treatment: Acres Disturbed 14	Prevegetation p	Н
Lime _as determined by pH test min.2 Tons/acre or to correct to pH _9_	JII	
Fertilizer type 10-20-20		
Fertilizer amount_600/500 lbs/acre		
Mulch Hay/Straw Tons/acre		
Seed Mixt	ures	
Temporary	Perma	nent
Seed Type Ibs/acre Attachment 3C	Seed Type	lbs/acre
Attach:		
Maps(s) of road, location, pit and proposed area for land application (uprovided). If water from the pit will be land applied, include dimensionacreage, of the land application area.	inless engineered plans includens (L x W x D) of the pit, and	ling this info have been dimensions (L x W), and area
Photocopied section of involved 7.5' topographic sheet.		
		Office Of Oil and
Plan Approved by:		Office RECEIVED  Of Oil and Gas  MAR 0 8 77773  Environ Department
Comments:		Environmental Protection
		-4011
	9	

Date: 2/28/2023

(\_\_\_\_\_) No

Title: Oil & Gas Inspector

Field Reviewed?

\_\_\_\_\_) Yes


# MARCELLUS WELL DRILLING PROCEDURES AND WELL SITE SAFETY PLAN




SWN Production Company, LLC 1300 Fort Pierpont Drive, Suite 201 Morgantown, West Virginia 26508

API NO. 47-XXX-XXXXX
WELL NAME: Carl Rotter OHI 3H
Valley Grove QUAD
Liberty DISTRICT
OHIO COUNTY, WEST VIRGINIA

Submitted by:	
Name: Brittany Woody Suttany Woody	Date: <u>2/6/2023</u>
Title: Senior Regulatory Analyst	SWN Production Co., LLC
Approved by:  Name: State Court  Title:	Date: 2/28/2023  Date: 2/28/2023  Date: 2/28/2023  Date: 2/28/2023
Approved by:	
Name:	Date:
Title:	
SWN PRODUCTION COMPANY, LLC -	- CONFIDENTIAL

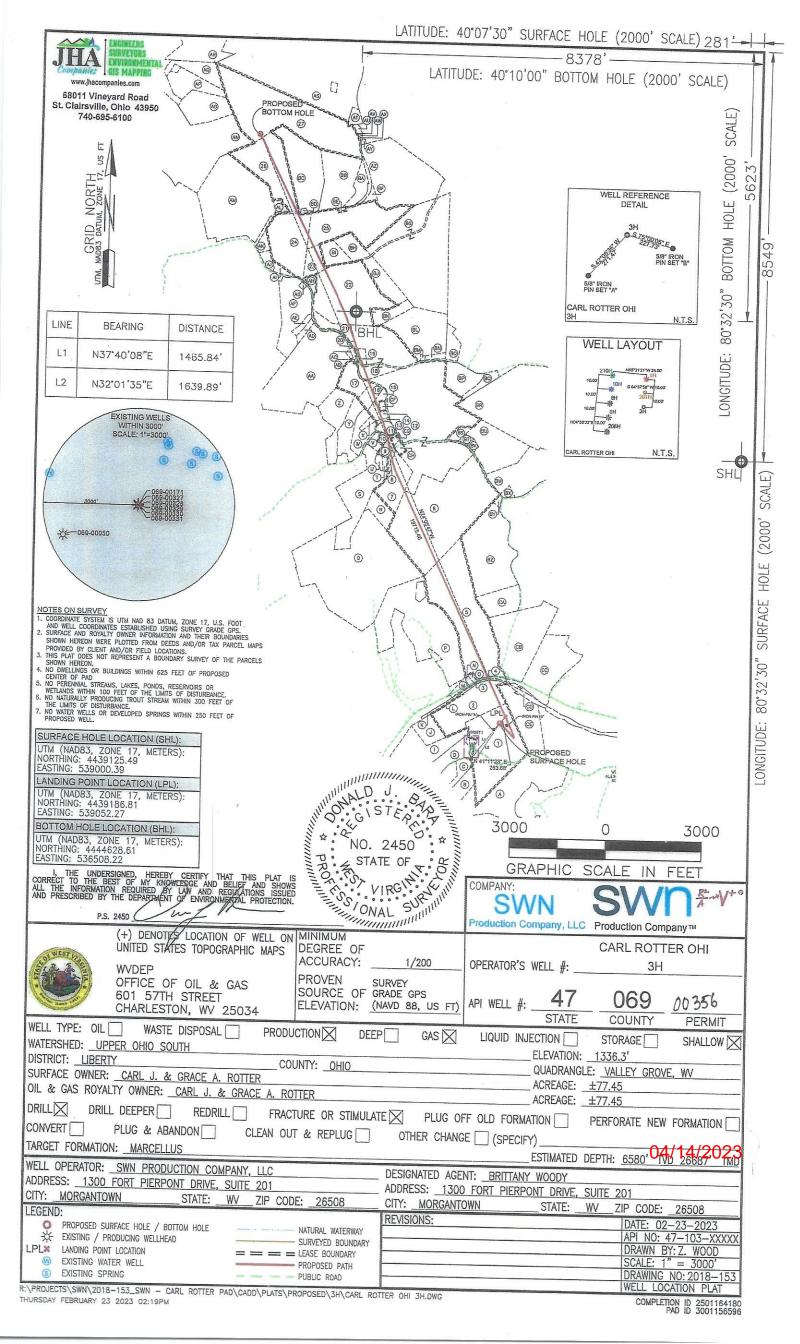

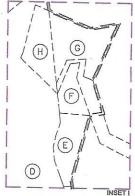

		130	-,,,,,,,,,,,,,,,,,,,,,,,,,,,,,,,,,,,,,,	SOMFACE OWNER	TAX PARCEL
₹.			J	ROTTER CARL J & GRACE A	3-L11-65
	I WAY		K	TUNNEL RIDGE LLC	3-L11-72
	\\\\\\\\\\\\\\\\\\\\\\\\\\\\\\\\\\\\\\	20	L	TUNNEL RIDGE LLC	3-L11-71
	1 - +- +	*	M	HOLLOWAY STRICKLAND III	3-L11-32
			N	VANCE DONNA ELAINE	3-L11-32.2
	(E)		0	VANCE DONNA ELAINE	3-L11-32.1
	0	ū.	Р	GROUX EDWARD G JR & GROUX JEFFREY L	3-L11-27
	INSETI N.T.S.		Q	GROUX EDWARD G & LYDIA C-LIFE & GROUX EDWARD G JR	3-L11-26
TRACT	WELL BORE TABLE FOR SURFACE/ROYALTY OV SURFACE OWNER (S) / ROYALTY OWNER (R)	TAX PARCEL	R	GROUX EDWARD G & LYDIA C-LIFE & GROUX EDWARD G JR	3-L11-26.6
1	ROTTER CARL J & GRACE A (S/R)	3-L11-54	S	KNIGHT CRAIG C & KATHLEEN	3-L8-33.8
TRACT	SURFACE OWNER	TAX PARCEL	Т	CREWS MICAH J & TERRA J	3-L8-33.3
2	NOLAN JOHN A JR	3-L11-61	U	CREWS MICAH J & TERRA J	3-L8-33.11
3	NOLAN JOHN A JR	3-L11-66	V	SHILLING ROBERT A SR	3-L8-33
4	WV STATE DEP OF HIGHWAYS	US ROUTE	W	RAILING BILL	3-L8-12.7
		40	X	PORTER MATHEW L & STEPHANIE	3-L8-12.14
5	WINTERS FAMILY FARM LLC	3-L11-28	Y	TUNNEL RIDGE LLC	3-L8-12.3
6	DAVIS DAVID E JR	.3-L8-35	Z	FRIO JAMES W	3-L8-12
7	JONES ROBERT C	3-L8-11.1	AA	PORTER S A; KNOLLINGER B & GERLING	3-L8-3
8	KNIGHT CRAIG C & KATHLEEN	3-L8-33.5	AD	K K & MARQUART K L	
9	SHILLING ROBERT A SR	3-L8-33	AB	KINNEY KATHY J & JOSEPH H	3-L8-6
10	ZAAYER THOMAS R	3-L8-33.14	AC	KINNEY KATHY J & JOSEPH H	3-L8-5
11	HUDRLIK THOMAS P & TERESA	3-L8-12.12	AD	LINK RICHARD C	3-L5-22.4
12	JONES ROBERT C	3-L8-11	AE	LINK RICHARD CHARLES	3-L5-22.3
13	RAILING BIL	3-L8-12.8	AF	LINK ROBERT W JR & D M (LIFE) & LINK RICHARD C	3-L5-22.6
14	TUSTIN VICKI L & DANIEL P	3-L8-12.6	AG	LINK RICHARD C	3-L5-22.1
15	TUSTIN DANIEL PAUL JR	3-L8-12.11	AH	WADDELL DAVID A	3-L5-23.5
16	BLOOMFIELD R RICHARD	3-L8-12.10	Al	LINK EDWARD R & ELIZABETH A	3-L5-22.5
17	BECK BARNETT E & LAURIE L	3-L8-12.5	AJ	LINK EDWARD R & ELIZABETH A	3-L5-22.2
18	RAAB BERNARD T & MARJORIE A	3-L8-7	AK	LINK EDWARD ROBERT & ELIZABETH ANN	3-L5-21.1
19	RAAB DANIEL A & CANDICE M CADDIES	3-L8-7.1	AL	YOUNG DAVID M & P J	3-L5-13.1
20	BURROWS JENNIFER G	3-L8-4.1	AM	FARMER CLARENCE S SR & C	3-L5-14.1
21	DOYLE PAUL DAVID & DAWN M	3-L8-4	AN	DILLE RONALD A ET AL	3-L5-2
22	KNOLLINGER WALTER W JR & MONA DEE	3-L5-23.4	AO	LIFE & LIBERTY EQUESTRIAN CENTER LLC	3-L5-1.1
23	LINK EDWARD & ELIZABETH	3-L5-23.7	AP	MILLER PETER R & CHERYL	3-L4-121
24	LINK EDWARD R & ELIZABETH A	3-L5-22	AQ	LOUGH DANIEL R SR & PE	3-L4-121 3-L5-1.2
25	PRINCE DONALD D	3-L5-24	AR	TAGGART SHIRLEY TOD	3-L1-41
26	YOUNG CASEY P & DEVAN M	3-L5-13	AS	MILLER JOHN L	3-L2-7.1
27	TAGGART SHIRLEY J	3-L5-3	AT	MINDA JOHN P & CHARLOTTE MAE	3-L5-3.1
	ADJOINING OWNERS TABLE		AU	PAVLIC YORK	3-L5-5.1
TRACT	SURFACE OWNER	TAX PARCEL	AV	TAGGART SHIRLEY - TOD	3-L5-5.3
Α	KLAGES LLOYD A JR	3-L11-46.18	AW	WILLIAMS NANCY LEE & DAVID B	
В	WATSON GARY L & ROSE	3-L11-55.1	AX	MONROE E L & S J	3-L5-5.4 3-L5-7
С	WEASE DUANE L & RHONDA L.	3-L11-55.2	AY	MONROE GENE & SHIRLEY	
D	DAVIS DONNA E & WEASE RHONDA	3-L11-49	AZ	DOLENCE DONALD F & J L	3-L5-7.3
E	ROTTER C J & GRACE A	3-L11-53	BA	RATCLIFFE TRAVIS CHRISTOPHER (LE)	3-L5-11
F	ROTTER C J & GRACE A	3-L11-52	BB		3-L5-12.1
G	DAVIS DONNA E & DANIEL R	3-L11-50	BC	RATCLIFFE TRAVIS C	3-L5-12
Н	DAVIS DONNA EVANS & DANIEL R	3-L11-49.2	BD	RATCLIFFE MICHAEL T	3-L5-12.4
ı	ROTTER CARL J & GRACE A	3-L11-64	טט	JOHNSTON ANN & WILLIAM H JR	/ <del>14/202</del> 3
VICIONE.				<u> </u>	

ADJOINING OWNERS TABLE

TAX PARCEL

SURFACE OWNER

TRACT

REVISIONS: SWN COMPANY: Production Company, LLC Production Company™ OPERATOR'S CARL ROTTER OHI WELL #: 3H DISTRICT: LIBERTY COUNTY: OHIO STATE:

	ADJOINING OWNERS TABLE	
TRACT	SURFACE OWNER	TAX PARCEL
BE	PRINCE DONALD D	3-L5-25
BF	PRINCE DONALD D	3-L5-11.2
BG	SMITH SUZAN LOUISE	3-L5-27
ВН	SMITH SUSAN NORTHWOOD & SMITH RICHARD ALAN	3-L5-23.1
ВІ	MILLER JASON & RACHEL	3-L5-23.3
ВЈ	RITCHEA DALE R & JACKIE A	3-L5-23.2
ВК	WADDELL DONALD L & DEBORAH JO	3-L5-23.6
BL	WADDELL DONALD L & DEBORAH JO	3-L5-23
вМ	WADDELL DONALD L & D J	3-L8-39
BN	DILLE STEVEN	3-L8-8
во	BROWN NEAL P	3-L8-9.6
BP	DILLE SCOTT A & JILL L	3-L8-9.3
BQ	PORTER GEORGE E III & M A LIVING TRUST	3-L8-9.5
BR	REASS JOSHUA S & HOLLY C HOLLOWAY	3-L9-1
BS	SHILLING JODY LEE	3-L8-10
ВТ	CREIGHTON RANDY J	3-L8-11.2
BU	MAIN PAUL A	3-L8-10.1
BV	WHEAT RICHARD C & K J	3-L8-10.2
BW	BALL LARRY G	3-L8-42
ВХ	HARDMAN SUSAN J H	3-L8-37
BY	ADAMS BERNARD T & PATRICIA	3-L8-37.1
BZ	WINTERS HOWARD	3-L8-36
CA	HOWARD WINTERS	3-L11-28.1
СВ	CREIGHTON RANDY J	3-L11-29
CC	MAZGAJ MILDRED J	3-L11-62
CD	TUNNELL RIDGE LLC	3-L12-32
CE	GRIFFITH SHARON & WARREN	3-L11-60.1
CF	TUSTIN DANIEL P JR	3-L8-12.9
CG	KLUG JOSEPH T	3-L8-34.1
СН	SHILLING ROBERT A SR	3-L8-33.9

04/14/2023

REVISIONS:	COMPANY:	SWN Production Company, LLC	Pro	duction Company™
	OPERATOR'S WELL #:	CARL ROTT 3H	ER OHI	DATE: 02-23-2023 API NO: 47-103-XXXXX DRAWN BY:Z. WOOD
	DISTRICT: LIBERTY	COUNTY: OHIO	STATE: WV	SCALE: N/A DRAWING NO:2018-153 WELL LOCATION PLAT

### INFORMATION SUPPLIED UNDER WEST VIRGINIA CODE Chapter 22, Article 6A, Section 5(a)(5) IN LIEU OF FILING LEASE(S) AND OTHER CONTINUING CONTRACT(S)

Under the oath required to make the verification on page 1 of this Notice and Application, I depose and say that I am the person who signed the Notice and Application for the Applicant, and that -

- (1) the tract of land is the same tract described in this Application, partly or wholly depicted in the accompanying plat, and described in the Construction and Reclamation Plan;
- (2) the parties and recordation data (if recorded) for lease(s) or other continuing contract(s) by which the Applicant claims the right to extract, produce or market the oil or gas are as follows:

Lease Name or Number

Grantor, Lessor, etc.

Grantee, Lessee, etc.

Royalty

Book/Page

See Exhibit A

### Acknowledgement of Possible Permitting/Approval In Addition to the Office of Oil and Gas

The permit applicant for the proposed well work addressed in this application hereby acknowledges the possibility of the need for permits and/or approvals from local, state, or federal entities in addition to the DEP, Office of Oil and Gas, including but not limited to the following:

- WV Division of Water and Waste Management
- WV Division of Natural Resources WV Division of Highways
- U.S. Army Corps of Engineers
- U.S. Fish and Wildlife Service
- County Floodplain Coordinator

RECEIVED Gas

MAR 0 8 2023

WV Department of Environmental Protection

The applicant further acknowledges that any Office of Oil and Gas permit in no way overrides, replaces, or nullifies the need for other permits/approvals that may be necessary and further affirms that all needed permits/approvals should be acquired from the appropriate authority before the affected activity is initiated.

Well Operator:	SWN Production Co., LLC	Am North
By:		Gavin Nadeau, RPL
Its:		Landman

Page 1 of 4

EXHIBIT "A"  Carl Rotter OHI 3H  Ohio County, West Virginia  Attached to and made a part of the State of West Virginia Oil and Gas Permit Form, WW-6A1, by SWN Production Company, LLC., Operator						
#	TMP 03-0L11-0054-0000	LESSOR	LESSEE	ROYALTY	BK/PG	% INTEREST NOT LEASED BY PRODUCTION COMPANY, LI
1)		Carl J. Rotter and Grace A. Rotter, husband and wife	Chesapeake Appalachia, L.L.C. SWN Production Company, LLC	12.50%	791/16 885/248	0.00%
2)	03-0L11-0061-0000	John A. Nolan, Jr.	Chesapeake Appalachia, L.L.C.	18.00%	837/743	0.00%
3)	03-0L11-0066-0000	John A. Nolan, Jr.	SWN Production Company, LLC Chesapeake Appalachia, L.L.C.	18.00%	885/728 837/743	0.0078
4)	US 40	West Virginia Department of Transportation, Division of Highways	SWN Production Company, LLC		885/728	0.00%
			Chesapeake Appalachia, L.L.C. SWN Production Company, LLC	15.00%	830/11 883/611	0.00%
5)	03-0L11-0028-0000	Marshall W. Deitt and Janet L. Deitt, husband and wife	Fossil Creek Ohio, LLC	18.00%	871/730	
			Gulfport Energy Corporation American Petroleum Partners Operating, LLC		893/379 909/775	
		Howard Louis Winters, married	SWN Production Company, LLC		946/405	2000
			Fossil Creek Ohio, LLC Gulfport Energy Corporation	18.00%	871/732 893/379	
			American Petroleum Partners Operating, LLC		909/775	
		Paul J. Winters and Linda A. Winters, husband and wife	SWN Production Company, LLC Fossil Creek Ohio, LLC	18.00%	946/405 871/736	0.00%
			Gulfport Energy Corporation American Petroleum Partners Operating, LLC		893/379	
			SWN Production Company, LLC		909/775 946/405	
		David D. Winters and Marylee Winters, husband and wife	Fossil Creek Ohio, LLC	18.00%	871/742	made.
			Gulfport Energy Corporation American Petroleum Partners Operating, LLC		893/379 909/775	
5)	03-00L8-0035-0000	David Elwood Davis, Jr., single	SWN Production Company, LLC	10.0004	946/405	
			Chesapeake Appalachia, L.L.C. SWN Production Company, LLC	18.00%	829/791 885/656	0.00%
()	03-00L8-0011-0001 03-00L8-0033-0005	CNX Gas Company LLC Shirley A. Knight, a widow and Craig C. Knight and Kathleen Knight, his wife	SWN Production Company, LLC	21.00%	947/657	0.00%
į.	11 11 11 11 11 11 11	- Angli and Raulicen Kingin, ins wife	NPAR, LLC Chevron U.S.A., Inc.	18.00%	814/347 827/269	
			Chesapeake Appalachia, L.L.C.		858/359	0.00%
)	03-00L8-0033-0000	Robert A. Shilling, Jr.	SWN Production Company, LLC Chesapeake Appalachia, L.L.C.	18.00%	883/611 820/582	
****		Karen C. Shilling, f/k/a Karen C. Viola	SWN Production Company, LLC		885/596	enc.
			Chesapeake Appalachia, L.L.C. SWN Production Company, LLC	18.00%	820/587 885/596	12/22/
		Jody Lee Klug	Chesapeake Appalachia, L.L.C. SWN Production Company, LLC	18.00%	820/592	- 0.00%
		C. Murray Shilling	Chesapeake Appalachia, L.L.C.	18.00%	885/596 820/629	mar .
0)	03-00L8-0033-0014	Thomas R. Zaayer, single	SWN Production Company, LLC Chesapeake Appalachia, L.L.C.	18.00%	885/596 867/207	
)	03-00L8-0012-0012	Thomas P. Hudrlik and Teresa Hudrlik, husband and wife	SWN Production Company, LLC	,53,507,000,01	883/778	0.00%
177			Chesapeake Appalachia, L.L.C. SWN Production Company, LLC	18.00%	869/136 883/778	0.00%
)	03-00L8-0011-0000 03-00L8-0012-0008	CNX Gas Company LLC William Railing and Mary E. Railing, husband and wife	SWN Production Company, LLC	18.00%	947/651	0.00%
	0000	Than coming and Mary E. Coming, incoming and wife	TriEnergy Holdings, LLC NPAR, LLC	16.00%	805/77 825/767	
			Chevron U.S.A. Inc.		827/254	0.00%
			Chesapeake Appalachia, L.L.C. SWN Production Company, LLC		858/359 883/623	
)	03-00L8-0012-0006	Daniel Paul Tustin, Sr. and Vicki Lynn Tustin, husband and wife	Chesapeake Appalachia, L.L.C. SWN Production Company, LLC	18.00%	814/418	0.00%
)	03-00L8-0012-0011	Daniel Paul Tustin, Jr., single	Chesapeake Appalachia, L.L.C.	12.50%	885/548 792/229	0.0004
)	03-00L8-0012-0010	R. Richard Bloomfield and Lynnette Louise Bloomfield, husband and wife	SWN Production Company, LLC	11.000/	885/248	0.00%
			Chesapeake Appalachia, L.L.C. SWN Production Company, LLC	14.00%	863/163 883/766	0.00%
)	03-00L8-0012-0005	Barnett Edward Beck and Laurie L. Beck, husband and wife	Chesapeake Appalachia, L.L.C. SWN Production Company, LLC	12.50%	792/234	0.00%
)	03-00L8-0007-0000	Bernard T. Raab and Marjorie A. Raab, husband and wife	Chesapeake Appalachia, L.L.C.	18.00%	885/248 869/461	0.00%
)	03-00L8-0007-0001	Bernard T. Raab and Marjorie A. Raab, husband and wife	SWN Production Company, LLC Chesapeake Appalachia, L.L.C.	10.000/	883/778	0.00%
)	03-00L8-0004-0001		SWN Production Company, LLC	18.00%	869/461 883/778	0.00%
	03-00L8-0004-0001	William Lawrence Urban, a married man dealing in his sole and separate property  Marilyn A. Osterfund Tally, married	SWN Production Company, LLC SWN Production Company, LLC	18.00% 18.00%	951/568	
		Sharr Renee Ballweg, married	SWN Production Company, LLC	18.00%	951/574 952/37	
		John Thomas Urban, married Robert Naegele, married	SWN Production Company, LLC SWN Production Company, LLC	18.00% 18.00%	952/552 953/23	
		David E. Osterfund, married Christopher David Osterfund, single	SWN Production Company, LLC	18.00%	953/29	
		David Lawrence Osterfund, Jr., single	SWN Production Company, LLC SWN Production Company, LLC	18.00% 18.00%	953/35 953/41	
		Kent Naegele, married	SWN Production Company, LLC	18.00%	953/424	-
		Carol Weeks, married Linda Abbott Sutton, married	SWN Production Company, LLC SWN Production Company, LLC	18.00% 18.00%	953/430 953/482	
		Joy Abbott, widow	SWN Production Company, LLC	18.00%	953/488	
		Shawn Diane Osterfund, single Ceceylia Kay Abbott, widow	SWN Production Company, LLC SWN Production Company, LLC	18.00% 18.00%	953/758 953/776	
*********		Mary Woelfel, married	SWN Production Company, LLC	18.00%	954/435	0.00%
		Kaytlyn Tarese Sheard, married Shane Cleary, widower	SWN Production Company, LLC SWN Production Company, LLC	18.00% 18.00%	954/548 954/565	0.0028
		Patrick O'Donnell Cramer, II, married	SWN Production Company, LLC	18.00%	955/382	
		Charles T. Corn, widower, Lisa L. Martin, Philip G. Jewett, and Kristen J. Reeves Lisa Larsen, married	SWN Production Company, LLC SWN Production Company, LLC	18.00% 18.00%	955/394 956/274	
******		Sherry A. Brown, single	SWN Production Company, LLC	18.00%	956/292	
		Linda James, married Stephen P. Cramer, single	SWN Production Company, LLC SWN Production Company, LLC	18.00% 18.00%	956/529 956/751	
-		Mark Irvin Cramer, married	SWN Production Company, LLC	18.00%	957/388	
		Jacquelyn Louise Carlucci, married	SWN Production Company, LLC	18.00%	957/592	
		Noah Osterfund Ballweg, single				
		Noah Osterfund Ballweg, single Natalie Von Wright Cramer, married The Qualified Terminable Interest Trust by the Last Will & Testament of James Cole Abbott	SWN Production Company, LLC SWN Production Company, LLC SWN Production Company, LLC	18.00% 18.00% 18.00%	958/278 959/266 959/297	

RECEIVED
Office Of Oil and Gas

MAR 08 2073

WV Department of Environmental Protection

EXHIBIT "A"  Carl Rotter OHI 3H  Ohio County, West Virginia  Attached to and made a part of the State of West Virginia Oil and Gas Permit Form, WW-6A1, by SWN Production Company, LLC., Operator							
#	ŤMP	LESSOR	LESSEE	ROYALTY	BK/PG	% INTEREST NOT LEASED BY SW PRODUCTION COMPANY, LLC	
21)	03-00L8-0004-0000	William Lawrence Urban, a married man dealing in his sole and separate property	SWN Production Company, LLC	18.00%	951/568		
		Marilyn A. Osterfund Tally, married	SWN Production Company, LLC	18.00%	951/574	mbani .	
		Sharr Renee Ballweg, married	SWN Production Company, LLC	18.00%	952/37	9440	
		John Thomas Urban, married	SWN Production Company, LLC	18.00%	952/552	****	
		Robert Naegele, married	SWN Production Company, LLC	18.00%	953/23	700	
_		David E. Osterfund, married	SWN Production Company, LLC	18.00%	953/29	****	
		Christopher David Osterfund, single	SWN Production Company, LLC	18.00%	953/35	man,	
		David Lawrence Osterfund, Jr., single	SWN Production Company, LLC	18.00%	953/41	Moderat	
-		Kent Naegele, married	SWN Production Company, LLC	18.00%	953/424		
~~~		Carol Weeks, married	SWN Production Company, LLC	18.00%	953/430	NAME OF THE PARTY	
		Linda Abbott Sutton, married	SWN Production Company, LLC	18.00%	953/482	MANUAL TO A STATE OF THE STATE	
		Joy Abbott, widow	SWN Production Company, LLC	18.00%	953/488	200	
		Shawn Diane Osterfund, single	SWN Production Company, LLC	18.00%	953/758	9000	
5000		Ceceylia Kay Abbott, widow	SWN Production Company, LLC	18.00%	953/776		
		Mary Woelfel, married	SWN Production Company, LLC	18.00%	954/435	er te	
		Kaytlyn Tarese Sheard, married	SWN Production Company, LLC	18.00%	954/548	0.00%	
		Shane Cleary, widower	SWN Production Company, LLC	18.00%	THE CONTRACTOR STREET,	***	
		Patrick O'Donnell Cramer, II, married	SWN Production Company, LLC		954/565		
		Charles T. Corn, widower, Lisa L. Martin, Philip G. Jewett, and Kristen J. Reeves	SWN Production Company, LLC	18.00%	955/382		
******		Lisa Larsen, married		18.00%	955/394	***	
		Sherry A. Brown, single	SWN Production Company, LLC SWN Production Company, LLC	18.00%	956/274		
		Linda James, married		18.00%	956/292	224	
		Stephen P. Cramer, single	SWN Production Company, LLC	18.00%	956/529	of the second se	
		Mark Irvin Cramer, married	SWN Production Company, LLC	18.00%	956/751	may .	
		Jacquelyn Louise Carlucci, married	SWN Production Company, LLC	18.00%	957/388		
		Noah Osterfund Ballweg, single	SWN Production Company, LLC	18.00%	957/592	and a second	
-		Natalie Von Wright Cramer, married	SWN Production Company, LLC	18.00%	958/278	5000 6000	
		The Qualified Terminable Interest Trust by the Last Will & Testament of James Cole Abbott	SWN Production Company, LLC	18.00%	959/266	900	
	***************************************	Katherine C. Green, married	SWN Production Company, LLC	18.00%	959/297		
		Luther Memorial Church of Madison, Wisconsin	SWN Production Company, LLC	18.00%	967/416	and .	
2)	03-00L5-0023-0004	Walter W. Knollinger, Jr. and Mona Dee Knollinger, husband and wife	SWN Production Company, LLC	18.00%	969/127		
6	** ************************************	Water W. Perotinger, St. and World Dee Khollinger, nusband and wife	Great Lakes Energy Partners, L.L.C.	12.50%	778/773		
			Chesapeake Appalachia, L.L.C.		808/391	0.00%	
1)	03-001.5-0023-0007	Edward Pohort Lieb and Elimbat & J. L.	SWN Production Company, LLC		883/515		
1	05 00E5-0025-0007	Edward Robert Link and Elizabeth A. Link, as joint tenants with right of survivorship	Range Resources-Appalachia, LLC	15.00%	851/536		
			Chesapeake Appalachia, L.L.C.		808/455	0.00%	
1)	03-00L5-0022-0000	Photo ID 1 (1) 1 (m) 1 (d) 1)	SWN Production Company, LLC		883/539		
1)	03-001,3-0022-0000	Edward Robert Link and Elizabeth A. Link, as joint tenants with right of survivorship	Range Resources-Appalachia, LLC	15.00%	851/536		
			Chesapeake Appalachia, L.L.C.		808/455	0.00%	
			SWN Production Company, LLC		883/539		

RECEIVED Office Of Oil and Gas

MAR 08 2023

WV Department of Environmental Protection

Carl Rotter OHI 3H WW-6A1 Page 2 of 3

	Carl R	ITBIT "A"  tter OHI 3H  ty, West Virginia			
ТМР	LESSOR	LESSEE	ROYALTY	вк/РС	% INTEREST NOT LEASED B PRODUCTION COMPANY,
03-001.5-0024-000	0 Sharon Grace Porter	Chesapeake Appalachia, L.L.C.	18.00%	833/304	The section comments
	The Estate of Charles Montgomery Eberhardt by and through Monica J. Franklin, Executrix	SWN Production Company, LLC	20.000	885/668	minu.
		Chesapeake Appalachia, L.L.C. SWN Production Company, LLC	20.00%	840/578 885/668	
	D. Pauline Archer, a widow	Chesapeake Appalachia, L.L.C.	18.00%	827/643	enter a series and
	Gary Farrar	SWN Production Company, LLC Chesapeake Appalachia, L.L.C.	19.0007	885/656	100
	William Ross Krumme	SWN Production Company, LLC	18.00%	828/320 885/668	
	Tool Tool Tool Tool Tool Tool Tool Tool	Chesapeake Appalachia, L.L.C.	18.00%	831/479	
	Marlene Lambert	SWN Production Company, LLC Chesapeake Appalachia, L.L.C.	18.00%	885/656 832/46	mon,
	Gwen L. Leistner	SWN Production Company, LLC		885/668	
	D. I. C.	Chesapeake Appalachia, L.L.C. SWN Production Company, LLC	18.00%	828/269 885/668	
	Robert Eugene Main	Chesapeake Appalachia, L.L.C.	18.00%	826/753	Service.
	Gene Masteller	SWN Production Company, LLC	10.000	885/656	
	Path Poulse, McG	Chesapeake Appalachia, L.L.C. SWN Production Company, LLC	18.00%	826/768 885/668	
	Beth Darlene McCammon, single	Chesapeake Appalachia, L.L.C.	18.00%	826/758	
	Wilda M. Moore, widow	SWN Production Company, LLC Chesapeake Appalachia, L.L.C.	19 0007	885/656	at As
	C. Lucille Oberman, widow	SWN Production Company, LLC	18.00%	827/638 885/656	
	or statute obstraint, wildow	Chesapeake Appalachia, L.L.C.	18.00%	827/633	ma.
	Dena Pogue, single	SWN Production Company, LLC Chesapeake Appalachia, L.L.C.	18.00%	885/656 832/51	***
	Jennifer Pogue, single	SWN Production Company, LLC		885/668	
		Chesapeake Appalachia, L.L.C. SWN Production Company, LLC	18.00%	828/315	
	Linda Ann McCammon Porter	Chesapeake Appalachia, L.L.C.	18.00%	885/668 826/391	
	Gail K. Spence	SWN Production Company, LLC		885/656	44.
	Morto Elimbet O. C. L.	Chesapeake Appalachia, L.L.C. SWN Production Company, LLC	18.00%	828/301 885/668	
	Martha Elizabeth Strohecker, single	Chesapeake Appalachia, L.L.C.	18.00%	826/763	
	Ethel L. Denges a/k/a Ethel Lynn Krumme	SWN Production Company, LLC Chesapeake Appalachia, L.L.C.	18.00%	885/656	and the second s
	Sandra W. Weckessar a/k/a/ Sandra K. Weaver	SWN Production Company, LLC	13.0070	831/501 885/656	
		Chesapeake Appalachia, L.L.C. SWN Production Company, LLC	18.00%	833/605	
	Joann Chegan, single	Chesapeake Appalachia, L.L.C.	18.00%	885/668 832/74	-
	William B. Pogue	SWN Production Company, LLC		885/668	0.00%
		Chesapeake Appalachia, L.L.C. SWN Production Company, LLC	18.00%	832/27 885/668	
	Linda Masteller McClendon	Chesapeake Appalachia, L.L.C.	18.00%	835/45	
	Patricia Kirkbride, single	SWN Production Company, LLC Chesapeake Appalachia, L.L.C.	10.0004	885/668	
	James I. Masteller	SWN Production Company, LLC	18.00%	838/720 885/668	
		Chesapeake Appalachia, L.L.C.	18.00%	835/160	
	John E. Masteller, a married man dealing in his sole and separate property	SWN Production Company, LLC Chesapeake Appalachia, L.L.C.	18.00%	885/668 835/154	
	Tamara Kerr	SWN Production Company, LLC		885/668	
		Chesapeake Appalachia, L.L.C. SWN Production Company, LLC	18.00%	841/715	
	William C. Reed	Chesapeake Appalachia, L.L.C.	18.00%	885/668 840/645	
10 0	Beverly D. Hertig, widow	SWN Production Company, LLC Chesapeake Appalachia, L.L.C.	19 009/	885/668	
	Billie Sprowls	SWN Production Company, LLC	18.00%	837/190 885/668	
	Diffic Sprowis	Chesapeake Appalachia, L.L.C.	18.00%	846/105	190
	Jason E. Martin	SWN Production Company, LLC Chesapeake Appalachia, L.L.C.	18.00%	885/668 869/117	
	Robert Wardle	SWN Production Company, LLC	10.0070	883/778	
		Chesapeake Appalachia, L.L.C. SWN Production Company, LLC	18.00%	860/144	
	Eleanor B. Riggs	Chesapeake Appalachia, L.L.C.	18.00%	883/766 860/149	
	Nadine Montgomery McDowell	SWN Production Company, LLC		883/766	
		Chesapeake Appalachia, L.L.C. SWN Production Company, LLC	18.00%	862/107 883/766	
	Jessica Byrd Gabenhorst f/k/a Jessica L. Byrd, single	Chesapeake Appalachia, L.L.C.	18.00%	869/439	
	Jeremy Owen Byrd, single	SWN Production Company, LLC Chesapeake Appalachia, L.L.C.	18.00%	883/778 869/445	
	Susan D. Digiandomenico, a/k/a Susan DiGiandomen	SWN Production Company, LLC		883/778	
		Chesapeake Appalachia, L.L.C. SWN Production Company, LLC	18.00%	873/144	
	James Robert Johnson	Chesapeake Appalachia, L.L.C.	18.00%	883/766 874/257	
	Heather L. Montgomery, single	SWN Production Company, LLC		885/548	
		Chesapeake Appalachia, L.L.C. SWN Production Company, LLC		877/594 895/498	
	Ian L. Montgomery, single	Chesapeake Appalachia, L.L.C.	18.00%	873/175	
03-00L5-0013-0000	Sean J. Young	SWN Production Company, LLC Chesapeake Appalachia, L.L.C.		885/536 835/649	
	David M. Young	SWN Production Company, LLC		885/716	
		Chesapeake Appalachia, L.L.C. SWN Production Company, LLC	18.00%	835/744	
	Carole C. Del Bonis	Chesapeake Appalachia, L.L.C.		885/716 836/730	
	Maureen A. Ridgely	SWN Production Company, LLC		885/716	0.00%
		Chesapeake Appalachia, L.L.C. SWN Production Company, LLC		836/769	0.00%
	James T. Boggs and Susan V. Young Boggs, a/k/a Susan V. Boggs, husband and wife	Chesapeake Appalachia, L.L.C.		885/716 836/764	
	Casey S. Landry	SWN Production Company, LLC		885/716	
03-00L5-0003-0000		Chesapeake Appalachia, L.L.C. SWN Production Company, LLC		838/67 885/716	
03-0013-0003-0000	Joseph P. Taggart and Shirley J. Taggart, husband and wife	Chesapeake Appalachia, L.L.C.	18.00%	814/533	
	Michael T. Ratcliffe	SWN Production Company, LLC Chesapeake Appalachia, L.L.C.		883/563	0,00%
		SWN Production Company, LLC	15.00%	795/622	RECEIVED

MAR 08 2023

WV Department of Environmental Protection

Carl Rotter OHI 3H WW-6A1 Page 3 of 3



SWN Production Company, LLC 1300 Fort Pierpont Dr, Ste 201 Morgantown, WV 26508 Tel: 304 884 1610 Fax: 304 471 2497 www.swn.com

February 22, 2023

Mr. Charles Brewer WV DEP Office of Oil & Gas 601 57<sup>th</sup> St., SE Charleston, WV 25304

RE: SWN's proposed New Well: Carl Rotter OHI 3H in Ohio County, West Virginia, Drilling under National Road, Atkinson Potomac Hill Road, and Shanghai and Murray Road.

Dear Mr. Brewer:

SWN Production Company, LLC ("SWN") is applying for a drilling permit for the above referenced well. The State of West Virginia has raised some concern as to SWN's right to drill under National Road, Atkinson Potomac Hill Road, and Shanghai and Murray Road. Please be advised that SWN has leased all mineral owners under said route as it relates to the above-referenced well and unit.

Respectfully,

SWN Production Company, LLC

Gavin Nadeau, RPL

Landman

RECEIVED Office Of Oil and Gas

WV Department of The Right/Repin (b) Train Fight/Repin (b) Train wisely investing the cash flow from our underlying Assets, will create Value+®

### Horizontal Natural Gas Well Work Permit **Application Notice By Publication**

Notice is hereby given:  Pursuant to West Virginia Code 22-6A-10(e) prior to filing an application for a permit for a horizontal well the applicant shall publish in the county in which the well is located or is proposed to be located a Class II legal advertisement.
Paper: The Intelligencer
Public Notice Date: February 22, 2023 & March 1, 2023
The following applicant intends to apply for a horizontal natural well work permit which disturbs three acres or more of surface excluding pipelines, gathering lines and roads <b>or</b> utilizes more than two hundred ten thousand gallons of water in any thirty day period.
Applicant: SWN Production Company, LLC / Well Number: Carl Rotter OHI 3H
Address: 1300 Fort Pierpont Drive., Suite 201
Morgantown, WV 26508
Business Conducted: Natural gas production.
Location –
State: West Virginia / County: Ohio / District: Liberty Quadrangle: Valley Grove
UTM Coordinate NAD83 Northing: 4,439,125 /
UTM coordinate NAD83 Easting: 539,000 . Watershed: Upper Ohio South
Coordinate Conversion:  To convert the coordinates above into longitude and latitude, visit: <a href="http://tagis.dep.wv.gov/convert/llutm_conus.php">http://tagis.dep.wv.gov/convert/llutm_conus.php</a>
Electronic notification:  To receive an email when applications have been received or issued by the Office of Oil and Gas, visit <a href="http://www.dep.wv.gov/insidedep/Pages/DEPMailingLists.aspx">http://www.dep.wv.gov/insidedep/Pages/DEPMailingLists.aspx</a> to sign up.
Reviewing Applications: Copies of the proposed permit application may be reviewed at the WV Department of Environmental Protection headquarters, located at 601 57 <sup>th</sup> Street, SE Charleston, WV 25304 (304-926-0450). Full copies or scans of the proposed permit application will cost \$15, whether mailed or obtained at DEP headquarters. Copies may be requested by calling the office or by sending an email to <a href="mailto:DEP.comments@wv.gov">DEP.comments@wv.gov</a> .
Submitting Comments:  Comments may be submitted online at <a href="https://apps.dep.wv.gov/oog/comments/comments.cfm">https://apps.dep.wv.gov/oog/comments/comments.cfm</a> , or by letter to Permit Review. Office of Oil and Gas. 601 57th Street SE Charleston, WV, 25304. Please reference the county, well number.

Street, SE Charleston, WV 25304. Please reference the county, Well Number, Office Of Oil and Gas and operator when using this option.

Regardless of format for comment submissions, they must be received no later than thirty days after the permit 2023 application is received by the Office of Oil and Gas.

WV Department of Environmental Protection

For information related to horizontal drilling visit: <a href="www.dep.wv.gov/oil-and-gas/pages/default.aspx">www.dep.wv.gov/oil-and-gas/pages/default.aspx</a>

# STATE OF WEST VIRGINIA DEPARTMENT OF ENVIRONMENTAL PROTECTION, OFFICE OF OIL AND GAS NOTICE CERTIFICATION

Date of Noti	ce Certification:	API No. 47-	009 _	
		Operator's V		I Rotter⊕HI 3H
		Well Pad Na		
Notice has	been given:		5554	
Pursuant to the	e provisions in West Virginia Code	§ 22-64, the Operator has provided the requi	red nartice	with the Notice Forms listed
ocion for the	tract of failu as follows.		P	1,0000000000000000000000000000000000000
State:	West Virginia		39000.38	
County:	069-Ohio		439125.47	PARTIE,
District:	Liberty	Public Road Access:	Rogers Road	
Quadrangle:	Valley Grove	Generally used farm name: C	arl Rotter	
Watershed:	Upper Ohio South			
it has provide information re of giving the requirements Virginia Code	ed the owners of the surface described and control of the surface described and control of the surface owner notice of entry to subsection (b), section sixteen control of subsection (b), section sixteen control of subsection (b).	every permit application filed under this shall contain the following information: (14) libed in subdivisions (1), (2) and (4), subsection sixteen of this article; (ii) that the requirement purvey pursuant to subsection (a), section tender this article were waived in writing by the tender proof of and certify to the secretary than it.	A certificati tion (b), securement was of this arti	tion from the operator that (i) ction ten of this article, the deemed satisfied as a result ticle six-a; or (iii) the notice
mat the Ope	West Virginia Code § 22-6A, the Operator has properly served the require CK ALL THAT APPLY	perator has attached proof to this Notice Certified parties with the following:	ification	OOG OFFICE USE ONLY
☐ 1. NOT	TCE OF SEISMIC ACTIVITY or	NOTICE NOT REQUIRED BECAUSE SEISMIC ACTIVITY WAS CONDUCTED	E NO D	RECEIVED/ NOT REQUIRED
■ 2. NOT	TICE OF ENTRY FOR PLAT SURV	VEY or NO PLAT SURVEY WAS CON	DUCTED	□ RECEIVED
■ 3. NOT	ICE OF INTENT TO DRILL or	☐ NOTICE NOT REQUIRED BECAUSE NOTICE OF ENTRY FOR PLAT SURVEY WAS CONDUCTED or		☐ RECEIVED/ NOT REQUIRED
		☐ WRITTEN WAIVER BY SURFACE (PLEASE ATTACH)	[	
■ 4. NOT	ICE OF PLANNED OPERATION		Office Of C	IVED Gas DILAND GAS DILAND GAS
■ 5. PUB	LIC NOTICE		MAR	RECEIVED
■ 6. NOT	ICE OF APPLICATION		WV DE	partment of Protection ental RECEIVED

### Required Attachments:

The Operator shall attach to this Notice Certification Form all Notice Forms and Certifications of Notice that have been provided to the required parties and/or any associated written waivers. For the Public Notice, the operator shall attach a copy of the Class II Legal Advertisement with publication date verification or the associated Affidavit of Publication. The attached Notice Forms and Certifications of Notice shall serve as proof that the required parties have been noticed as required under West Virginia Code § 22-6A. Pursuant to West Virginia Code § 22-6A-11(b), the Certification of Notice to the person may be made by affidavit of personal service, the return receipt card or other postal receipt for certified mailing.

### Certification of Notice is hereby given:

THEREFORE, I Brittany Woody , have read and understand the notice requirements within West Virginia Code § 22-6A. I certify that as required under West Virginia Code § 22-6A, I have served the attached copies of the Notice Forms, identified above, to the required parties through personal service, by registered mail or by any method of delivery that requires a receipt or signature confirmation. I certify under penalty of law that I have personally examined and am familiar with the information submitted in this Notice Certification and all attachments, and that based on my inquiry of those individuals immediately responsible for obtaining the information, I believe that the information is true, accurate and complete. I am aware that there are significant penalties for submitting false information, including the possibility of fine and imprisonment.

Well Operator: SWN Production Co., LLC

By:

Brittany Woody

Its: Telephone: Senior Regulatory Analy

304-884-1610

Address:

1300 Fort Pierpont Dr., Suite 201

Morgantown, WV 26508

Facsimile:

304-884-1690

Email:

Brittany\_Woody@swn.com



Subscribed and sworn before me this 2300 day of Februay, Notary Public

My Commission Expires

Oil and Gas Privacy Notice:

The Office of Oil and Gas processes your personal information, such as name, address and telephone number, as part of our regulatory duties. Your personal information may be disclosed to other State agencies or third parties in the normal course of business or as needed to comply with statutory or regulatory requirements, including Freedom of Information Act requests. Our office will appropriately secure your personal information. If you have any questions about our use or your personal information, please contact DEP's Chief Privacy Officer at depprivacyofficer@wv.gov.

> RECEIVED
> Office Of Oil and Gas MAR 08 2023 WV Department of Environmental Protection

WW-6A (9-13)

API NO. 47- 009 OPERATOR WELL NO. Carl Rotter OHI 3H
Well Pad Name: Carl Rotter OHI

## STATE OF WEST VIRGINIA DEPARTMENT OF ENVIRONMENTAL PROTECTION, OFFICE OF OIL AND GAS NOTICE OF APPLICATION

Notice Time Requirement: notice shall be provided no later than th	e filing date of permit application.
Date of Notice: 3 Date Permit Application Filed: 3 Notice of:	- Transcription.
PERMIT FOR ANY WELL WORK  CONSTRUCTION OF AN I	
Delivery method pursuant to West Virginia Code § 22-6A-10(b)	
PERSONAL RECEIPT CONTROL RECEI	OF DELIVERY THAT REQUIRES A OR SIGNATURE CONFIRMATION
Pursuant to W. Va. Code § 22-6A-10(b) no later than the filing date of the certificate of approval for the construction of an impoundment or pit as registered mail or by any method of delivery that requires a receipt or sign sediment control plan required by section seven of this article, and the we the surface of the tract on which the well is or is proposed to be located; (oil and gas leasehold being developed by the proposed well work, if the s described in the erosion and sediment control plan submitted pursuant to operator or lessee, in the event the tract of land on which the well propose more coal seams; (4) The owners of record of the surface tract or tracts of well work, if the surface tract is to be used for the placement, construction impoundment or pit as described in section nine of this article; (5) Any su have a water well, spring or water supply source located within one thous provide water for consumption by humans or domestic animals; and (6) T proposed well work activity is to take place. (c)(1) If more than three tena subsection (b) of this section hold interests in the lands, the applicant may records of the sheriff required to be maintained pursuant to section eight, a provision of this article to the contrary, notice to a lien holder is not notice Code R. § 35-8-5.7.a requires, in part, that the operator shall also provide water purveyor or surface owner subject to notice and water testing as pro-	required by this article shall deliver, by personal service or by nature confirmation, copies of the application, the erosion and sell plat to each of the following persons: (1) The owners of record of (2) The owners of record of the surface tract or tracts overlying the surface tract is to be used for roads or other land disturbance as subsection (c), section seven of this article; (3) The coal owner, ed to be drilled is located [sic] is known to be underlain by one or verlying the oil and gas leasehold being developed by the proposed in, enlargement, alteration, repair, removal or abandonment of any arface owner or water purveyor who is known to the applicant to and five hundred feet of the center of the well pad which is used to the operator of any natural gas storage field within which the ints in common or other co-owners of interests described in the article one, chapter eleven-a of this code. (2) Notwithstanding any et to a landowner, unless the lien holder is the landowner. W. Va.
☐ Application Notice ☐ WSSP Notice ☐ E&S Plan Notice ☐ W	Vell Plat Notice is hereby provided to:
☑ SURFACE OWNER(s)	OAL OWNER OR LESSEE
Name: Can J. & Grace A. Rotter Nam	e: Tunnel Ridge- Allinace Resources GP LLC
Address: 2 Meirose Drive Addr	ress: 184 Schoolhouse Lane
Chillicothe, OH 45601 Valley	y Grove, WV 26060 Office Of Oil and Gas
Name:	OAL ODED ATOD
Address: Nam	e:MAR <b>0 8</b> 2023
Addr	ress:
SURFACE OWNER(s) (Road and/or Other Disturbance)	- IVII VIII IENTE Protecti
Name: ZSU Address: AND	REACE OWNER OF WATER WELL
AND	O/OR WATER PURVEYOR(s)
	e; None
Name: Address:	ress:
☐ SURFACE OWNER(s) (Impoundments or Pits)	PERATOR OF ANY NATURAL GAS STORAGE FIELD
Name:	
Address:	ess:
	ase attach additional forms if necessary

WW-6A (9-13)

API NO. 47- 069 OPERATOR WELL NO. Carl Rotter OHI 3H
Well Pad Name: Carl Rotter OHI

# STATE OF WEST VIRGINIA DEPARTMENT OF ENVIRONMENTAL PROTECTION, OFFICE OF OIL AND GAS NOTICE OF APPLICATION

Notice Time Requirement: notice shall be provided no later	than the filing date of permit application.
Date of Notice: Date Permit Application Filed: Notice of:	3/6
PERMIT FOR ANY CERTIFICATE OF	APPROVAL FOR THE
CONSTRUCTION	OF AN IMPOUNDMENT OR PIT
Delivery method pursuant to West Virginia Code § 22-6A	-10(b)
☐ PERSONAL ☐ REGISTERED ☐ ME	THOD OF DELIVERY THAT REQUIRES A
CERTIFICA	CEIPT OR SIGNATURE CONFIRMATION
	late of the application, the applicant for a permit for any well work or for a
sediment control plan required by section seven of this article, ar the surface of the tract on which the well is or is proposed to be I oil and gas leasehold being developed by the proposed well work described in the erosion and sediment control plan submitted pur operator or lessee, in the event the tract of land on which the wel more coal seams; (4) The owners of record of the surface tract or well work, if the surface tract is to be used for the placement, cor impoundment or pit as described in section nine of this article; (5 have a water well, spring or water supply source located within o provide water for consumption by humans or domestic animals; a proposed well work activity is to take place. (c)(1) If more than the subsection (b) of this section hold interests in the lands, the appliance of the sheriff required to be maintained pursuant to section provision of this article to the contrary, notice to a lien holder is not the surface.	r pit as required by this article shall deliver, by personal service or by pt or signature confirmation, copies of the application, the erosion and ad the well plat to each of the following persons: (1) The owners of record of ocated; (2) The owners of record of the surface tract or tracts overlying the c, if the surface tract is to be used for roads or other land disturbance as suant to subsection (c), section seven of this article; (3) The coal owner, I proposed to be drilled is located [sic] is known to be underlain by one or tracts overlying the oil and gas leasehold being developed by the proposed astruction, enlargement, alteration, repair, removal or abandonment of any (2) Any surface owner or water purveyor who is known to the applicant to ne thousand five hundred feet of the center of the well pad which is used to and (6) The operator of any natural gas storage field within which the aree tenants in common or other co-owners of interests described in cant may serve the documents required upon the person described in the n eight, article one, chapter eleven-a of this code. (2) Notwithstanding any not notice to a landowner, unless the lien holder is the landowner. W. Va. In provide the Well Site Safety Plan ("WSSP") to the surface owner and any neg as provided in section 15 of this rule.
☐ Application Notice ☐ WSSP Notice ☐ E&S Plan Notice	ce ☐ Well Plat Notice is hereby provided to:
☐ SURFACE OWNER(s)	☑ COAL OWNER OR LESSEE
Name:	Name: The Kathleen S. Craft Foundation & The Joseph W. Craft III Foundation
Address:	Address: 2502 E. 45th St.
	Tulsa, OK 74105-5147
Name:Address:	☐ COAL OPERATOR
Address:	Name:
SURFACE OWNER(s) (Road and/or Other Disturbance)	Address:
Name:	
Name:Address:	☐ SURFACE OWNER OF WATER WELL
	AND/OR WATER PURVEYOR(s)
Name:	Name:
Address:	
	Office Of OF OF ONY NATURAL GAS STORAGE GLELD
☐ SURFACE OWNER(s) (Impoundments or Pits)	Name:MAR 0 8 2023
Name:	Address:
Address:	WV na
	*Please attach additional forms if necessary relation
	Protection

API NO. 47-009

OPERATOR WELL NO. Carl Rotter OHI 3H Well Pad Name: Carl Rotter OHI

Notice is hereby given:

Pursuant to West Virginia Code § 22-6A-10(b), notice is hereby given that the undersigned well operator has applied for a permit for well work or for a certificate of approval for the construction of an impoundment or pit.

### This Notice Shall Include:

Pursuant to W. Va. Code § 22-6A-10(b), this notice shall include: (1) copies of the application; (2) the erosion and sediment control plan required by section seven of this article; and (3) the well plat.

Pursuant to W. Va. Code § 22-6A-10(f), this notice shall include: (1) a statement of the time limits for filing written comments; (2) who may file written comments; (3) the name and address of the secretary for the purpose of filing the comments and obtaining additional information; and (4) a statement that the persons may request, at the time of submitting written comments, notice of the permit decision and a list of persons qualified to test water.

Pursuant to W. Va. Code R. § 35-8-5.7.a, the operator shall provide the Well Site Safety Plan to the surface owner and any water purveyor or surface owner subject to notice and water testing as provided in section 15 of this rule.

Pursuant to W. Va. Code R. § 35-8-15.2.c, this notice shall: (1) contain a statement of the surface owner's and water purveyor's right to request sampling and analysis; (2) advise the surface owner and water purveyor of the rebuttable presumption for contamination or deprivation of a fresh water source or supply; advise the surface owner and water purveyor that refusal to allow the operator to conduct a pre-drilling water well test constitutes a method to rebut the presumption of liability; (3) advise the surface owner and water purveyor of his or her independent right to sample and analyze any water supply at his or her own expense; advise the surface owner and water purveyor whether or not the operator will utilize an independent laboratory to analyze any sample; and (4) advise the surface owner and or water purveyor that he or she can obtain from the Chief a list of water testing laboratories in the subject area capable of and qualified to test water supplies in accordance with standard acceptable methods.

Additional information related to horizontal drilling may be obtained from the Secretary, at the WV Department of Environmental Protection headquarters, located at 601 57<sup>th</sup> Street, SE, Charleston, WV 25304 (304-926-0450) or by visiting <a href="www.dep.wv.gov/oil-and-gas/pages/default.aspx">www.dep.wv.gov/oil-and-gas/pages/default.aspx</a>.

### **Well Location Restrictions**

Pursuant to W. Va. Code § 22-6A-12, Wells may not be drilled within two hundred fifty feet measured horizontally from any existing water well or developed spring used for human or domestic animal consumption. The center of well pads may not be located within six hundred twenty-five feet of an occupied dwelling structure, or a building two thousand five hundred square feet or larger used to house or shelter dairy cattle or poultry husbandry. This limitation is applicable to those wells, developed springs, dwellings or agricultural buildings that existed on the date a notice to the surface owner of planned entry for surveying or staking as provided in section ten of this article or a notice of intent to drill a horizontal well as provided in subsection (b), section sixteen of this article of this article of the provided, whichever occurs first, and to any dwelling under construction prior to that date. This limitation may be waived by written and some of the construction prior to that date. the surface owner transmitted to the department and recorded in the real property records maintained by the clerk of the county commission for the county in which such property is located. Furthermore, the well operator may be granted a variance by the secretary from these distance restrictions upon submission of a plan which identifies the sufficient measures, facilities or practices to be employed during well site construction, drilling and operations. The variance, if granted, shall include the include the particle of the construction of the variance, if granted, shall include the include the particle of the construction of the variance. department requires to ensure the safety and protection of affected persons and property. The terms and conditions may insurance, bonding and indemnification, as well as technical requirements. (b) No well pad may be prepared or well drilled within one hundred feet measured horizontally from any perennial stream, natural or artificial lake, pond or reservoir, or a wetland, or within three hundred feet of a naturally reproducing trout stream. No well pad may be located within one thousand feet of a surface or ground water intake of a public water supply. The distance from the public water supply as identified by the department shall be measured as follows: (1) For a surface water intake on a lake or reservoir, the distance shall be measured from the boundary of the lake or reservoir. (2) For a surface water intake on a flowing stream, the distance shall be measured from a semicircular radius extending upstream of the surface water intake. (3) For a groundwater source, the distance shall be measured from the wellhead or spring. The department may, in its discretion, waive these distance restrictions upon submission of a plan identifying sufficient measures, facilities or practices to be employed during well site construction, drilling and operations to protect the waters of the state. A waiver, if granted, shall impose any permit conditions as the secretary considers necessary. (c) Notwithstanding the foregoing provisions of this section, nothing contained in this section prevents an operator from conducting the activities permitted or authorized by a Clean Water Act Section 404 permit or other approval from the United States Army Corps of Engineers within any waters of the state or within the restricted areas referenced in this section. (d) The well location restrictions set forth in this section shall not apply to any well on a multiple well pad if at least one of the wells was permitted prior to the effective date of this article. (e) The secretary shall, by December 31, 2012, report to the Legislature on the noise, light, dust and volatile organic compounds generated by the drilling of horizontal wells as they relate to the well location restrictions regarding occupied dwelling structures pursuant to this section. Upon a finding, if any, by the secretary that the well location restrictions regarding occupied dwelling structures are inadequate or otherwise require alteration to address the items

API NO. 47-009

OPERATOR WELL NO. Carl Rotter OHI 3H

Well Pad Name: Carl Rotter OHI

examined in the study required by this subsection, the secretary shall have the authority to propose for promulgation legislative rules establishing guidelines and procedures regarding reasonable levels of noise, light, dust and volatile organic compounds relating to drilling horizontal wells, including reasonable means of mitigating such factors, if necessary.

### Water Well Testing:

Pursuant to West Virginia Code § 22-6A-10(d), notification shall be made, with respect to surface landowners identified in subsection (b) or water purveyors identified in subdivision (5), subsection (b) of this section, of the opportunity for testing their water well. The operator shall provide an analysis to such surface landowner or water purveyor at their request.

### Water Testing Laboratories:

Pursuant to West Virginia Code § 22-6A-10(i), persons entitled to notice pursuant to subsection (b) of this section may contact the department to ascertain the names and locations of water testing laboratories in the subject area capable and qualified to test water supplies in accordance with standard accepted methods. In compiling that list of names the department shall consult with the state Bureau for Public Health and local health departments. A surface owner and water purveyor has an independent right to sample and analyze any water supply at his or her own expense. The laboratory utilized by the operator shall be approved by the agency as being certified and capable of performing sample analyses in accordance with this section.

### Rebuttable Presumption for Contamination or Deprivation of a Fresh Water Source or Supply:

W. Va. Code § 22-6A-18 requires that (b) unless rebutted by one of the defenses established in subsection (c) of this section, in any action for contamination or deprivation of a fresh water source or supply within one thousand five hundred feet of the center of the well pad for horizontal well, there is a rebuttable presumption that the drilling and the oil or gas well or either was the proximate cause of the contamination or deprivation of the fresh water source or supply. (c) In order to rebut the presumption of liability established in subsection (b) of this section, the operator must prove by a preponderance of the evidence one of the following defenses: (1) The pollution existed prior to the drilling or alteration activity as determined by a predrilling or prealteration water well test. (2) The landowner or water purveyor refused to allow the operator access to the property to conduct a predrilling or prealteration water well test. (3) The water supply is not within one thousand five hundred feet of the well. (4) The pollution occurred more than six months after completion of drilling or alteration activities. (5) The pollution occurred as the result of some cause other than the drilling or alteration activity. (d) Any operator electing to preserve its defenses under subdivision (1), subsection (c) of this section shall retain the services of an independent certified laboratory to conduct the predrilling or prealteration water well test. A copy of the results of the test shall be submitted to the department and the surface owner or water purveyor in a manner prescribed by the secretary. (e) Any operator shall replace the water supply of an owner of interest in real property who obtains all or part of that owner's supply of water for domestic, agricultural, industrial or other legitimate use from an underground or surface source with a comparable water supply where the secretary determines that the water supply has been affected by contamination, diminution or interruption proximately caused by the oil or gas operation, unless waived in writing by that owner. (f) The secretary may order the operator conducting the oil or gas operation to: (1) Provide an emergency drinking water supply within twenty-four hours; (2) Provide temporary water supply within seventy-two hours; (3) Within thirty days begin activities to establish a permanent water supply or submit a proposal to the secretary outlining the measures and timetables to be used in establishing a permanent supply. The total time in providing a permanent water supply may not exceed two years. If the operator demonstrates that providing a permanent replacement water supply cannot be completed within two years, the secretary may extend the time frame on case-by-case basis; and (4) Pay all reasonable costs incurred by the real property owner in securing a water supply. (g) A person as described in subsection (b) of this section aggrieved under the provisions of subsections (b), (e) or (f) of this section may seek relief in court... (i) Notwithstanding the denial of the operator of responsibility for the damage to the real property owner's water supply or the status of any appeal on determination of liability for the damage to the real property owner's water supply, the operator may not discontinue providing the required water service until authorized to do so by the secretary or a court of competent jurisdiction.

### Written Comment:

Pursuant to West Virginia Code § 22-6A-11(a), all persons described in subsection (b), section ten of this article may file written comments with the secretary as to the location or construction of the applicant's proposed well work within thirty days after the application is filed with the secretary. All persons described in West Virginia Code § 22-6A-10(b) may file written comments as to the location or construction of the applicant's proposed well work to the Secretary at: Office Of Oil and Gas

Chief, Office of Oil and Gas Department of Environmental Protection 601 57<sup>th</sup> St. SE Charleston, WV 25304 (304) 926-0450

Wy Department of Environmental Protection

13

Such persons may request, at the time of submitting written comments, notice of the permit decision and a list of persons qualified to test water. NOTE: YOU ARE NOT REQUIRED TO FILE ANY COMMENT.

API NO. 47-009

OPERATOR WELL NO. Carl Rotter OHI 3H

Well Pad Name: Carl Rotter OHI

### Time Limits and Methods for Filing Comments.

The law requires these materials to be served on or before the date the operator files its Application. You have **THIRTY (30) DAYS** after the filing date to file your comments. Comments must be filed in person or received in the mail by the Chief's office by the time stated above. You may call the Chief's office to be sure of the date. Check with your postmaster to ensure adequate delivery time or to arrange special expedited handling. If you have been contacted by the well operator and you have signed a "voluntary statement of no objection" to the planned work described in these materials, then the permit may be issued at any time.

Pursuant to West Virginia Code § 22-6A-11(c)(2), Any objections of the affected coal operators and coal seam owners and lessees shall be addressed through the processes and procedures that exist under sections fifteen, seventeen and forty, article six of this chapter, as applicable and as incorporated into this article by section five of this article. The written comments filed by the parties entitled to notice under subdivisions (1), (2), (4), (5) and (6), subsection (b), section ten of this article shall be considered by the sections fifteen, seventeen or forty, article six of this chapter, as applicable and as incorporated into this article by section five of this article.

### **Comment Requirements**

Your comments must be in writing and include your name, address and telephone number, the well operator's name and well number and the approximate location of the proposed well site including district and county from the application. You may add other documents, such as sketches, maps or photographs to support your comments.

Disclaimer: All comments received will be placed on our web site <a href="http://www.dep.wv.gov/oil-and-gas/Horizontal-Permits/Pages/default.aspx">http://www.dep.wv.gov/oil-and-gas/Horizontal-Permits/Pages/default.aspx</a> and the applicant will automatically be forwarded an email notice that such comments have been submitted. The applicant will be expected to provide a response to comments submitted by any surface owner, water purveyor or natural gas storage operator noticed within the application.

### Permit Denial or Condition

The Chief has the power to deny or condition a well work permit. Pursuant to West Virginia Code § 22-6A-8(d), the permit may not be issued or be conditioned, including conditions with respect to the location of the well and access roads prior to issuance if the director determines that:

- (1) The proposed well work will constitute a hazard to the safety of persons;
- (2) The plan for soil erosion and sediment control is not adequate or effective;
- (3) Damage would occur to publicly owned lands or resources; or
- (4) The proposed well work fails to protect fresh water sources or supplies.

A permit may also be denied under West Virginia Code § 22-6A-7(k), the secretary shall deny the issuance of a permit if the secretary determines that the applicant has committed a substantial violation of a previously issued permit for a horizontal well, including the applicable erosion and sediment control plan associated with the previously issued permit, or a substantial violation of one or more of the rules promulgated under this article, and in each instance has failed to abate or seek review of the violation within the time prescribed by the secretary pursuant to the provisions of subdivisions (1) and (2), subsection (a), section five of this article and the rules promulgated hereunder, which time may not be unreasonable.

Pursuant to West Virginia Code § 22-6A-10(g), any person entitled to submit written comments to the secretary pursuant to subsection (a), section eleven of this article, shall also be entitled to receive from the secretary a copy of the permit as issued or a copy of the order modifying or denying the permit if the person requests receipt of them as a part of the written comments submitted concerning the permit application. Such persons may request, at the time of submitting written comments, notice of the permit decision and a list of persons qualified to test water.



WW-6A (8-13)

API NO. 47-009 OPERATOR WELL NO. Carl Rotter OHI 3H Well Pad Name: Carl Rotter OHI

Notice is hereby given by:

Well Operator: SWN Production Co., LLC

Telephone: 304-884-1610

Email: Brittany\_Woody@swn.com

Address: 1300 Fort Pierpont Dr., Suite 201 Morgantown, WV 26508

Facsimile: 304-884-1690

### Oil and Gas Privacy Notice:

The Office of Oil and Gas processes your personal information, such as name, address and telephone number, as part of our regulatory duties. Your personal information may be disclosed to other State agencies or third parties in the normal course of business or as needed to comply with statutory or regulatory requirements, including Freedom of Information Act requests. Our office will appropriately secure your personal information. If you have any questions about our use or your personal information, please contact DEP's Chief Privacy Officer at depprivacyofficer@wv.gov.

JUSTIN BOOTH Notary Public Official Seal State of West Virginia My Comm. Expires Mar 10, 2027 Scenery Drive Morgantown WV 26505

Subscribed and sworn before me this 2300 day of FEBRUARY 2023.

Notary Public

My Commission Expires

Office Of Oil and Gas

MAR 08 2023

WV Department of Environmental Protection

# STATE OF WEST VIRGINIA DEPARTMENT OF ENVIRONMENTAL PROTECTION, OFFICE OF OIL AND GAS NOTICE OF ENTRY FOR PLAT SURVEY

Notice Time	Requirement:	Notice shall be prov	vided at least SEVEN (7) days but no more than FORTY-FIVE (45) days prior to
entry  Date of Notice			nned Entry: 2/1/2023
Delivery met	hod pursuant	to West Virginia Co	ode § 22-6A-10a
☐ PERSON	JAL 🔳	REGISTERED	METHOD OF DELIVERY THAT PROVIDES
SERVIC		MAIL	☐ METHOD OF DELIVERY THAT REQUIRES A RECEIPT OR SIGNATURE CONFIRMATION
Durguent to W	XI		
but no more the beneath such to owner of mine and Sediment of Secretary, while enable the surf	an forty-five d ract that has fil rals underlying Control Manua ch statement shace owner to o	ays prior to such entred a declaration purs such tract in the could and the statutes and tall include contact in the tall include contact in the statut copies from the	Prior to filing a permit application, the operator shall provide notice of planned entry a required pursuant to this article. Such notice shall be provided at least seven days ry to: (1) The surface owner of such tract; (2) to any owner or lessee of coal seams suant to section thirty-six, article six, chapter twenty-two of this code; and (3) any unty tax records. The notice shall include a statement that copies of the state Erosion d rules related to oil and gas exploration and production may be obtained from the information, including the address for a web page on the Secretary's web site, to be secretary.
Notice is here		:	
SURFACI			COAL OWNER OR LESSEE
Name: Carl J. and G			Name: The Kathleen S. Craft Foundation & The Joseph W. Craft III Foundation
Address: 2 Melro Chillicothe, OH 4560			Address: 2502 E 45th ST
	10		Tulsa, OK 74105-5147
Name:			I MANUAL OXIDER ()
			NT 0-11 10
Name:			A LI
Address:			Chillicothe, OH 45601
-			*please attach additional forms if necessary
BAT IN A W			
Notice is here	by given:	1-0.00	
a plat survey on	st virginia Coc	le § 22-6A-10(a), no	tice is hereby given that the undersigned well operator is planning entry to conduct
G	we tract of far	id as follows:	
a -	Ohio		Approx. Latitude & Longitude: 40.101501, -80.542417
D:	iberty		Watanghad
Quadrangle: V	alley Grove		C III C C C C C C C C C C C C C C C C C
		Contract of the Contract of th	Generally used farm name: Carl Rotter OHI
Charleston, WV	25304 (304-9 ne Secretary by	26-0450). Copies of	Manual and the statutes and rules related to oil and gas exploration and production partment of Environmental Protection headquarters, located at 601 57 th Street, SE, f such documents or additional information related to horizontal ariling may be vv.gov/oil-and-gas/pages/default.aspx.  Address:  Address:  Address:  Address:  Address:  Address:  Manual and the statutes and rules related to oil and gas exploration and production partment of such as a su
Well Operator:	SWN PRODUCTIO	N COMPANY, LLC	Collon
Telephone:	304-884-1610	,	5-5-14 5-14 5-14 5-14 5-14
Email:	brittany_woody@sv	vn.com	Morgantown, WV 26508 Facsimile: 304-884-1690
	W. T.		

Oil and Gas Privacy Notice:

The Office of Oil and Gas processes your personal information, such as name, address and telephone number, as part of our regulatory duties. Your personal information may be disclosed to other State agencies or third parties in the normal course of business or as needed to comply with statutory or regulatory requirements, including Freedom of Information Act requests. Our office will appropriately secure your personal information. If you have any questions about our use or your personal information, please contact DEP's Chief Privacy Officer at depprivacyofficer@wv.gov.

# STATE OF WEST VIRGINIA DEPARTMENT OF ENVIRONMENTAL PROTECTION, OFFICE OF OIL AND GAS NOTICE OF ENTRY FOR PLAT SURVEY

Notice Time 1	Requirement:	Notice shall be prov	ided at least s	SEVEN (7)	days but no more th	nan FORTY-FIVE (45) days prior to
Cittiy	e: _1/25/2023					(15) days prior to
Dute of Hoties	C	Date of Plan	ned Entry:	2/1/2023		
Delivery meth	nod pursuant i	to West Virginia Co	de § 22-6A-	10a		
☐ PERSON	IAL 🔳	REGISTERED	Пмет	HOD OF DE	ELIVERY THAT R	PEOLIDES A
SERVICE		MAIL			SNATURE CONFI	
Durauant to W	ant William C	1 000 (1 10() =				
but no more th beneath such tr owner of miner and Sediment ( Secretary, which	an forty-five daract that has file rals underlying Control Manua ch statement sh	ays prior to such entred a declaration purs such tract in the could and the statutes and	required pur- y to: (1) The uant to section that tax record rules related	suant to this surface own on thirty-six, ds. The notil to oil and surface or the surface of the	article. Such notice er of such tract; (2) article six, chapter ce shall include a s	or shall provide notice of planned entry shall be provided at least seven days to any owner or lessee of coal seams twenty-two of this code; and (3) any tatement that copies of the state Erosion production may be obtained from the page on the Secretary's web site, to
Notice is herel	by provided to	:				
☐ SURFACE	E OWNER(s)			■ COA	AL OWNER OR LE	ESSEE
Name:						ces GP LLC Attn: Evan Midler
Address:					184 Schoolhouse Lane	
				Valley Grove	, WV 26060	
Address:				Път	TDAL ONDED	
					ERAL OWNER(s)	
Name:				Name:		
Address:				Addiess.		
				*please attac	ch additional forms if ne	ecessary
a plat bull to y on	st Virginia Coc	le § 22-6A-10(a), no nd as follows:	tice is hereby	given that th	ne undersigned wel	l operator is planning entry to conduct
						40.101501, -80.542417
D:				Public Road	Access:	Trestlework Rogers Road
o –	iberty /alley Grove	7.00		Watershed:	1.0	Little Wheeling Creek
Quadrangiev	ancy Grove			senerally use	ed farm name:	Carl Rotter OH TECHTON
Copies of the sta may be obtained Charleston, WV obtained from the	ate Erosion and I from the Secr 7 25304 (304-9 ne Secretary by	d Sediment Control Metary, at the WV Depter (1988). Copies of visiting www.dep.w	Manual and the partment of E such documers. gov/oil-and	ne statutes an Environmenta ents or addit d-gas/pages/o	d rules related to on al Protection headquional information re default.aspx.	Carl Rolling HIPECE VED  OF ON VED  il and glastex ploration and production uarters, located at 601 57 Street, SE, elated to horizontal drilling may be production or production of the producti
Well Operator:	SWN PRODUCTIO	ON COMPANY, LLC		Address:		
Telephone:	304-884-1610	55./// / 111, EEO	-	ruuress.	1300 Fort Pierpont Dr.,	
Email:	brittany_woody@sv	vn.com		Facsimile:	Morgantown, WV 26508 304-884-1690	)

Oil and Gas Privacy Notice:

The Office of Oil and Gas processes your personal information, such as name, address and telephone number, as part of our regulatory duties. Your personal information may be disclosed to other State agencies or third parties in the normal course of business or as needed to comply with statutory or regulatory requirements, including Freedom of Information Act requests. Our office will appropriately secure your personal information. If you have any questions about our use or your personal information, please contact DEP's Chief Privacy Officer at <a href="mailto:depprivacyofficer@wv.gov">depprivacyofficer@wv.gov</a>.

# STATE OF WEST VIRGINIA DEPARTMENT OF ENVIRONMENTAL PROTECTION, OFFICE OF OIL AND GAS NOTICE OF INTENT TO DRILL

Pursuant to W. Va. Code § 22-6A-16(b), the Notice of Intent to Drill is only required if the notice requirements of W. Va. Code § 22-6A-10(a) have NOT been met or if the Notice of Intent to Drill requirement has NOT been waived in writing by the surface owner.

Notice Time Date of Notice	Requirement: Notice shall be provided at lease: 02/20/2023 Date Permit	st TEN (10) days prior to filing Application Filed:	a permit application.
Delivery met	thod pursuant to West Virginia Code § 22-6.	A-16(b)	
☐ HAND DELIVE	CERTIFIED MAIL RETURN RECEIPT REQUE	CITED	
Pursuant to W receipt reques drilling a hori of this subsection materials and if available	V. Va. Code § 22-6A-16(b), at least ten days protected or hand delivery, give the surface owner nutrontal well: <i>Provided</i> , That notice given pursition as of the date the notice was provided to the way be waived in writing by the surface owner. It is facsimile number and electronic mail address.	rior to filing a permit application to tice of its intent to enter upon suant to subsection (a), section the surface owner: <i>Provided, ho</i> The notice, if required, shall income of the operator and the operator	the surface owner's land for the purpose of en of this article satisfies the requirements wever, That the notice requirements of this
Notice is her Name: Carl & Gr	reby provided to the SURFACE OWNE		
Address: 35850		Name:	
Willoughby, OH 4		Address:	Micaria
Notice is her Pursuant to W the surface ow State: County: District: Quadrangle: Watershed:	reby given:  fest Virginia Code § 22-6A-16(b), notice is her rer's land for the purpose of drilling a horizon west Virginia  Ohio  Liberty  Valley Grove, WV  Upper Ohio South	reby given that the undersigned tal well on the tract of land as for UTM NAD 83  Public Road Access: Generally used farm name:	well operator has an intent to enter upon bllows:  539,000.38  4,439,125.47  Rogers Road  Carl Rotter OHI
Pursuant to W facsimile num related to horiz	Shall Include: Vest Virginia Code § 22-6A-16(b), this notice ber and electronic mail address of the operate zontal drilling may be obtained from the Secro 57th Street, SE, Charleston, WV 25304 (304-9).	tor and the operator's authorize	ed representative. Additional information
Notice is here	eby given by:		
Well Operator:	SWN Production Company, LLC	Authorized Representative:	Reid Croft
Address:	1300 Fort Pierpont Dr., Suite 201	Address:	
-	Morgantown, WV 26508	and action and characteristic	1300 Fort Pierpont Dr., Suite 201
Telephone:	304-884-1642	Telephone:	Morgantown, WV 26508
Email:	reid_croft@swn.com	Email:	304-884-1642
Facsimile:		Facsimile:	reid_croft@swn.com

Oil and Gas Privacy Notice:

The Office of Oil and Gas processes your personal information, such as name, address and telephone number, as part of our regulatory duties. Your personal information may be disclosed to other State agencies or third parties in the normal course of business or as needed to comply with statutory or regulatory requirements, including Freedom of Information Act requests. Our office will appropriately secure your personal information. If you have any questions about our use or your personal information, please contact DEP's Chief Privacy Officer at depprivacyofficer@wv.gov.

# STATE OF WEST VIRGINIA DEPARTMENT OF ENVIRONMENTAL PROTECTION, OFFICE OF OIL AND GAS NOTICE OF PLANNED OPERATION

Date	of Notice	ce: 02/20/2023 Date Pe	vided no rmit A <sub>I</sub>	o later than the filing plication Filed:	g date of permi	t application.
Deliv	ery met	thod pursuant to West Virginia (	Code § 2	22-6A-16(c)		
	CERTI	FIED MAIL	П	HAND		
		RN RECEIPT REQUESTED	لسا			
				DELIVERY		
the p required drilling dama	lanned of red to be ng of a liges to the he notice	peration. The notice required by provided by subsection (b), section orizontal well; and (3) A propose e surface affected by oil and gas of	this su on ten of ed surfa- peration	bsection shall inclusive this article to a sur- ce use and comper	and will be used for ade: (1) A copy face owner whose station agreemer	ication, an operator shall, by certified main or the drilling of a horizontal well notice of of this code section; (2) The information se land will be used in conjunction with the nt containing an offer of compensation for pensable under article six-b of this chapter, sted in the records of the sheriff at the time
Notic	e is her	eby provided to the SURFACE O	WNED	2(a)		
(at the	e address	s listed in the records of the sheriff	at the ti	me of notice)		
Name	: Carl & Gr	ace Rotter 🗸				
		Jennie Ln.		Addres	ss:	
vvillou	ghby, OH 44	094		-		
State: Count Distri	y: ct:	est Virginia Code § 22-6A-16(c), r the surface owner's land for the pur West Virginia Ohio Liberty	notice is rpose of	hereby given that to drilling a horizonta  UTM NAD 8  Public Road	al well on the tra  Easting: Northing:	well operator has developed a planned act of land as follows:  539,000.38  4,439,125.47  Rogers Road
	angle:	Valley Grove, WV			ed farm name:	Carl Rotter OHI
Water	shed:	Upper Ohio South			-	
Pursua to be horizo surfac nform neadqu gas/pa	ant to W provided ontal well e affected action requarters, ges/defa	It; and (3) A proposed surface use and by oil and gas operations to the lated to horizontal drilling may be located at 601 57th Street, SE, ult.aspx.	and come extent	irface owner whose ipensation agreeme the damages are co	e land will be unt containing an ompensable under	code section; (2) The information required used in conjunction with the drilling of a offer of compensation for damages to the er article six-b of this chapter. Additional Department of Environmental Protection or by visiting <a href="https://www.dep.wv.gov/oil-and-trustile-201">www.dep.wv.gov/oil-and-trustile-201</a>
<b>Feleph</b>	none:	304-884-1642			Morgantown, WV 265	
Email:		reid_croft@swn.com		Facsimile:	Worganiown, VVV 200	300
The Of	ffice of (	rivacy Notice: Dil and Gas processes your personal ersonal information may be disclored with statutory or regulatory ecure your personal information. In the rivacy Officer at depprivacyofficer	ul informosed to require f you ha	nation, such as nam	e, address and te s or third partie Freedom of Inf bout our use or	elephone number, as part of our regulatory in the normal course of business or as formation Act requests. Our office will your personal information, please contact
						Chon



### WEST VIRGINIA DEPARTMENT OF TRANSPORTATION

Division of Highways

Gregory L. Bailey, P.E. Interim State Highway Engineer 1900 Kanawha Boulevard East • Building Five • Room 110 Charleston, West Virginia 25305-0430 • (304) 558-3505

Jimmy Wriston, P. E. Secretary of Transportation Commissioner of Highways

February 22, 2023

James A. Martin, Chief Office of Oil and Gas Department of Environmental Protection 601 57th Street, SE Charleston, WV 25304

Subject: DOH Permit for the Carl Rotter Pad, Ohio County Carl Rotter OHI 3H Well Site

Dear Mr. Martin,

This well site will be accessed from a DOH permit #06-2013-0307 which has been issued to Southwestern Energy for access to the State Road for a well site located off Ohio County Route 40/6 SLS MP 1.20.

This operator is in compliance with §22-6A-20 of the WV Code. Operator has signed a STATEWIDE OIL AND GAS ROAD MAINTENANCE BONDING AGREEMENT and provided the required Bond. This operator is currently in compliance with the DOH OIL AND GAS POLICY dated October 1, 2018. This letter is valid for permitting purposes for one year from the date of this letter.

Very Truly Yours,

Gary K. Clayton, P.E.

Dary K. Clayton

Regional Operations Engineer ECEIVED

Central Office O&G Coordinator and Gas MAR 08 323

Environmental Protection

Southwestern Energy

**Brittany Woody** 

Cc:

CH, OM, D-6 File

E.E.O./AFFIRMATIVE ACTION EMPLOYER


### Attachment VI Frac Additives

Product Name Al-303 (U.S. Well Services)			
AI-303 (U.S. Well Services)	Product Use	Chemical Name	CAS Number
	Mixture	Ethylene glycol	107-21 1
		Cinnamaldehyde	104-55 2
		Butyl cellosolve	111-76 2
		Formic acid	64-18 6
		Polyether	Proprietary
AD ONE (I) a viv III a		Acetophenone, thiourea, formaldehyde polymer	68527-49 1
AP ONE (U.S. Well Services)	Breaker	Ammonium persulfate	7727-54-0
Bactron K-139 (Champion Technologies)	Biocide	Glutaraldehyde	111-30-8
			111 00 0
		Quaternary Ammonium Compounds, Benzyl-C12-16-Alkyldimethyl, Chloride	s 68424-85-1
		Ethanol	64-17-5
Bactron K-219 (Champion Technologies)	Biocide	Methanol	67-56-1
			0, 30-1
		Quaternary Ammonium Compounds, Benzyl-C12-16-Alkyldimethyl, Chlorides	68424-85-1
CarboNRT	Tracer	Ceramic Proppant	66402-68-4
EC6486A (Nalco Champion)	Scale Inhibitor	Amine Triphosphate	Proprietary
		Ethylene Glycol	107-21-1
EC6734A (Champion Technologies)	Biocide	Hydrogen Peroxide	7722-84-1
		Acetic Acid	64-19-7
		Peroxyacetic Acid	79-21-0
cono-Cl200 (SWN Well Services)	Corrosion Inhibitor	Methanol	67-56-1
		Oxyalkylated fatty acid	68951-67-7
		Fatty acids	61790-12-3
		Modified thiourea polymer	68527-49-1
		Water	7732-18-5
		Hydrochloric acid	7/52-18-5
		Potassium acetate	127-08-2
		Formaldehyde	50-00-0
copol-FEAC (SWN Well Services)	Iron Control	Acetic Acid	64-19-7
		Citric Acid	77-92-9
		Water	7732-18-5
DP-S1176-15 (Halliburton)	Friction Reducer	Polyacylate	
Autoria III de la Companya del Companya del Companya de la Company		Hydrotreated light petroleum distillate	Proprietary 64742-47-8
LOJET DR900 LPP (SWN Well Services)	Friction Reducer	Distillates (petroleum) hydrotreated light	64674-47-8
		Ethylene Glycol	
		Alcohols, C12-16, Exoxylated propoxylated	107-21-1
		Fatty Alcohols ethoxylated	68213-24-1 Depositors
		Water	Proprietary 7732-18-5
OJET DRP 1130X (SWN Well Services)	Friction Reducer	Proprietary	
R-76 (Halliburton)	Friction Reducer	Hydrotreated light petroleum distillate	Proprietary
		Inorganic Salt	64742-47-8
YPTRON T-390 (Champion Technologies)	Scale Inhibitor	Methanol	Proprietary
		Nonylphenol Ethoxylate	67-56-1
Al-150E (Halliburton)	Corrosion Inhibitor	No hazardous substance	Proprietary
CL (SWN Well Services)	Hydrocholic Acid	Hydrochloric Acid	N/A
(	riyarocilolic Acid	Water	7647-01-0
P-65 MC (Halliburton)	Coole lubibite		7732-18-5
os we (nambarton)	Scale Inhibitor	Organic phosphonate	Proprietary
PTI-FLEX (U.S. Well Services)	V(	Ammonium Chloride	12125-02-9
exslick 930	Viscosifying Agent	Distillates, petroleum, hydrotreated light	64742-47-8
EXSILER 550	Friction Reducer	Copolymer of 2-propenamide	Proprietary
		Hydrotreated Distillate	64742-47-8
		Sodium Chloride	7647-14-5
		Alcohols, C12-16, Exoxylated	68551-12-2
		Oleic Acid Diethanolamide	
			93-83-4
ayclirk 953	Fulation Dodge	Ammonium Chloride	12125-02-9
exslick 953	Friction Reducer	Ammonium Chloride Petroleum Distillate	
exslick 953	Friction Reducer	Ammonium Chloride Petroleum Distillate Sodium Chloride	12125-02-9 64742-47-8 7647-14-5
exslick 953	Friction Reducer	Ammonium Chloride Petroleum Distillate Sodium Chloride Ammonium Chloride	12125-02-9 64742-47-8 7647-14-5 12125-02-9
		Ammonium Chloride Petroleum Distillate Sodium Chloride Ammonium Chloride N,N-bis (2-hydroxyethyl) oleamide	12125-02-9 64742-47-8 7647-14-5 12125-02-9 93-83-4
exslick 953 exslick 957	Friction Reducer	Ammonium Chloride  Petroleum Distillate Sodium Chloride Ammonium Chloride N,N-bis (2-hydroxyethyl) oleamide  Petroleum Distillate	12125-02-9 64742-47-8 7647-14-5 12125-02-9 93-83-4 64742-47-8
		Ammonium Chloride  Petroleum Distillate Sodium Chloride Ammonium Chloride N,N-bis (2-hydroxyethyl) oleamide  Petroleum Distillate Ammonium Chloride	12125-02-9 64742-47-8 7647-14-5 12125-02-9 93-83-4
		Ammonium Chloride  Petroleum Distillate Sodium Chloride Ammonium Chloride N,N-bis (2-hydroxyethyl) oleamide  Petroleum Distillate Ammonium Chloride Oleic Acid Diethanolamide	12125-02-9 64742-47-8 7647-14-5 12125-02-9 93-83-4 64742-47-8 12125-02-9 93-83-4
		Ammonium Chloride Petroleum Distillate Sodium Chloride Ammonium Chloride N,N-bis (2-hydroxyethyl) oleamide Petroleum Distillate Ammonium Chloride Oleic Acid Diethanolamide Alcohols, C12-16, Exoxylated	12125-02-9 64742-47-8 7647-14-5 12125-02-9 93-83-4 64742-47-8 12125-02-9 93-83-4 68551-12-2
oxslick 957	Friction Reducer	Ammonium Chloride Petroleum Distillate Sodium Chloride Ammonium Chloride N,N-bis (2-hydroxyethyl) oleamide Petroleum Distillate Ammonium Chloride Oleic Acid Diethanolamide Alcohols, C12-16, Exoxylated Water	12125-02-9 64742-47-8 7647-14-5 12125-02-9 93-83-4 64742-47-8 12125-02-9 93-83-4 68551-12-2 7732-15-5
xslick 957		Ammonium Chloride  Petroleum Distillate Sodium Chloride Ammonium Chloride N,N-bis (2-hydroxyethyl) oleamide  Petroleum Distillate Ammonium Chloride Oleic Acid Diethanolamide Alcohols, C12-16, Exoxylated Water  Copolymer of 2-Propeenamide	12125-02-9 64742-47-8 7647-14-5 12125-02-9 93-83-4 64742-47-8 12125-02-9 93-83-4 68551-12-2
oxslick 957	Friction Reducer	Ammonium Chloride  Petroleum Distillate Sodium Chloride Ammonium Chloride N,N-bis (2-hydroxyethyl) oleamide  Petroleum Distillate Ammonium Chloride Oleic Acid Diethanolamide Alcohols, C12-16, Exoxylated Water Copolymer of 2-Propeenamide Distillates (petroleum), hydotreated light	12125-02-9 64742-47-8 7647-14-5 12125-02-9 93-83-4 64742-47-8 12125-02-9 93-83-4 68551-12-2 7732-15-5 **********************************
exslick 957	Friction Reducer  no data available	Ammonium Chloride Petroleum Distillate Sodium Chloride Ammonium Chloride N,N-bis (2-hydroxyethyl) oleamide Petroleum Distillate Ammonium Chloride Oleic Acid Diethanolamide Alcohols, C12-16, Exoxylated Water Copolymer of 2-Propeenamide Distillates (petroleum), hydotreated light Alcohol Ethoxylate	12125-02-9 64742-47-8 7647-14-5 12125-02-9 93-83-4 64742-47-8 12125-02-9 93-83-4 68551-12-2 7732-15-5 **********************************
exslick 957 exslick V996	Friction Reducer  no data available	Ammonium Chloride  Petroleum Distillate Sodium Chloride Ammonium Chloride N,N-bis (2-hydroxyethyl) oleamide  Petroleum Distillate Ammonium Chloride Oleic Acid Diethanolamide Alcohols, C12-16, Exoxylated Water  Copolymer of 2-Propeenamide Distillates (petroleum), hydotreated light Alcohol Ethoxylate Surfactant	12125-02-9 64742-47-8 7647-14-5 12125-02-9 93-83-4 64742-47-8 12125-02-9 93-83-4 68551-12-2 7732-15-5 **********************************
exslick 957 exslick V996	Friction Reducer  no data available  Anionic Friction Reducer	Ammonium Chloride  Petroleum Distillate Sodium Chloride Ammonium Chloride N,N-bis (2-hydroxyethyl) oleamide  Petroleum Distillate Ammonium Chloride Oleic Acid Diethanolamide Alcohols, C12-16, Exoxylated Water  Copolymer of 2-Propeenamide Distillates (petroleum), hydotreated light Alcohol Ethoxylate Surfactant Hydrotreated light distillate (petroleum)	12125-02-9 64742-47-8 7647-14-5 12125-02-9 93-83-4 64742-47-8 12125-02-9 93-83-4 68551-12-2 7732-15-5 **********************************
exslick 957 exslick V996 FRA-2000 (U.S. Well Services)	Friction Reducer  no data available  Anionic Friction Reducer	Ammonium Chloride  Petroleum Distillate Sodium Chloride Ammonium Chloride N,N-bis (2-hydroxyethyl) oleamide  Petroleum Distillate Ammonium Chloride Oleic Acid Diethanolamide Alcohols, C12-16, Exoxylated Water  Copolymer of 2-Propeenamide Distillates (petroleum), hydotreated light Alcohol Ethoxylate Surfactant Hydrotreated light distillate (petroleum) Propenoic acid, polymer with propenamide	12125-02-9 64742-47-8 7647-14-5 12125-02-9 93-83-4 64742-47-8 12125-02-9 93-83-4 68551-12-2 7732-15-5 **********************************
xslick 957  xslick V996  FRA-2000 (U.S. Well Services)  xaid 655 NM	Friction Reducer  no data available  Anionic Friction Reducer  Scale Inhibitor	Ammonium Chloride Petroleum Distillate Sodium Chloride Ammonium Chloride N,N-bis (2-hydroxyethyl) oleamide Petroleum Distillate Ammonium Chloride Oleic Acid Diethanolamide Alcohols, C12-16, Exoxylated Water Copolymer of 2-Propeenamide Distillates (petroleum), hydotreated light Alcohol Ethoxylate Surfactant Hydrotreated light distillate (petroleum) Propenoic acid, polymer with propenamide Diethylenetriamine penta (methylene phosphonic acid)	12125-02-9 64742-47-8 7647-14-5 12125-02-9 93-83-4 64742-47-8 12125-02-9 93-83-4 68551-12-2 7732-15-5 **********************************
exslick 957  exslick V996  FRA-2000 (U.S. Well Services)  exaid 655 NM	Friction Reducer  no data available  Anionic Friction Reducer  Scale Inhibitor no data available	Ammonium Chloride Petroleum Distillate Sodium Chloride Ammonium Chloride N,N-bis (2-hydroxyethyl) oleamide Petroleum Distillate Ammonium Chloride Oleic Acid Diethanolamide Alcohols, C12-16, Exoxylated Water Copolymer of 2-Propeenamide Distillates (petroleum), hydotreated light Alcohol Ethoxylate Surfactant Hydrotreated light distillate (petroleum) Propenoic acid, polymer with propenamide Diethylenetriamine penta (methylene phosphonic acid) Copolymer of 2-propenaminde	12125-02-9 64742-47-8 7647-14-5 12125-02-9 93-83-4 64742-47-8 12125-02-9 93-83-4 68551-12-2 7732-15-5
exslick 957  exslick V996  FRA-2000 (U.S. Well Services)  exaid 655 NM	Friction Reducer  no data available  Anionic Friction Reducer  Scale Inhibitor no data available	Ammonium Chloride  Petroleum Distillate Sodium Chloride Ammonium Chloride N,N-bis (2-hydroxyethyl) oleamide  Petroleum Distillate Ammonium Chloride Oleic Acid Diethanolamide Alcohols, C12-16, Exoxylated Water Copolymer of 2-Propeenamide Distillates (petroleum), hydotreated light Alcohol Ethoxylate Surfactant Hydrotreated light distillate (petroleum) Propenoic acid, polymer with propenamide Diethylenetriamine penta (methylene phosphonic acid) Copolymer of 2-propenaminde Distillates (petroleum), hydotreated light	12125-02-9 64742-47-8 7647-14-5 12125-02-9 93-83-4 64742-47-8 12125-02-9 93-83-4 64742-47-8 12125-02-9 93-83-4 64742-47-8 15827-30-69 15827-30-69 64742-47-8
exslick 957  exslick V996  FRA-2000 (U.S. Well Services)  exaid 655 NM	riction Reducer  no data available  Anionic Friction Reducer Scale Inhibitor no data available	Ammonium Chloride  Petroleum Distillate Sodium Chloride Ammonium Chloride N,N-bis (2-hydroxyethyl) oleamide  Petroleum Distillate Ammonium Chloride Oleic Acid Diethanolamide Alcohols, C12-16, Exoxylated Water  Copolymer of 2-Propeenamide Distillates (petroleum), hydotreated light Alcohol Ethoxylate Surfactant Hydrotreated light distillate (petroleum) Propenoic acid, polymer with propenamide Diethylenetriamine penta (methylene phosphonic acid) Copolymer of 2-propenaminde Distillates (petroleum), hydotreated light Ammonium chloride ((NH4)CI)	12125-02-9 64742-47-8 7647-14-5 12125-02-9 93-83-4 64742-47-8 12125-02-9 93-83-4 64742-47-8 64742-47-8 9003-06-9 15827-30-10-0 69418-26-4 64742-47-8 12125-02-9    PECEIVE Of Oil and Advisor of State of
exslick 957  exslick V996  FRA-2000 (U.S. Well Services)  exaid 655 NM  exslick 922	Friction Reducer  no data available  Anionic Friction Reducer  Scale Inhibitor no data available	Ammonium Chloride  Petroleum Distillate Sodium Chloride Ammonium Chloride N,N-bis (2-hydroxyethyl) oleamide  Petroleum Distillate Ammonium Chloride Oleic Acid Diethanolamide Alcohols, C12-16, Exoxylated Water Copolymer of 2-Propeenamide Distillates (petroleum), hydotreated light Alcohol Ethoxylate Surfactant Hydrotreated light distillate (petroleum) Propenoic acid, polymer with propenamide Diethylenetriamine penta (methylene phosphonic acid) Copolymer of 2-propenaminde Distillates (petroleum), hydotreated light Ammonium chloride ((NH4)CI) Oleic Acid Diethnolamide	12125-02-9 64742-47-8 7647-14-5 12125-02-9 93-83-4 66742-47-8 12125-02-9 93-83-4 68551-12-2 7732-15-5 **** 64742-47-8 9003-06-9 15827-3 69418-26-4 64742-47-8 12125-02-9  93-83-4
xslick 957  xslick V996  RA-2000 (U.S. Well Services)  xaid 655 NM xslick 922	Friction Reducer  no data available  Anionic Friction Reducer  Scale Inhibitor no data available  Mixture	Ammonium Chloride  Petroleum Distillate Sodium Chloride Ammonium Chloride N,N-bis (2-hydroxyethyl) oleamide  Petroleum Distillate Ammonium Chloride Oleic Acid Diethanolamide Alcohols, C12-16, Exoxylated Water Copolymer of 2-Propeenamide Distillates (petroleum), hydotreated light Alcohol Ethoxylate Surfactant Hydrotreated light distillate (petroleum) Propenoic acid, polymer with propenamide Diethylenetriamine penta (methylene phosphonic acid) Copolymer of 2-propenaminde Distillates (petroleum), hydotreated light Ammonium chloride ((NH4)CI) Oleic Acid Diethnolamide Phosphonium, tetrakis (hydroxymethyl), Sulfate	12125-02-9 64742-47-8 7647-14-5 12125-02-9 93-83-4 64742-47-8 12125-02-9 93-83-4 68551-12-2 7732-15-5 64742-47-8 9003-06 9 15827-3 69418-26-4 64742-47-8 12125-02-9 93-83-4
exslick 957  exslick V996  FRA-2000 (U.S. Well Services)  exaid 655 NM  exslick 922	Friction Reducer  no data available  Anionic Friction Reducer  Scale Inhibitor no data available  Mixture	Ammonium Chloride  Petroleum Distillate Sodium Chloride Ammonium Chloride N,N-bis (2-hydroxyethyl) oleamide  Petroleum Distillate Ammonium Chloride Oleic Acid Diethanolamide Alcohols, C12-16, Exoxylated Water Copolymer of 2-Propeenamide Distillates (petroleum), hydotreated light Alcohol Ethoxylate Surfactant Hydrotreated light distillate (petroleum) Propenoic acid, polymer with propenamide Diethylenetriamine penta (methylene phosphonic acid) Copolymer of 2-propenaminde Distillates (petroleum), hydotreated light Ammonium chloride ((NH4)CI) Oleic Acid Diethnolamide	12125-02-9 64742-47-8 7647-14-5 12125-02-9 93-83-4 64742-47-8 12125-02-9 93-83-4 68551-12-2 7732-15-5 64742-47-8 9003-06-9 15827-36-160-6 64742-47-8 12125-02-9 93-83-4 64742-47-8 12125-02-9 15827-36-160-6 64742-47-8 12125-02-9 15827-36-160-6 64742-47-8 12125-03-9 15827-36-160-6 64742-47-8 12125-03-9 15827-36-160-6 6848-48-18-18-18-18-18-18-18-18-18-18-18-18-18
exslick 957  exslick V996  FRA-2000 (U.S. Well Services)  exaid 655 NM  exslick 922  cide 4Frac	Friction Reducer  no data available  Anionic Friction Reducer  Scale Inhibitor no data available  Mixture	Ammonium Chloride  Petroleum Distillate Sodium Chloride Ammonium Chloride N,N-bis (2-hydroxyethyl) oleamide  Petroleum Distillate Ammonium Chloride Oleic Acid Diethanolamide Alcohols, C12-16, Exoxylated Water Copolymer of 2-Propeenamide Distillates (petroleum), hydotreated light Alcohol Ethoxylate Surfactant Hydrotreated light distillate (petroleum) Propenoic acid, polymer with propenamide Diethylenetriamine penta (methylene phosphonic acid) Copolymer of 2-propenaminde Distillates (petroleum), hydotreated light Ammonium chloride ((NH4)CI) Oleic Acid Diethnolamide Phosphonium, tetrakis (hydroxymethyl), Sulfate	12125-02-9 64742-47-8 7647-14-5 12125-02-9 93-83-4 64742-47-8 12125-02-9 93-83-4 68551-12-2 7732-15-5 64742-47-8 9003-06-9 15827-36-160-6 64742-47-8 12125-02-9 93-83-4 64742-47-8 12125-02-9 15827-36-160-6 64742-47-8 12125-02-9 15827-36-160-6 64742-47-8 12125-03-9 15827-36-160-6 64742-47-8 12125-03-9 15827-36-160-6 6848-48-18-18-18-18-18-18-18-18-18-18-18-18-18
xslick 957  xslick V996  FRA-2000 (U.S. Well Services)  xaid 655 NM  xslick 922  cide 4Frac	Friction Reducer  no data available  Anionic Friction Reducer  Scale Inhibitor no data available  Mixture	Ammonium Chloride  Petroleum Distillate Sodium Chloride Ammonium Chloride N,N-bis (2-hydroxyethyl) oleamide  Petroleum Distillate Ammonium Chloride Oleic Acid Diethanolamide Alcohols, C12-16, Exoxylated Water Copolymer of 2-Propeenamide Distillates (petroleum), hydotreated light Alcohol Ethoxylate Surfactant Hydrotreated light distillate (petroleum) Propenoic acid, polymer with propenamide Diethylenetriamine penta (methylene phosphonic acid) Copolymer of 2-propenaminde Distillates (petroleum), hydotreated light Ammonium chloride ((NHA)CI) Oleic Acid Diethnolamide Phosphonium, tetrakis (hydroxymethyl), Sulfate Quaternary ammonium Compounds, Benzyl-C12-16-Alkyldimethyl, Chlorides	12125-02-9 64742-47-8 7647-14-5 12125-02-9 93-83-4 64742-47-8 12125-02-9 93-83-4 668551-12-2 7732-15-5 64742-47-8 9003-06-9 15827-3 69418-26-4 64742-47-8 12125-02-9 12125-02-9 xslick 957  xslick V996  FRA-2000 (U.S. Well Services)  xaid 655 NM  xslick 922  cide 4Frac	Friction Reducer  no data available  Anionic Friction Reducer  Scale Inhibitor no data available  Mixture  Biocidal product	Ammonium Chloride Petroleum Distillate Sodium Chloride Ammonium Chloride N,N-bis (2-hydroxyethyl) oleamide Petroleum Distillate Ammonium Chloride Oleic Acid Diethanolamide Alcohols, C12-16, Exoxylated Water Copolymer of 2-Propeenamide Distillates (petroleum), hydotreated light Alcohol Ethoxylate Surfactant Hydrotreated light distillate (petroleum) Propenoic acid, polymer with propenamide Diethylenetriamine penta (methylene phosphonic acid) Copolymer of 2-propenaminde Diethylenetriamine penta (methylene phosphonic acid) Copolymer of 2-propenaminde Distillates (petroleum), hydotreated light Ammonium chloride ((NH4)CI) Oleic Acid Diethnolamide Phosphonium, tetrakis (hydroxymethyl), Sulfate Quaternary ammonium Compounds, Benzyl-C12-16-Alkyldimethyl, Chlorides Ethanol Tetrakis (hydroxymethyl) phosphonium sulphate	12125-02-9 64742-47-8 7647-14-5 12125-02-9 93-83-4 64742-47-8 12125-02-9 93-83-4 68551-12-2 7732-15-5 64742-47-8 9003-06-9 15827-36-160-6 64742-47-8 12125-02-9 93-83-4 64742-47-8 12125-02-9 15827-36-160-6 64742-47-8 12125-02-9 15827-36-160-6 64742-47-8 12125-03-9 15827-36-160-6 64742-47-8 12125-03-9 15827-36-160-6 6848-48-18-18-18-18-18-18-18-18-18-18-18-18-18
xslick 957  xslick V996  FRA-2000 (U.S. Well Services)  xaid 655 NM  xslick 922  cide 4Frac	Friction Reducer  no data available  Anionic Friction Reducer  Scale Inhibitor no data available  Mixture  Biocidal product	Ammonium Chloride  Petroleum Distillate Sodium Chloride Ammonium Chloride N,N-bis (2-hydroxyethyl) oleamide  Petroleum Distillate Ammonium Chloride Oleic Acid Diethanolamide Alcohols, C12-16, Exoxylated Water Copolymer of 2-Propenamide Distillates (petroleum), hydotreated light Alcohol Ethoxylate Surfactant Hydrotreated light distillate (petroleum) Propenoic acid, polymer with propenamide Diethylenetriamine penta (methylene phosphonic acid) Copolymer of 2-propenaminde Distillates (petroleum), hydotreated light Ammonium chloride (INH4)CI) Oleic Acid Diethnolamide Phosphonium, tetrakis (hydroxymethyl), Sulfate Quaternary ammonium Compounds, Benzyl-C12-16-Alkyldimethyl, Chlorides Ethanol Tetrakis (hydroxymethyl) phosphonium sulphate Acrylic acid terpolymer containing carboxylate phosphonate and sulfonate	12125-02-9 64742-47-8 7647-14-5 12125-02-9 93-83-4 64742-47-8 12125-02-9 93-83-4 68551-12-2 7732-15-5
exslick 957  exslick V996  FRA-2000 (U.S. Well Services)  exaid 655 NM  exslick 922  edice 4Frac  edice PS50A	Friction Reducer  no data available  Anionic Friction Reducer  Scale Inhibitor no data available  Mixture  Biocidal product	Ammonium Chloride Petroleum Distillate Sodium Chloride Ammonium Chloride N,N-bis (2-hydroxyethyl) oleamide Petroleum Distillate Ammonium Chloride Oleic Acid Diethanolamide Alcohols, C12-16, Exoxylated Water Copolymer of 2-Propeenamide Distillates (petroleum), hydotreated light Alcohol Ethoxylate Surfactant Hydrotreated light distillate (petroleum) Propenoic acid, polymer with propenamide Diethylenetriamine penta (methylene phosphonic acid) Copolymer of 2-propenamide Diethylenetriamine penta (methylene phosphonic acid) Copolymer of 2-propenaminde Distillates (petroleum), hydotreated light Ammonium chloride ((NH4)CI) Oleic Acid Diethnolamide Phosphonium, tetrakis (hydroxymethyl), Sulfate Quaternary ammonium Compounds, Benzyl-C12-16-Alkyldimethyl, Chlorides Ethanol Tetrakis (hydroxymethyl) phosphonium sulphate Acrylic acid terpolymer containing carboxylate phosphonate and sulfonate groups	12125-02-9 64742-47-8 7647-14-5 12125-02-9 93-83-4 66742-47-8 12125-02-9 93-83-4 68551-12-2 7732-15-5 64742-47-8 9003-06-9 15827-3 9003-06-9 15827-3 12125-02-9 15827-3 12125-02-9 15827-3 12125-02-9 15827-3 12125-02-9 15827-3 12125-02-9 15827-3 12125-02-9 15827-3 12125-02-9 15827-3 12125-02-9 15827-3 15827-3 169418-26-4 164742-47-8 12125-02-9 15827-3 15827-3 169418-26-4 175-101000000000000000000000000000000000
exslick 957  exslick V996  FRA-2000 (U.S. Well Services)  exaid 655 NM  exslick 922  edice 4Frac  edice PS50A	Friction Reducer  no data available  Anionic Friction Reducer  Scale Inhibitor no data available  Mixture  Biocidal product  Friction Reducer	Ammonium Chloride  Petroleum Distillate Sodium Chloride Ammonium Chloride N,N-bis (2-hydroxyethyl) oleamide  Petroleum Distillate Ammonium Chloride Oleic Acid Diethanolamide Alcohols, C12-16, Exoxylated Water Copolymer of 2-Propeenamide Distillates (petroleum), hydotreated light Alcohol Ethoxylate Surfactant Hydrotreated light distillate (petroleum) Propenoic acid, polymer with propenamide Diethylenetriamine penta (methylene phosphonic acid) Copolymer of 2-propenaminde Distillates (petroleum), hydotreated light Ammonium chloride ((NH4)CI) Oleic Acid Diethnolamide Phosphonium, tetrakis (hydroxymethyl), Sulfate Quaternary ammonium Compounds, Benzyl-C12-16-Alkyldimethyl, Chlorides Ethanol Tetrakis (hydroxymethyl) phosphonium sulphate Acrylic acid terpolymer containing carboxylate phosphonate and sulfonate groups Hydrotreated light petroleum distillate	12125-02-9 64742-47-8 7647-14-5 12125-02-9 93-83-4 64742-47-8 12125-02-9 93-83-4 68551-12-2 7732-15-5 64742-47-8 9003-06 9 15827-3 12125-02-9 93-83-4 64742-47-8 12125-02-9 93-83-4 655566-30-8 68424-85-30-8 68424-85-30-8 68424-8
exslick 957  exslick V996  FRA-2000 (U.S. Well Services)  exaid 655 NM  exslick 922  edice 4Frac  edice PS50A	Friction Reducer  no data available  Anionic Friction Reducer  Scale Inhibitor no data available  Mixture  Biocidal product  Friction Reducer	Ammonium Chloride  Petroleum Distillate Sodium Chloride Ammonium Chloride N,N-bis (2-hydroxyethyl) oleamide  Petroleum Distillate Ammonium Chloride Oleic Acid Diethanolamide Alcohols, C12-16, Exoxylated Water Copolymer of 2-Propeenamide Distillates (petroleum), hydotreated light Alcohol Ethoxylate Surfactant Hydrotreated light distillate (petroleum) Propenoic acid, polymer with propenamide Diethylenetriamine penta (methylene phosphonic acid) Copolymer of 2-propenaminde Diethylenetriamine penta (methylene phosphonic acid) Copolymer of 2-propenaminde Diethylenetriamine policitillates (petroleum), hydotreated light Ammonium chloride ((NH4)CI) Cleic Acid Diethnolamide Phosphonium, tetrakis (hydroxymethyl), Sulfate Quaternary ammonium Compounds, Benzyl-C12-16-Alkyldimethyl, Chlorides Ethanol Tetrakis (hydroxymethyl) phosphonium sulphate Acrylic acid terpolymer containing carboxylate phosphonate and sulfonate groups Hydrotreated light petroleum distillate Ethoxylated alcohol	12125-02-9 64742-47-8 7647-14-5 12125-02-9 93-83-4 64742-47-8 12125-02-9 93-83-4 68551-12-2 7732-15-5 64742-47-8 9003-06 9 15827-3 69418-26-4 64742-47-8 12125-02-9 93-83-4 12125-02-9 94-81-81-81-81-81-81-81-81-81-81-81-81-81-
xslick 957  xslick V996  FRA-2000 (U.S. Well Services)  xaid 655 NM  xslick 922  cide 4Frac  cide PS50A	Friction Reducer  no data available  Anionic Friction Reducer  Scale Inhibitor no data available  Mixture  Biocidal product  Friction Reducer	Ammonium Chloride  Petroleum Distillate Sodium Chloride Ammonium Chloride N,N-bis (2-hydroxyethyl) oleamide  Petroleum Distillate Ammonium Chloride Oleic Acid Diethanolamide Alcohols, C12-16, Exoxylated Water Copolymer of 2-Propenamide Distillates (petroleum), hydotreated light Alcohol Ethoxylate Surfactant Hydrotreated light distillate (petroleum) Propenoic acid, polymer with propenamide Diethylenetriamine penta (methylene phosphonic acid) Copolymer of 2-propenaminde Distillates (petroleum), hydotreated light Ammonium chloride ((NH4)CI) Oleic Acid Diethnolamide Phosphonium, tetrakis (hydroxymethyl), Sulfate Quaternary ammonium Compounds, Benzyl-C12-16-Alkyldimethyl, Chlorides Ethanol Tetrakis (hydroxymethyl) phosphonium sulphate Acrylic acid terpolymer containing carboxylate phosphonate and sulfonate groups Hydrotreated light petroleum distillate Ethoxylated alcohol Poly (oxy-1.2-ethanediyl) alphatridecylomegahydroxy-, branched	12125-02-9 64742-47-8 7647-14-5 12125-02-9 93-83-4 64742-47-8 12125-02-9 93-83-4 68551-12-2 7732-15-5 64742-47-8 9003-06 9 15827-3 66448-26-4 64742-47-8 93-83-4 65556-30-8 68424-85-6-07 64-17-5 Nironmental Pro 55556-30-8 64-17-5 Nironmental Pro 67472-47-8 7972-5-5-7
xslick 957  xslick V996  FRA-2000 (U.S. Well Services)  xaid 655 NM  xslick 922  cide 4Frac  cide PS50A	Friction Reducer  no data available  Anionic Friction Reducer  Scale Inhibitor no data available  Mixture  Biocidal product  Friction Reducer	Ammonium Chloride Petroleum Distillate Sodium Chloride Ammonium Chloride N,N-bis (2-hydroxyethyl) oleamide Petroleum Distillate Ammonium Chloride Oleic Acid Diethanolamide Alcohols, C12-16, Exoxylated Water Copolymer of 2-Propeenamide Distillates (petroleum), hydotreated light Alcohol Ethoxylate Surfactant Hydrotreated light distillate (petroleum) Propenoic acid, polymer with propenamide Diethylenetriamine penta (methylene phosphonic acid) Copolymer of 2-propenaminde Distillates (petroleum), hydotreated light Ammonium chloride ((NH4)CI) Oleic Acid Diethnolamide Phosphonium, tetrakis (hydroxymethyl), Sulfate Quaternary ammonium Compounds, Benzyl-C12-16-Alkyldimethyl, Chlorides Ethanol Tetrakis (hydroxymethyl) phosphonium sulphate Acrylic acid terpolymer containing carboxylate phosphonate and sulfonate groups Hydrotreated light petroleum distillate Ethoxylated alcohol Poly (oxy-1.2-ethanediyl) alphatridecylomegahydroxy-, branched Methanol	12125-02-9 64742-47-8 7647-14-5 12125-02-9 93-83-4 66742-47-8 12125-02-9 93-83-4 68551-12-2 7732-15-5 64742-47-8 9003-06-9 15827-3 12125-02-9 15827-3 12125-02-9 15827-3 12125-02-9 15827-3 12125-02-9 15827-3 12125-02-9 15827-3 12125-02-9 15827-3 12125-02-9 15827-3 12125-02-9 15827-3 12125-02-9 15827-3 12125-02-9 15827-3 12125-02-9 15827-3 12125-02-9 15827-3 12125-02-9 15827-3 12125-02-9 15827-3 12125-02-9 15827-3 12125-02-9 15827-3 12125-02-9 15827-3 16911-36-5 16911-36-5 169011-36-5 167-56-1
xslick 957  xslick V996  xslick V996  xaid 655 NM xslick 922  cide 4Frac  cide PS50A  2950	Friction Reducer  no data available  Anionic Friction Reducer  Scale Inhibitor no data available  Mixture  Biocidal product  Friction Reducer  Scale Control	Ammonium Chloride Petroleum Distillate Sodium Chloride Ammonium Chloride N,N-bis (2-hydroxyethyl) oleamide Petroleum Distillate Ammonium Chloride Oleic Acid Diethanolamide Alcohols, C12-16, Exoxylated Water Copolymer of 2-Propeenamide Distillates (petroleum), hydotreated light Alcohol Ethoxylate Surfactant Hydrotreated light distillate (petroleum) Propenoic acid, polymer with propenamide Diethylenetriamine penta (methylene phosphonic acid) Copolymer of 2-propenaminde Distillates (petroleum), hydotreated light Ammonium chloride ((NH4)CI) Cleic Acid Diethnolamide Phosphonium, tetrakis (hydroxymethyl), Sulfate Quaternary ammonium Compounds, Benzyl-C12-16-Alkyldimethyl, Chlorides Ethanol Tetrakis (hydroxymethyl) phosphonium sulphate Acrylic acid terpolymer containing carboxylate phosphonate and sulfonate groups Hydrotreated light petroleum distillate Ethoxylated alcohol Poly (oxy-1.2-ethanediyl) alphatridecylomegahydroxy-, branched Methanol Phosphonic Acid Salt	12125-02-9 64742-47-8 7647-14-5 12125-02-9 93-83-4 64742-47-8 12125-02-9 93-83-4 68551-12-2 7732-15-5 64742-47-8 9003-06 9 15827-3 659418-264 64742-47-8 12125-02-9 93-83-4 655566-30-8 68424-85-30-8 68424-85-30-8 68424-85-30-8 68725-65-07 64742-47-8 Proprietary 69011-36-5 67-56-1 Proprietary
exslick 957  exslick V996  FRA-2000 (U.S. Well Services)  xaid 655 NM  xslick 922  cide 4Frac  cide PS50A  2950  end LD-7750W  MX 8-4743	Friction Reducer  no data available  Anionic Friction Reducer  Scale Inhibitor no data available  Mixture  Biocidal product  Friction Reducer  Scale Control  Specialty Product	Ammonium Chloride Petroleum Distillate Sodium Chloride Ammonium Chloride N,N-bis (2-hydroxyethyl) oleamide Petroleum Distillate Ammonium Chloride Oleic Acid Diethanolamide Alcohols, C12-16, Exoxylated Water Copolymer of 2-Propeenamide Distillates (petroleum), hydotreated light Alcohol Ethoxylate Surfactant Hydrotreated light distillate (petroleum) Propenoic acid, polymer with propenamide Diethylenetriamine penta (methylene phosphonic acid) Copolymer of 2-propenaminde Distillates (petroleum), hydotreated light Ammonium chloride ((NH4)CI) Oleic Acid Diethnolamide Phosphonium, tetrakis (hydroxymethyl), Sulfate Quaternary ammonium Compounds, Benzyl-C12-16-Alkyldimethyl, Chlorides Ethanol Tetrakis (hydroxymethyl) phosphonium sulphate Acrylic acid terpolymer containing carboxylate phosphonate and sulfonate groups Hydrotreated light petroleum distillate Ethoxylated alcohol Poly (oxy-1.2-ethanediyl) alphatridecylomegahydroxy-, branched Methanol Phosphonic Acid Salt Sodium Nitrate	12125-02-9 64742-47-8 7647-14-5 12125-02-9 93-83-4 64742-47-8 12125-02-9 93-83-4 68551-12-2 7732-15-5 64742-47-8 9003-06 9 15827-3 69418-26-4 64742-47-8 12125-02-9 93-83-4 65756-30-8 68424-853-4 64-17-3-wironmental Pro 64742-47-8 Proprietary 69011-36-5 67-56-1 Proprietary 7631-99-4
exslick 957  exslick V996  FRA-2000 (U.S. Well Services)  xaid 655 NM  xslick 922  cide 4Frac  cide PS50A  2950  end LD-7750W  MX 8-4743 riplex 80	Friction Reducer  no data available  Anionic Friction Reducer  Scale Inhibitor no data available  Mixture  Biocidal product  Friction Reducer  Scale Control  Specialty Product Iron Control	Ammonium Chloride Petroleum Distillate Sodium Chloride Ammonium Chloride N,N-bis (2-hydroxyethyl) oleamide Petroleum Distillate Ammonium Chloride Oleic Acid Diethanolamide Alcohols, C12-16, Exoxylated Water Copolymer of 2-Propenamide Distillates (petroleum), hydotreated light Alcohol Ethoxylate Surfactant Hydrotreated light distillate (petroleum) Propenoic acid, polymer with propenamide Diethylenetriamine penta (methylene phosphonic acid) Copolymer of 2-propenaminde Distillates (petroleum), hydotreated light Alcohol Ethoxylate Surfactant Hydrotreated light distillate (petroleum) Propenoic acid, polymer with propenamide Diethylenetriamine penta (methylene phosphonic acid) Copolymer of 2-propenaminde Distillates (petroleum), hydotreated light Ammonium chloride ((NH4)CI) Oleic Acid Diethnolamide Phosphonium, tetrakis (hydroxymethyl), Sulfate Quaternary ammonium Compounds, Benzyl-C12-16-Alkyldimethyl, Chlorides Ethanol Tetrakis (hydroxymethyl) phosphonium sulphate Acrylic acid terpolymer containing carboxylate phosphonate and sulfonate groups Hydrotreated light petroleum distillate Ethoxylated alcohol Poly (oxy-1.2-ethanediyl) alphatridecylomegahydroxy-, branched Methanol Phosphonic Acid Salt Sodium Nitrate Sodium nythorbate	12125-02-9 64742-47-8 7647-14-5 12125-02-9 93-83-4 66742-47-8 12125-02-9 93-83-4 68551-12-2 7732-15-5 ***** 64742-47-8 9003-06-9 15827-3676-6 9418-26-4 64742-47-8 93-83-4 55566-30-8 68424-85-30-8 68424-85-30-8 68424-8-8 68424-8-8 68424-8-8 68424-8-8 68424-8-8 68424-8-8 68424-8-8 68424-8-8 68424-8 68424-8 68424-8 68424-8 68424-8 68424-8 68424-8 68424-8 68424-8 68424-8 68424-8 68
exslick 957  exslick V996  FRA-2000 (U.S. Well Services)  xaid 655 NM  xslick 922  cide 4Frac  cide PS50A  2950  end LD-7750W  MX 8-4743 riplex 80	Friction Reducer  no data available  Anionic Friction Reducer  Scale Inhibitor no data available  Mixture  Biocidal product  Friction Reducer  Scale Control  Specialty Product Iron Control Scale Inhibitor	Ammonium Chloride Petroleum Distillate Sodium Chloride Ammonium Chloride N,N-bis (2-hydroxyethyl) oleamide Petroleum Distillate Ammonium Chloride Oleic Acid Diethanolamide Alcohols, C12-16, Exoxylated Water Copolymer of 2-Propeenamide Distillates (petroleum), hydotreated light Alcohol Ethoxylate Surfactant Hydrotreated light distillate (petroleum) Propenoic acid, polymer with propenamide Diethylenetriamine penta (methylene phosphonic acid) Copolymer of 2-propenaminde Distillates (petroleum), hydotreated light Ammonium chloride ((NH4)CI) Oleic Acid Diethnolamide Phosphonium, tetrakis (hydroxymethyl), Sulfate Quaternary ammonium Compounds, Benzyl-C12-16-Alkyldimethyl, Chlorides Ethanol Tetrakis (hydroxymethyl) phosphonium sulphate Acrylic acid terpolymer containing carboxylate phosphonate and sulfonate groups Hydrotreated light petroleum distillate Ethoxylated alcohol Poly (oxy-1.2-ethanediyl) alphatridecylomegahydroxy-, branched Methanol Phosphonic Acid Salt Sodium Nitrate	12125-02-9 64742-47-8 7647-14-5 12125-02-9 93-83-4 64742-47-8 12125-02-9 93-83-4 68551-12-2 7732-15-5 64742-47-8 9003-06 9 15827-3 69418-26-4 64742-47-8 12125-02-9 93-83-4 65756-30-8 68424-853-4 64-17-3-wironmental Pro 64742-47-8 Proprietary 69011-36-5 67-56-1 Proprietary 7631-99-4

OPERATOR: SWN Production Co., LLC	WELL NO: Carl Rotter OHI 3H
PAD NAME: Carl Rotter OHI	
REVIEWED BY:	_ SIGNATURE: BILLLONG WOODLY
WELL RESTRICTI	ONS CHECKLIST
TIONTEGE	

### HORIZONTAL 6A WELL

Well Rest	rictions	* Pad	Built 4	du/13
	At Least 100 Feet from Pad and LOD (including an Perennial Stream, Lake, Pond, Reservoir or Wetland	y E&S Cor l; OR	ntrol Feature) to	any
<b>-</b>	DEP Waiver and Permit Conditions			
	At Least 300 Feet from Pad and LOD (including any Naturally Producing Trout Stream; OR	y E&S Con	ntrol Feature) to	any
	DEP Waiver and Permit Conditions			
	At Least 1000 Feet from Pad and LOD (including ar Groundwater Intake or Public Water Supply; OR	ny E&S Co	ontrol Feature) to	o any
	DEP Waiver and Permit Conditions			
$\checkmark$	At Least 250 Feet from an Existing Water Well or D Drilled; OR	eveloped S	Spring to Well B	Being
	Surface Owner Waiver and Recorded with Co	ounty Clerl	k, OR	
	DEP Variance and Permit Conditions		DE	P.France
	At Least 625 Feet from an Occupied Dwelling Struct	ure to Cen	Office Of the Pad; (	Oil and Gas OR
	Surface Owner Waiver and Recorded with Co	ounty Clerk	k, OR	8
	DEP Variance and Permit Conditions		Environments	Protection
	At Least 625 Feet from Agricultural Buildings Larger of the Pad; OR	r than 250(	O Square Feet to	the Center
	Surface Owner Waiver and Recorded with Co	ounty Clerk	k, OR	
	DEP Variance and Permit Conditions			

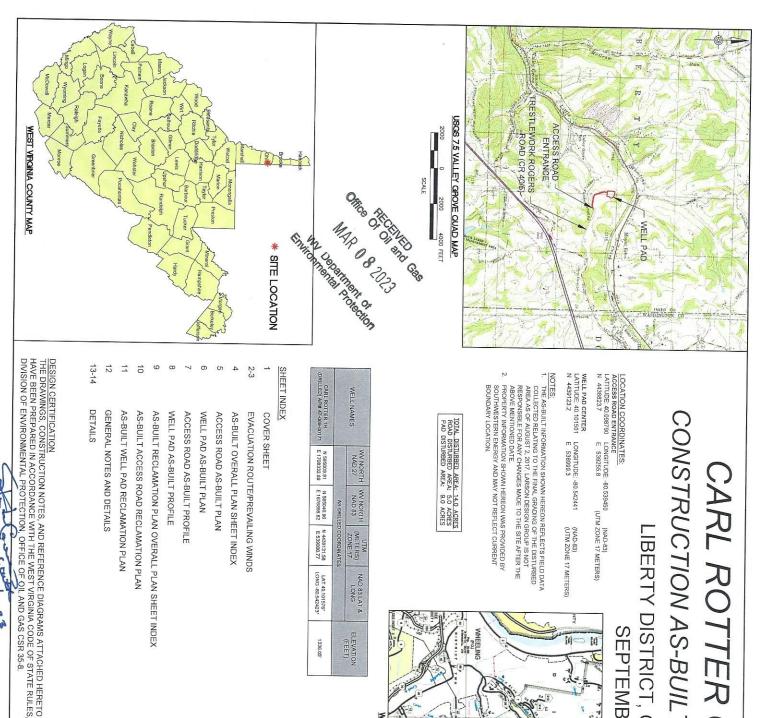

# CONSTRUCTION AS-BUILT & RECLAMATION PLAN CARL ROTTER OHI WELL PAD

# LIBERTY DISTRICT, OHIO COUNTY, WV SEPTEMBER 2017

OCATION COORDINATES:


LATITUDE: 40.098790 LONGITUDE: -80.539450 N 4438823.7 E 539255.8

0 (NAD-83)
(UTM ZONE 17 METERS)

III

WELL PAD CENTER
LATITUDE: 40.101501 LONGITUDE: -80.542441
-- 4494733 2 E 538999.3

(NAD-83) (UTM ZONE 17 METERS)

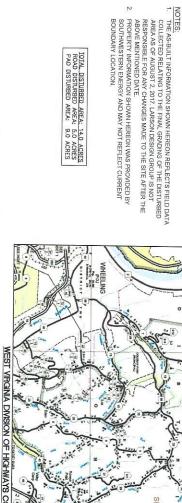

TOTAL DISTURBED AREA: 14.0 ACRES
ROAD DISTURBED AREA: 5.0 ACRES
PAD DISTURBED AREA: 9.0 ACRES





			VEST VIRGIN
		ψ.	$\sim$
		5000	DIVISION OF
SCALE	l	0	11
ALE:		5000	<b>IIGHWAYS</b>
		10000 FEET	HIGHWAYS COUNTY ROAD
			DAOF

ENGINEERING ESTIMATE OF QUANTITIES	TE OF QU/	ANTITIES
WELL SITE PAD DATA (DRILLING)	ATA (DRILL	ING)
STALL MOUNTABLE BERM	44	CY
REAS	205	ΥS
"COMPOST SOCK	252	두
ONE FOR PAD SURFACE PAIR AND MOUNTABLE RM STONE SURFACING	143	СУ
WELL SITE PAD DATA (RECLAMATION)	(RECLAM	ATION)
MOVE SUMP	2	EA
REACH BERM	2	EA
WIDE RIP-RAP	30	CY

무선 무 교 명 교 의 경 수 의 된

EVACUATION ROUTE/PREVAILING WINDS

COVER SHEET

N 585046.96 E 1676898.62

N 4439131.58 E 539000.77

LAT 40.101576\* LONG -80.542423\*

1336.05

WW NORTH NAD 83

(METERS) ZONE 17

NAD 83 LAT & LONG

ELEVATION (FEET)

	AND
Soc	(1)
white	0)
/est	
ern	
Ene	
38Je	
*	MA
	1 1
	~
	+

STRAST

DETAILS

GENERAL NOTES AND DETAILS

AS-BUILT ACCESS ROAD RECLAMATION PLAN

AS-BUILT RECLAMATION PLAN OVERALL PLAN SHEET INDEX

AS-BUILT WELL PAD RECLAMATION PLAN

WELL PAD AS-BUILT PROFILE

ACCESS ROAD AS-BUILT PROFILE WELL PAD AS-BUILT PLAN ACCESS ROAD AS-BUILT PLAN AS-BUILT OVERALL PLAN SHEET INDEX

West Virginia State Law (Section XIV. Chapter 24-C)
Requires that you call two business days before you dig in the state of West Virginia.
IT'S THE LAW!! MISS Utility of West Virginia 1-800-245-4848



4

Strain.	SHOT N	RICE AND		
SONAL ENGR	STATE OF	~ 7	-=	
	- 11	S 4 2 S O		
PROJECT NO .:		ANSI FU (22.00 X	ORIGINAL SHE	

CARL ROTTER OHI SWN Production Company, LLC 179 Innovation Drive Jane Lew, WV 26378 PHONE 304.884.1622

WELL, Larson Design Group • Architects Engineers Su 2502 Cranberry Square Morgantown, WV 26508 PHONE 304.777.2940 TOLL FREE 877.323.660 FAX 570.323.9902 • www.larsondesigngroup.co

			04	1/
1	10/9/2017	FINAL AS-BUILT PLAN	BLG	RMR
0	9/14/2017	DRAFT AS-BUILT PLAN	BLG	RMR
NO.	DATE	COMMENTS	BY	СНК
		ISSUE / REVISIONS	101	0.11



4/2023