

8504358P

WW-7  
8-30-06



West Virginia Department of Environmental Protection  
Office of Oil and Gas  
**WELL LOCATION FORM: GPS**

API: 47-085-04358 WELL NO.: Leeson 5-A

FARM NAME: Southfork Sportsman Assoc. Inc.

RESPONSIBLE PARTY NAME: J F D eem

COUNTY: Ritchie DISTRICT: Union

QUADRANGLE: Auburn

SURFACE OWNER: South Fork Sportsman Assoc., Inc.

ROYALTY OWNER: C. Leeson

UTM GPS NORTHING: 4,332,000

UTM GPS EASTING: 507,932 GPS ELEVATION: 238M

781 FT,

The Responsible Party named above has chosen to submit GPS coordinates in lieu of preparing a new well location plat for a plugging permit or assigned API number on the above well. The Office of Oil and Gas will not accept GPS coordinates that do not meet the following requirements:

- Datum: NAD 1983, Zone: 17 North, Coordinate Units: meters, Altitude: height above mean sea level (MSL) – meters.
- Accuracy to Datum – 3.05 meters
- Data Collection Method:  
Survey grade GPS \_\_\_\_ : Post Processed Differential \_\_\_\_  
Real-Time Differential \_\_\_\_  
Mapping Grade GPS \_\_\_\_ : Post Processed Differential \_\_\_\_  
Real-Time Differential \_\_\_\_

RECEIVED  
Office of Oil and Gas  
SEP 20 2013

WV Department of  
Environmental Protection

4. Letter size copy of the topography map showing the well location.


I the undersigned, hereby certify this data is correct to the best of my knowledge and belief and shows all the information required by law and the regulations issued and prescribed by the Office of Oil and Gas.

J F D eem  
Signature

Owner  
Title

9/17/13  
Date

8504358P

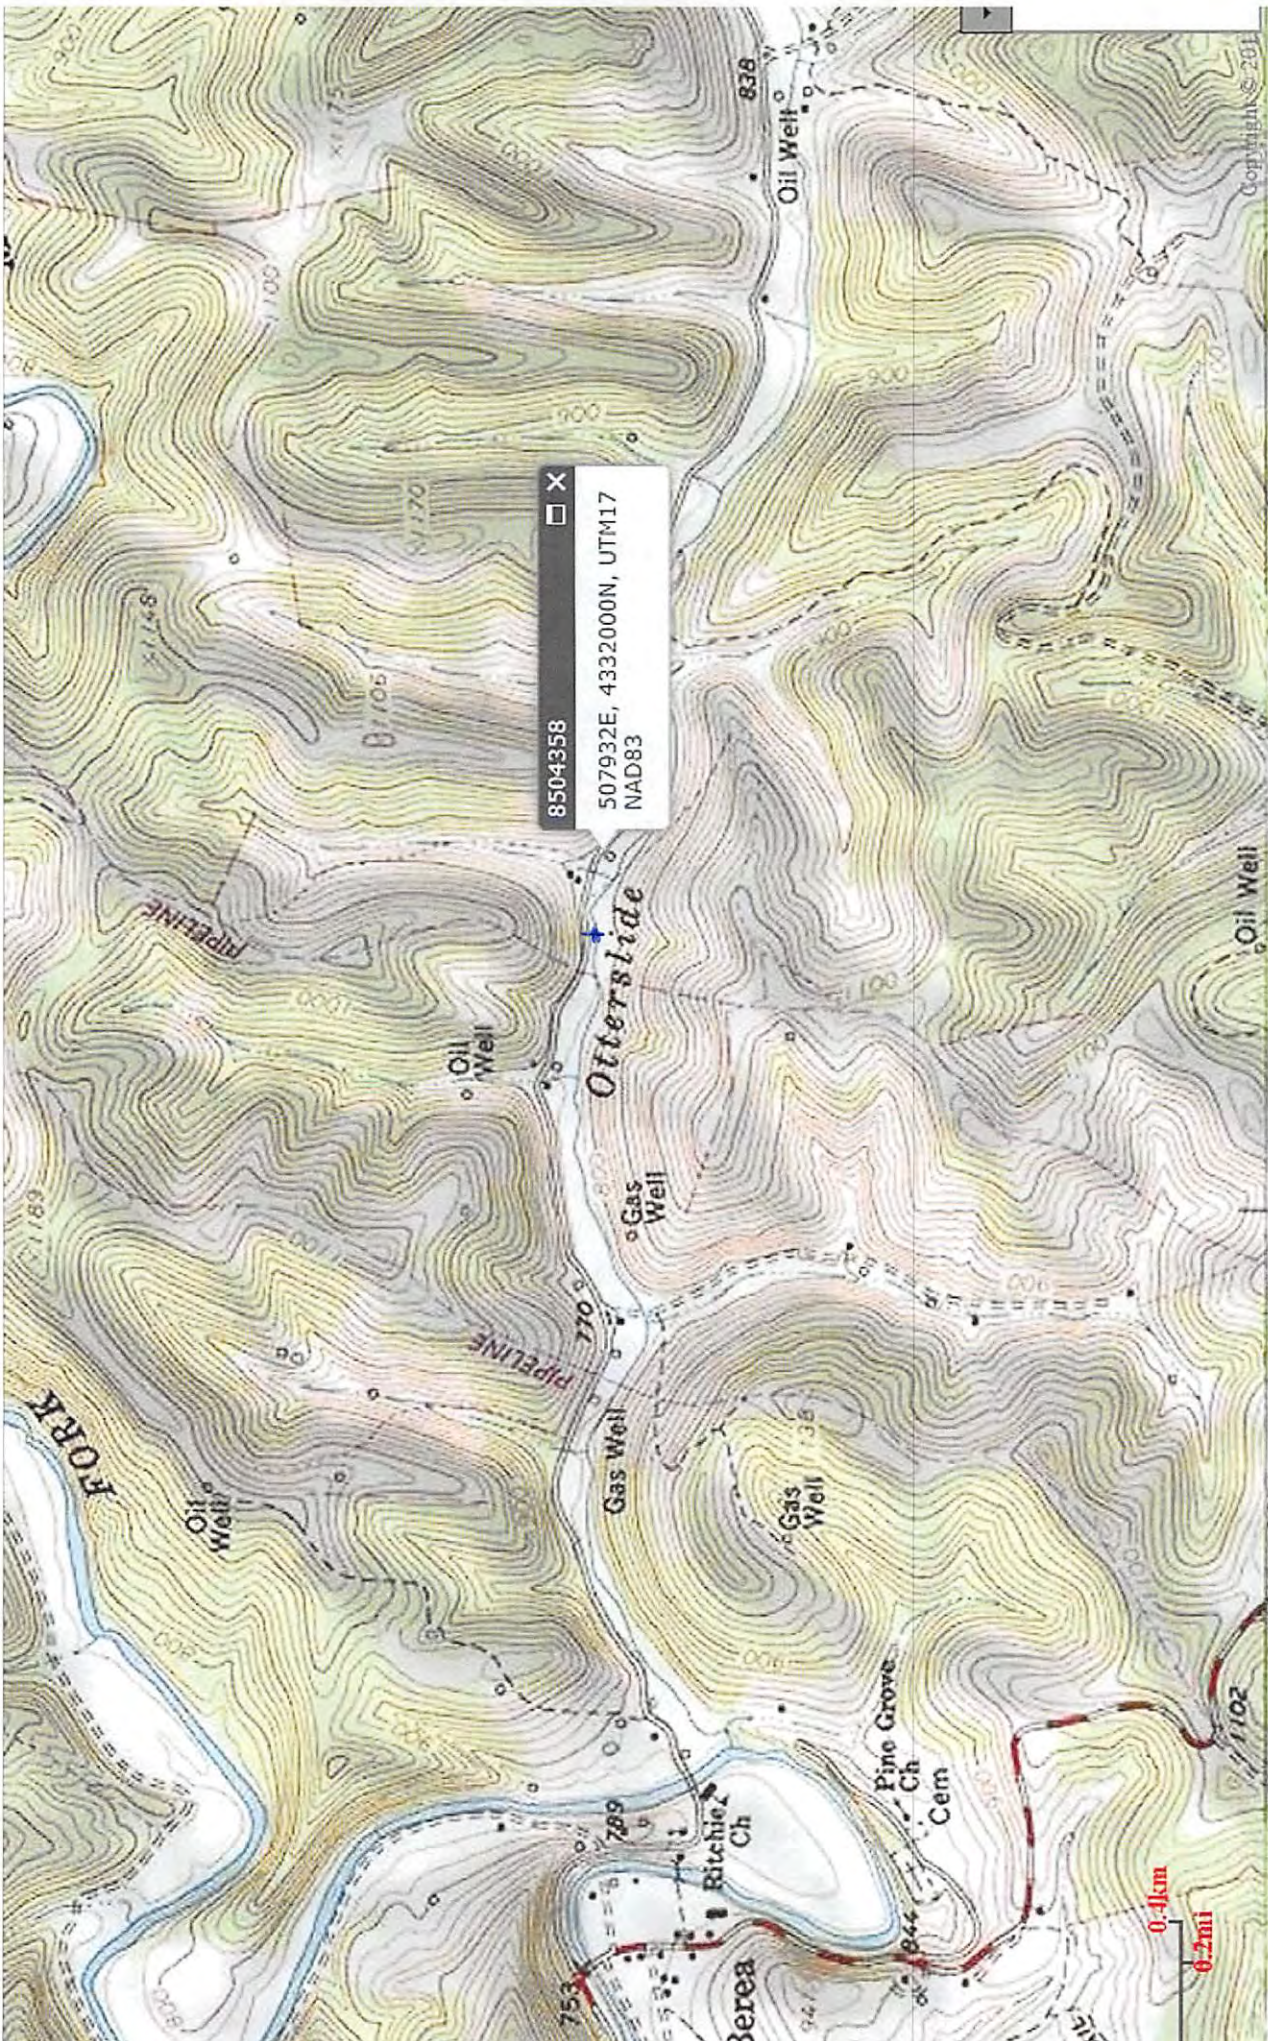

8504358  X  
507932E, 4332000N, UTM17  
NAD83

Copyright © 2011