

WW-7
8-30-06



West Virginia Department of Environmental Protection
Office of Oil and Gas

WELL LOCATION FORM: GPS

API: 47-085-05216 WELL NO.: 11
FARM NAME: Dawson
RESPONSIBLE PARTY NAME: Unknown DEP Paid Plugging Contract
COUNTY: Ritchie DISTRICT: Murphy
QUADRANGLE: MacFarlan
SURFACE OWNER: Naomi Clark
ROYALTY OWNER: _____
UTM GPS NORTHING: 4 86 251
UTM GPS EASTING: 43 23 575 GPS ELEVATION: 778'

The Responsible Party named above has chosen to submit GPS coordinates in lieu of preparing a new well location plat for a plugging permit or assigned API number on the above well. The Office of Oil and Gas will not accept GPS coordinates that do not meet the following requirements:

1. Datum: NAD 1983, Zone: 17 North, Coordinate Units: meters, Altitude: height above mean sea level (MSL) – meters.
2. Accuracy to Datum – 3.05 meters
3. Data Collection Method:

Survey grade GPS ____: Post Processed Differential ____

Real-Time Differential ____

Mapping Grade GPS X: Post Processed Differential ____


Real-Time Differential ____

4. Letter size copy of the topography map showing the well location.

I the undersigned, hereby certify this data is correct to the best of my knowledge and belief and shows all the information required by law and the regulations issued and prescribed by the Office of Oil and Gas.

Bryan Harris	Inspector Specialist	June 10, 2025
Signature	Title	Date

08/22/2025

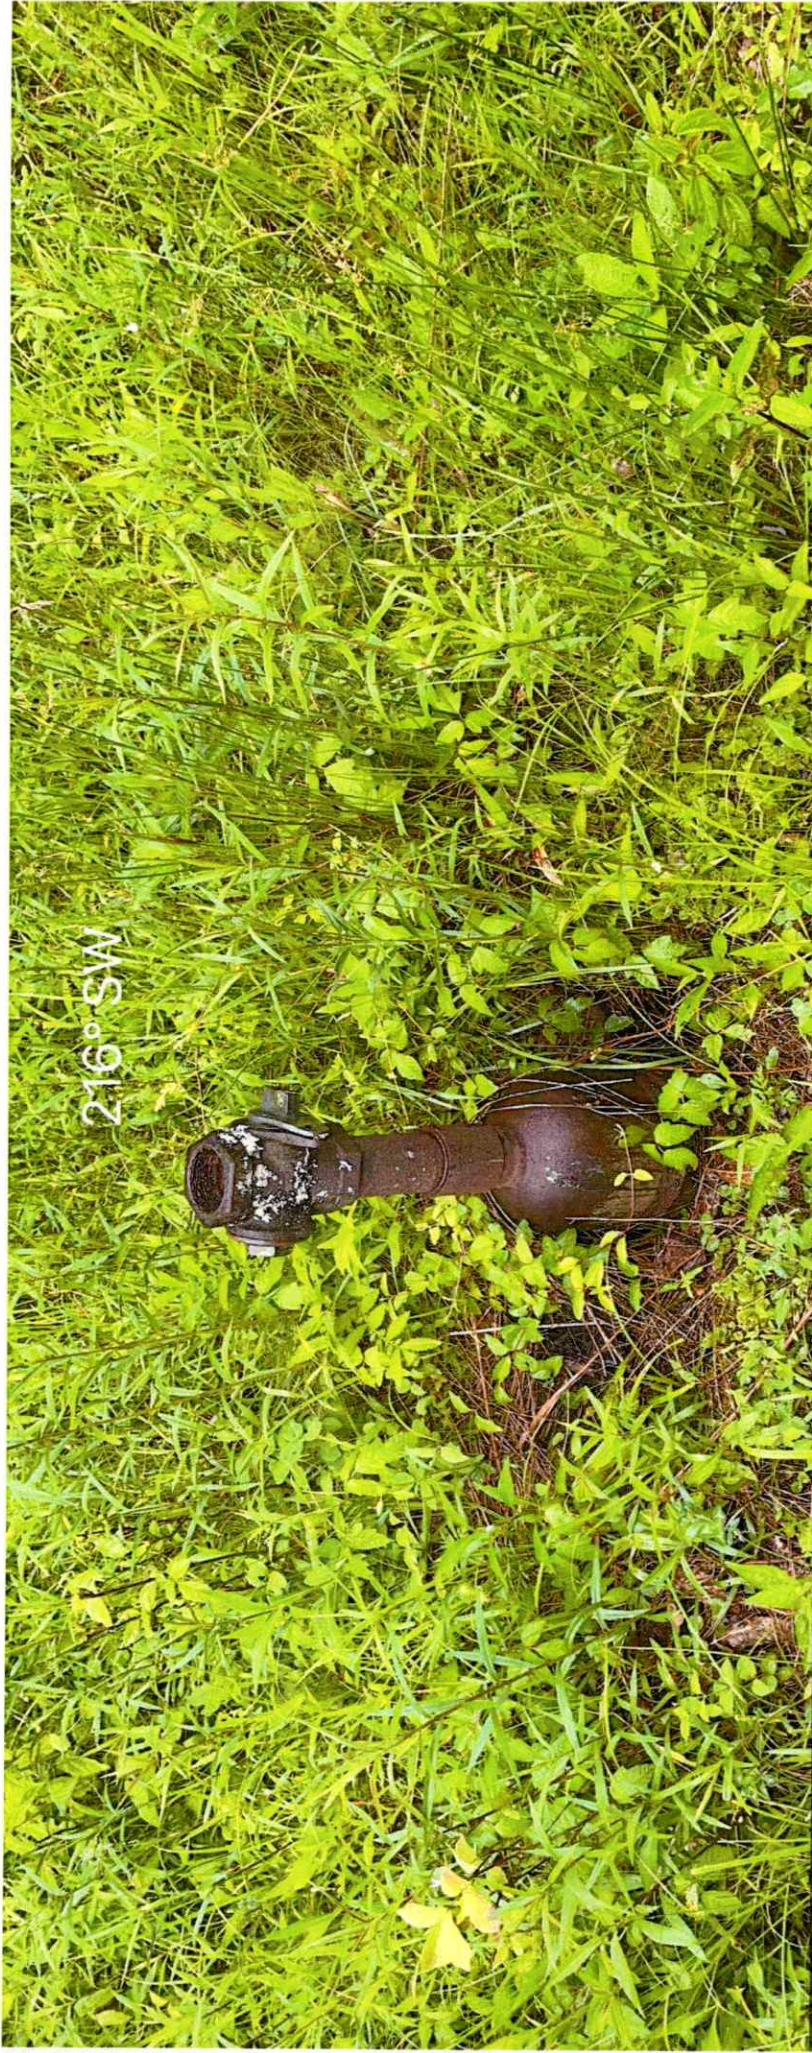

216° SW

Latitude

39.061163°

LOCAL 10:59 AM

Longitude

-81.158956°

TUESDAY 05.27.2025

ALTITUDE 226 FEET

08/22/2025