

STATE OF WEST VIRGINIA  
DEPARTMENT OF ENVIRONMENTAL PROTECTION  
OFFICE OF OIL AND GAS

AFFIDAVIT OF PLUGGING AND FILLING WELL

AFFIDAVIT SHOULD BE IN TRIPLICATE, one copy mailed to the Department, one copy to be retained by the Well Operator and the third copy (and extra copies if required) should be mailed to each coal operator at their respective addresses.

Farm name: Hissem-Ball Operator Well No.: 1

LOCATION: Elevation: 804.2 Quadrangle: Ellenboro 7.5  
District: Grant County: Ritchie  
Latitude: 39.258145 Feet South of NA Deg. NA Min. NA Sec.  
Longitude: -81.080619 Feet West of NA Deg. NA Min. NA Sec.

RECEIVED  
Office of Oil & Gas  
OCT 19 2022

WV Department of  
Environmental Protection

Well Type: OIL  GAS

Company Haight Energy Corporation Coal Operator NA  
12864 Staunton TPKE or Owner \_\_\_\_\_  
Smithville, WV 26178 \_\_\_\_\_  
Agent Brian Haught Coal Operator NA  
Permit Issued Date 6-17-2021 or Owner \_\_\_\_\_

AFFIDAVIT

STATE OF WEST VIRGINIA,  
County of Ritchie ss:

Brian Haught and Mike Goff being first duly sworn according to law depose and say that they are experienced in the work of plugging and filling oil and gas wells and were employed by the above named well operator, and participated in the work of plugging and filling the above well say that said work was commenced on the 21st day of July, 2022, and the well was plugged and filled in the following manner:

\*\*\*SEE ATTACHED AFFIDAVIT\*\*\*

TYPE	FROM	TO	PIPE REMOVED	LEFT
Brine Water	5560	3917	Set Bridge Plugs at 4362' & 3917	4-1/2" Casing
Class A Cement Plug	3917	3290	NA	4-1/2" Casing & 2-3/8 tubing - filled in
Bentonite Gel Spacer	3290	1348	2-3/8" tubing	4-1/2" Casing
Class A Cement Plug	1348	960	4-1/2" Casing	8-5/8" Casing (CTS)
Bentonite Gel Spacer	960	840	4-1/2" Casing	8-5/8" Casing (CTS)
Class A Cement Plug	840	740	4-1/2" Casing	8-5/8" Casing (CTS)
Bentonite Gel Spacer	740	240	4-1/2" Casing	8-5/8" Casing (CTS)
Class A Cement Plug	240	Surface	4-1/2" Casing	8-5/8" Casing (CTS)


Description of monument: 7' Casing with Stamped Aluminum Signage and that the work of plugging and filling said well was completed on the 11th day of August, 2022.

And further deponents saith not.

Sworn and subscribe before me this 5 day of October, 2022

My commission expires: 10/18/2023

Hannah M Weiford  
Notary Public

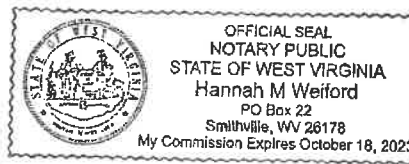

Affidavit reviewed by the Office of Oil and Gas: Stephen Mccoy Digitally signed by Stephen Mccoy Date: 2022.10.07 08:14:11 -0400 Title: WV Oil and Gas Inspector

10/21/2022

**Well Plugging Schematic**

**Well: Hissem - Ball 1**  
**47-085-05755**

**Current Status**  
No Production - Plugged


**Action Items**  
- Well Plugged using procedure as shown  
- All Processes approved by onsite DEP Inspector - Doug Newlon

**Record TD 5580'**

**4-1/2" TOC 3,000'**

**Perforations:**

3,380 - 3,530  
3,950 - 4,200  
5,150 - 5,560

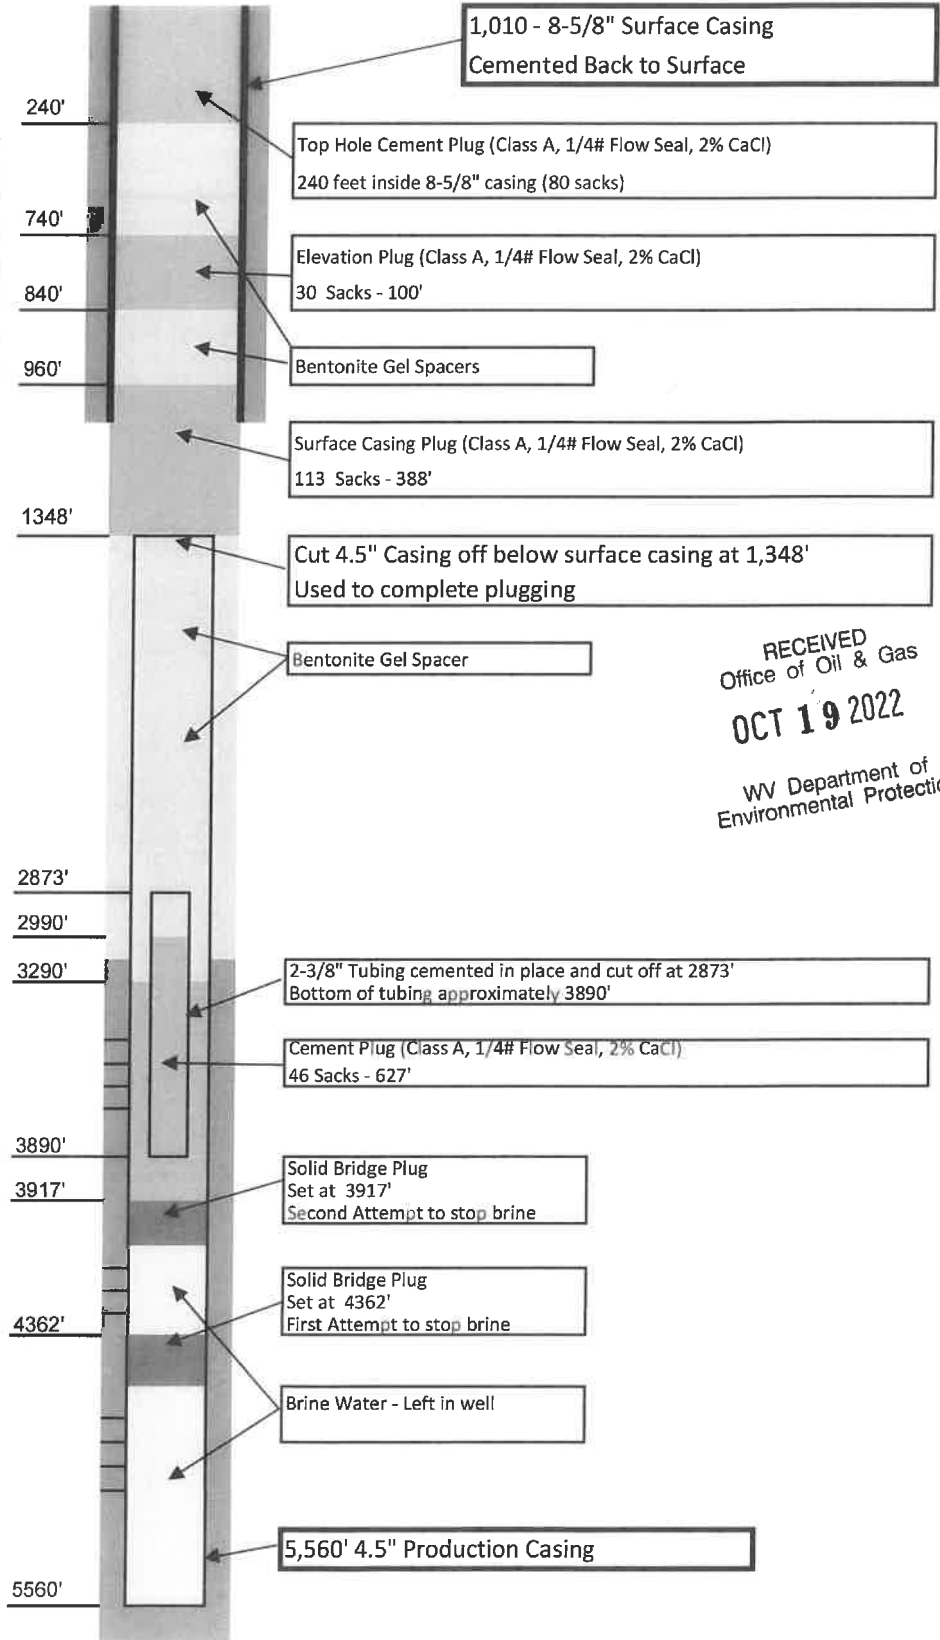

RECEIVED  
Office of Oil & Gas  
**OCT 19 2022**  
WV Department of  
Environmental Protection