

WW-7  
8-30-06



West Virginia Department of Environmental Protection  
Office of Oil and Gas

**WELL LOCATION FORM: GPS**

API: 47-085-06853 WELL NO.: #1  
 FARM NAME: GRIFFITH  
 RESPONSIBLE PARTY NAME: RITCHIE PETROLEUM CORP  
 COUNTY: RITCHIE DISTRICT: CLAY  
 QUADRANGLE: ELLENBORO  
 SURFACE OWNER: JACOB P. GRIFFITH  
 ROYALTY OWNER: JACOB P. GRIFFITH  
 UTM GPS NORTHING: 4344857.4  
 UTM GPS EASTING: 494745.6 GPS ELEVATION: 870'

The Responsible Party named above has chosen to submit GPS coordinates in lieu of preparing a new well location plat for a plugging permit or assigned API number on the above well. The Office of Oil and Gas will not accept GPS coordinates that do not meet the following requirements:

1. Datum: NAD 1983, Zone: 17 North, Coordinate Units: meters, Altitude: height above mean sea level (MSL) – meters.
2. Accuracy to Datum – 3.05 meters
3. Data Collection Method:

Survey grade GPS \_\_\_\_ : Post Processed Differential \_\_\_\_

Real-Time Differential \_\_\_\_

Mapping Grade GPS \_\_\_\_ : Post Processed Differential XX

Real-Time Differential \_\_\_\_

4. **Letter size copy of the topography map showing the well location.**

I the undersigned, hereby certify this data is correct to the best of my knowledge and belief and shows all the information required by law and the regulations issued and prescribed by the Office of Oil and Gas.

J. A. W. S. B. D.  
Signature

Treasurer  
Title

3-9-22  
Date


RECEIVED  
Office of Oil and Gas

MAR 24 2022

WV Department of  
Environmental Protection

04/08/2022

4708506853P

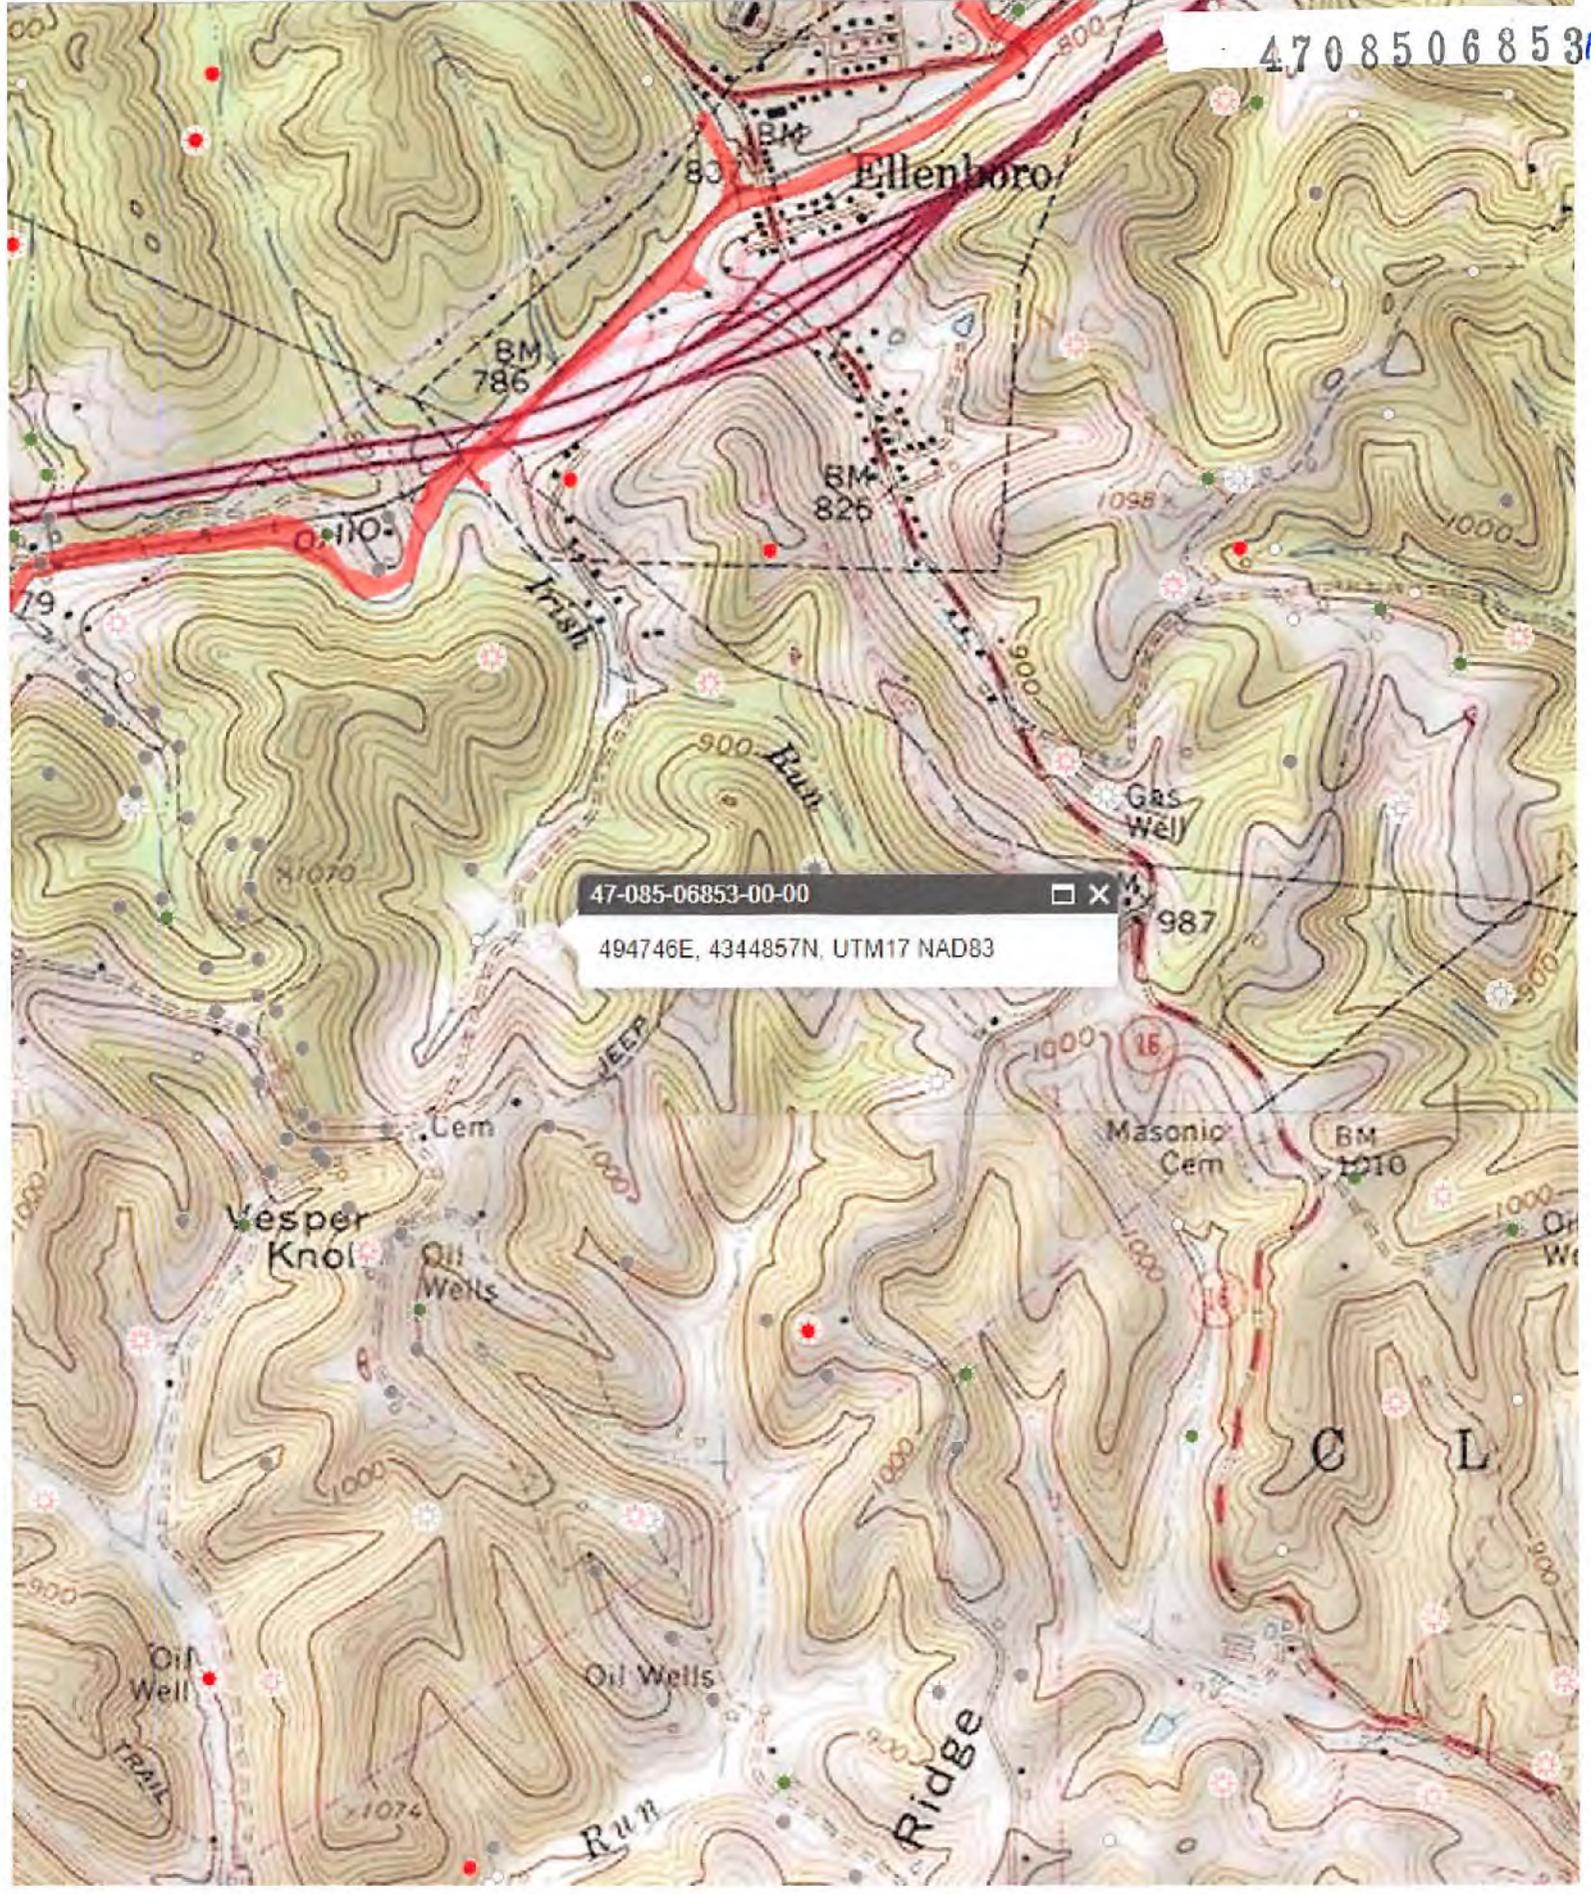

47-085-06853-00-00

494746E, 4344857N, UTM17 NAD83

04/08/2022