

WELL NO. 1  
STATE PLANE COORDINATES  
(SOUTH ZONE NAD '27)  
N. 254,356  
E. 1,552,392

WELL NO. 1 (NAD 27)  
LAT=(N) 39.18756  
LONG=(W) 81.07920

WELL NO. 1 (NAD 27)  
LAT=(N) 39°11'15.2"  
LONG=(W) 81°04'45.1"

UTM (NAD 83) (METERS)  
N. 4,337,602  
E. 493,174


# BLANEY LEASE 53.25 ACRES± WELL NO. 1 47-085-7709

CHARLES & MARLENE STINE  
150 ACRES±

CHARLES & MARLENE STINE  
39.917 ACRES±

CLARENCE & GRETA KIMBLER  
10.804 ACRES±

NORTH

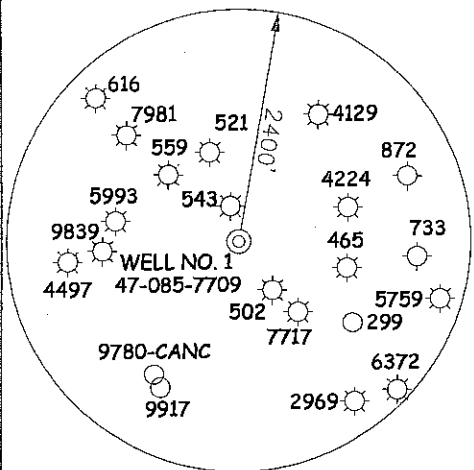

FENCE POST (FOUND)

543  
N 03°49' W  
745.08'  
N 12°59' W  
375.16'

47-085-7709 WELL NO. 1

39.25 OF 53.25±

DRAIN

RONALD & SHELIA LAYFIELD  
53.25 ACRES±

RONALD & SHELIA LAYFIELD  
7 ACRES±

RONALD & SHELIA LAYFIELD  
100 ACRES±

14 OF 53.25±

HARRY HOLBERT  
8.85 ACRES±

31

### NOTES ON SURVEY

1. TIES TO WELLS AND CORNERS ARE BASED ON GRID NORTH FOR THE WV STATE PLANE COORDINATE SYSTEM NORTH ZONE NAD '27.
2. LEASE BOUNDARY SHOWN HEREON TAKEN FROM WELL PLAT 47-085-7709 PREPARED BY DARRELL R. BOICE LLS 667 ON 10-29-1987.
3. SURFACE OWNER AND ADJOINER INFORMATION TAKEN FROM THE ASSESSOR AND COUNTY CLERK RECORDS OF RITCHIE COUNTY IN JULY, 2011.
4. WELL LAT./LONG. (NAD'27) ESTABLISHED BY DGPS(SUBMETER MAPPING GRADE).


THIRD RUN  
UNION DISTRICT  
GRANT DISTRICT  
MURPHY DISTRICT  
MURPHY DISTRICT

31  
9



I THE UNDERSIGNED, HEREBY CERTIFY THAT THIS PLAT IS CORRECT TO THE BEST OF MY KNOWLEDGE AND BELIEF AND SHOWS ALL THE INFORMATION REQUIRED BY LAW AND THE REGULATIONS ISSUED AND PRESCRIBED BY THE DIVISION OF ENVIRONMENTAL PROTECTION.

P.S. 677  
*Gregory A. Smith*

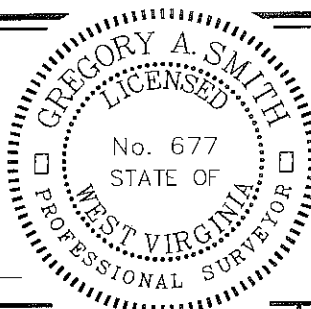

(+) DENOTES LOCATION OF WELL ON UNITED STATES TOPOGRAPHIC MAPS.  
DATE FEBRUARY 15, 20 12  
OPERATORS WELL NO. BLANEY NO. 1  
API NO. 47  
WELL NO. 085  
STATE COUNTY PERMIT 0857709

MINIMUM DEGREE OF ACCURACY 1/200  
PROVEN SOURCE OF ELEVATION DGPS (SUBMETER MAPPING GRADE)  
FILE NO. 7799P1(401-10)  
SCALE 1" = 500'

STATE OF WEST VIRGINIA  
DIVISION OF ENVIRONMENTAL PROTECTION  
OFFICE OF OIL AND GAS



WELL TYPE: OIL \_\_\_\_\_ GAS  LIQUID INJECTION \_\_\_\_\_ WASTE DISPOSAL \_\_\_\_\_ IF "GAS" PRODUCTION  STORAGE \_\_\_\_\_ DEEP \_\_\_\_\_ SHALLOW

LOCATION:  
ELEVATION 917' WATERSHED THIRD RUN  
DISTRICT GRANT COUNTY RITCHIE QUADRANGLE HARRISVILLE 7.5'

SURFACE OWNER RONALD & SHELIA LAYFIELD ACREAGE 53.25±  
ROYALTY OWNER FOSTER ETAL LEASE ACREAGE 53.25±  
PROPOSED WORK: LEASE NO. \_\_\_\_\_

DRILL \_\_\_\_\_ CONVERT \_\_\_\_\_ DRILL DEEPER \_\_\_\_\_ REDRILL \_\_\_\_\_ FRACTURE OR STIMULATE \_\_\_\_\_ PLUG OFF OLD FORMATION \_\_\_\_\_ PERFORATE NEW FORMATION \_\_\_\_\_ PLUG AND ABANDON  CLEAN OUT AND REPLUG \_\_\_\_\_ OTHER \_\_\_\_\_  
PHYSICAL CHANGE IN WELL (SPECIFY) \_\_\_\_\_ TARGET FORMATION SHALE  
ESTIMATED DEPTH 4,521'

WELL OPERATOR XTO ENERGY DESIGNATED AGENT GEARY BEALL  
ADDRESS P.O. BOX 1008 ADDRESS P.O. BOX 1008  
JANE LEW, WV 26378 JANE LEW, WV 26378 04/13/2012

COUNTY NAME PERMIT

BLANEY LEASE  
WELL NO. 1  
47-085-7709

BLANEY #1  
47-085-7709

*July 30-12*

SCALE 1" = 500'



SMITH LAND SURVEYING, INC.  
P.O. BOX 150 GLENVILLE, WV, 26351

PH(304)462-5634 FAX(304)462-5656 E-MAIL: sls@slssurveys.com

TOPO SECTION OF USGS  
HARRISVILLE 7.5' QUADRANGLE

DRAWN BY C.P.M.	FILE NO. 7799	DATE 02-15-12	CADD FILE: 7799REC1.DWG
--------------------	------------------	------------------	----------------------------