


39° 10'

Latitude

5° 18'

7.5' loc

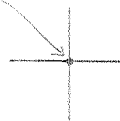

Longitude

Topo Location

7.5' Loc. 0.665 15' Loc. _____
0.684 (calc.) _____

Company _____

Farm Tharp #9

15' Quad Harrisville
(sec.) _____

7.5' Quad Harrisville


District Murphy

WELL LOCATION PLAT

County 085 Permit 8218-N

INSTRUCTIONS

3500

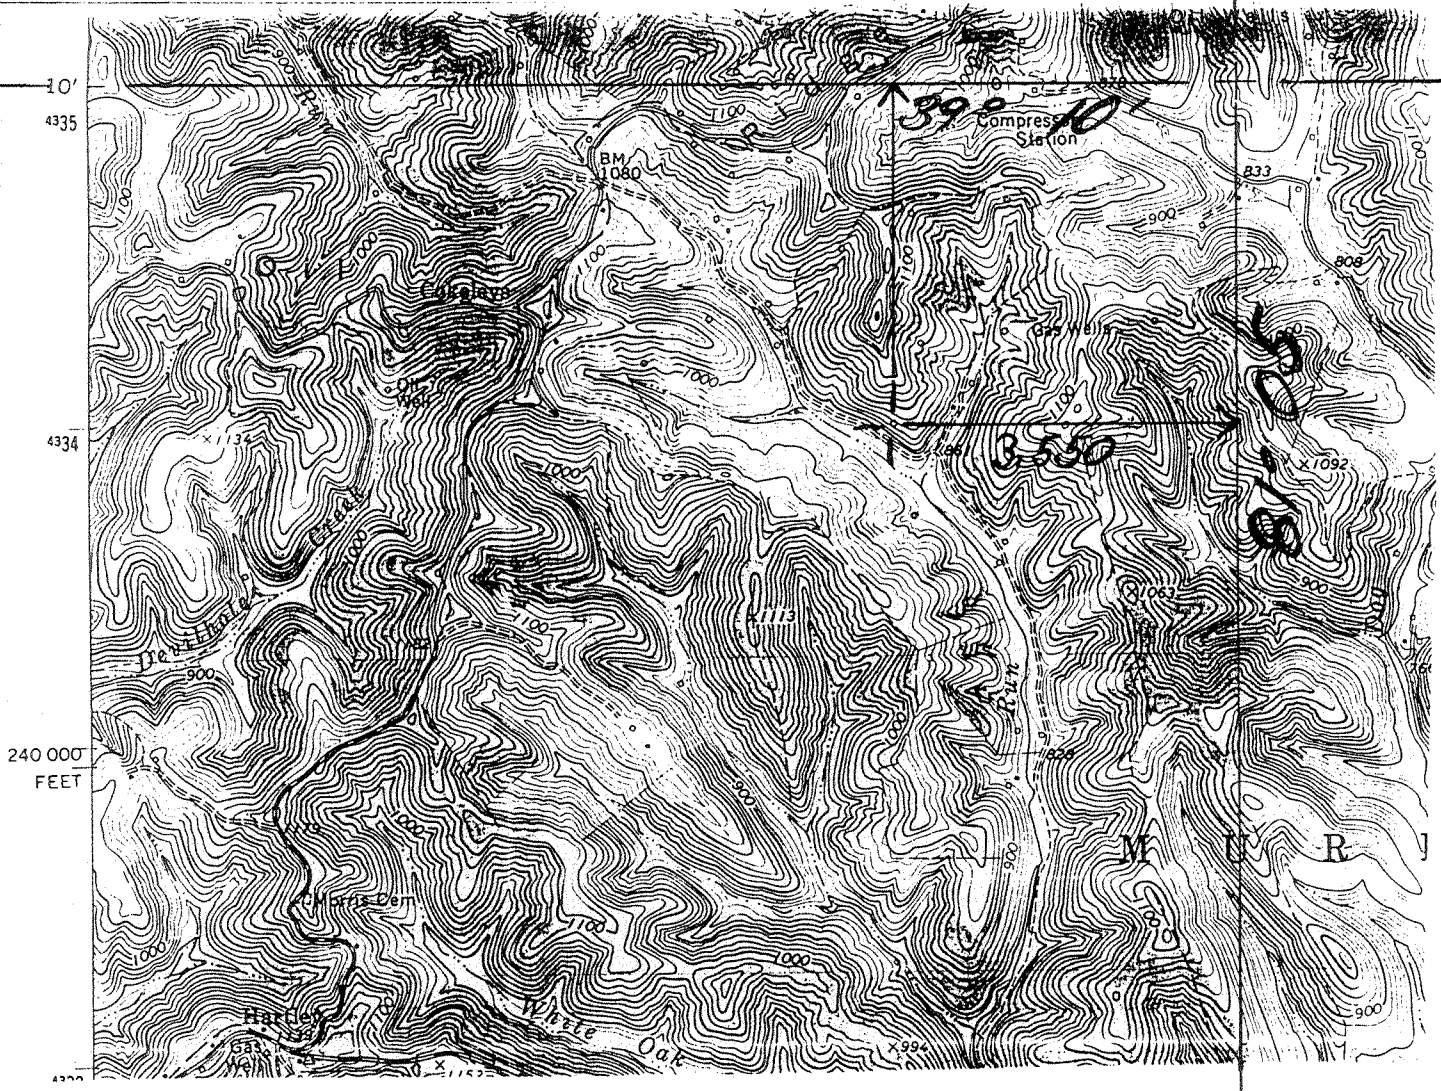

I, the undersigned, Hereby certify that this plat is correct to the best of my knowledge and belief.

SIGNED Howard H Elder
 dba H H Elder & Son
 TITLE Owner

16767

RECEIVED
 WV Division of
 Environmental Protection
 JAN 26 93
 Permitting
 Office of Oil & Gas

DATE Dec 29, 19 92
 OPERATORS WELL NO. g (Tharp)
 API WELL NO. 47-085-8218-N

STATE OF WEST VIRGINIA
 DEPARTMENT OF ENERGY
 OIL AND GAS DIVISION

WELL TYPE: OIL GAS x LIQUID INJECTION WASTE DISPOSAL
 (if "GAS" PRODUCTION x STORAGE DEEP SHALLOW x)

LOCATION: ELEVATION 960 Est WATER SHED Indian Run
 DISTRICT Murphy COUNTY Ritchie
 QUADRANGLE Harrisville 7.5

SURFACE OWNER O Sennet ACREAGE 130
 OIL & GAS ROYALTY OWNER Sigler, Moats, Sigler LEASE ACREAGE 130
 LEASE NO. LB 42 Page 47

PRODUCING FORMATION Indiana TOTAL DEPTH 1790

WELL OPERATOR H H Elder & Som DESIGNATED AGENT
 ADDRESS Rt 1, Box 257 ADDRESS HARRISVILLE 7
Cairo, Wv 26337

NOV 5 1993