


Latitude

39°10'

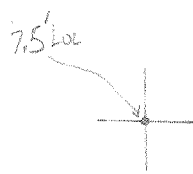

81°05'

Longitude

Topo Location

7.5' Loc. 0.49 S 15' Loc. _____
0.45 W (calc.) _____

Company _____

Farm Thorp #16

15' Quad _____
(sec.)


7.5' Quad Harrisonville

District Murphy

WELL LOCATION PLAT

County 085 Permit 8723-N

← 39° 10"

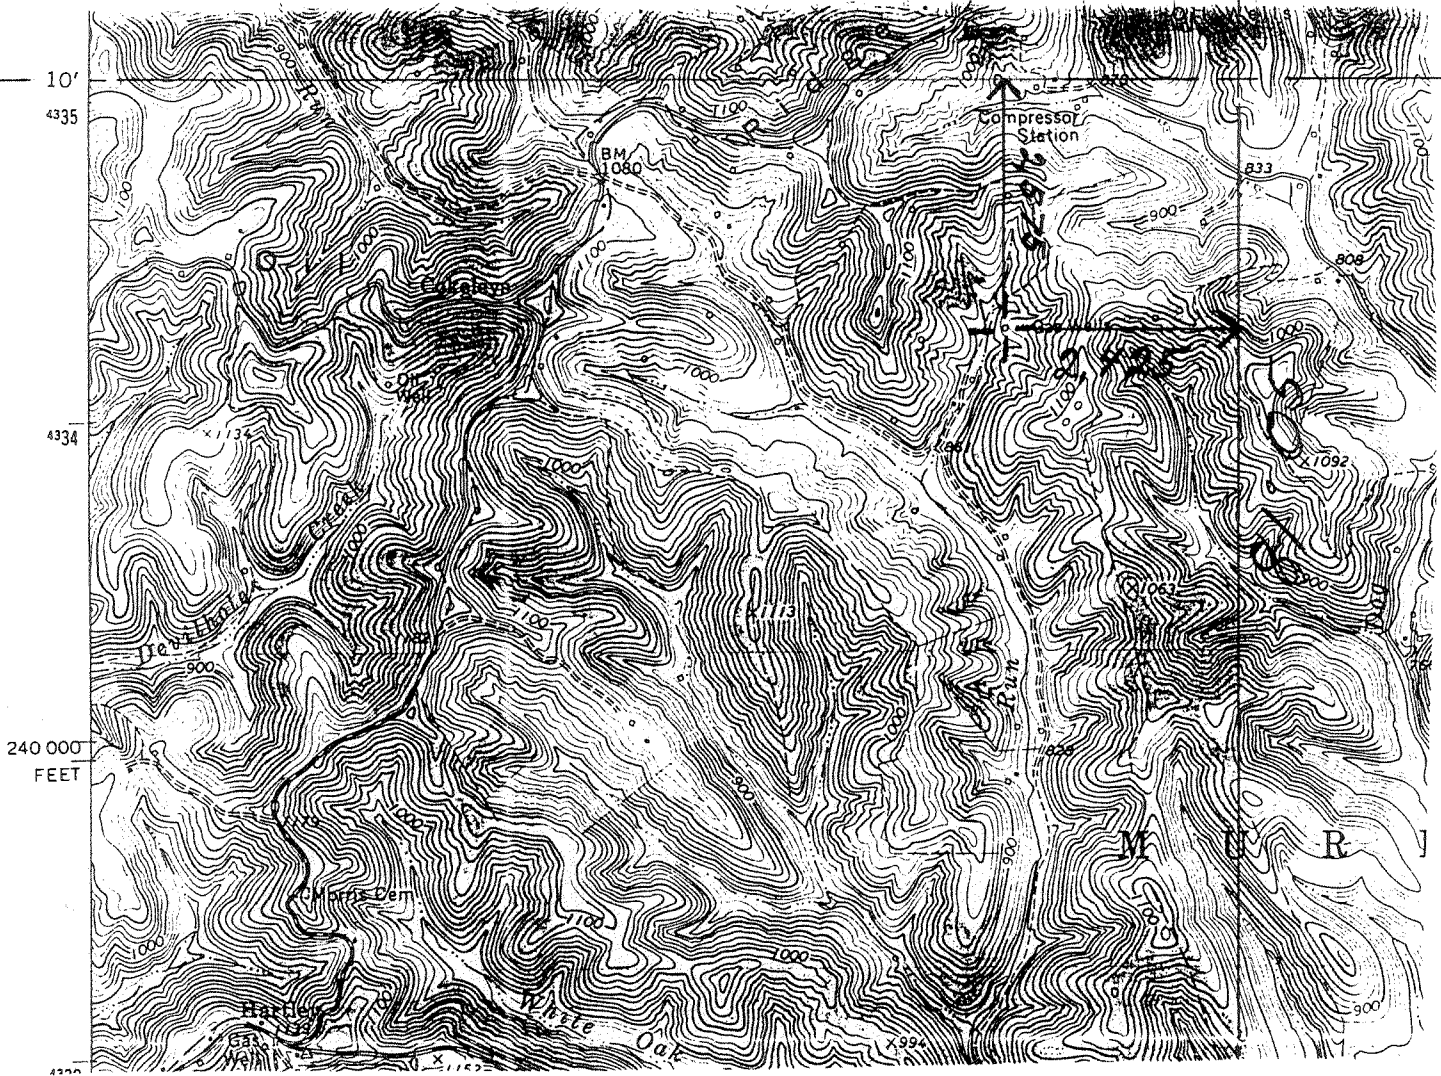

I, the undersigned, hereby certify that this plat is correct to the best of my knowledge and belief.

SIGNED Howard A. Elder
 dba H H Elder & Son
 TITLE Owner

16772

RECEIVED

WV Division of Environmental Protection

JAN 26 93

Permitting Office of Oil & Gas

DATE Dec 29, 19 92

OPERATORS WELL NO. 16 (Tharp)

API WELL NO. 47-085-8223-N

STATE OF WEST VIRGINIA
 DEPARTMENT OF ENERGY
 OIL AND GAS DIVISION

WELL TYPE: OIL GAS X LIQUID INJECTION WASTE DISPOSAL
 (if "GAS" PRODUCTION X STORAGE DEEP SHALLOW X)

LOCATION: ELEVATION 930 EST WATER SHED Indian Run
 DISTRICT Murphy COUNTY Ritchie
 QUADRANGLE Harrisville 7.5

SURFACE OWNER O Sennett ACREAGE 130

OIL & GAS ROYALTY OWNER Sigler, Moats, Sigler LEASE ACREAGE 130
 LEASE NO. LB 42 Page 47

PRODUCING FORMATION Injun TOTAL DEPTH 1760

WELL OPERATOR H H Elder & Son DESIGNATED AGENT

ADDRESS Rt 1, Box 257 ADDRESS HARRISVILLE 7
Cairo, WV 26337

1993