



West Virginia Department of Environmental Protection  
Office of Oil and Gas  
**WELL LOCATION FORM: GPS**

API: 47-085-09139 WELL NO.: 10

FARM NAME: J.L. Mullenax

RESPONSIBLE PARTY NAME: Virco

COUNTY: Ritchie DISTRICT: Grant

QUADRANGLE: Cairo

SURFACE OWNER: Alvin Payne & Carlin L. Payne

ROYALTY OWNER: Alvin Payne & Carlin L. Payne

UTM GPS NORTHING: 4,331,497.60

UTM GPS EASTING: 483,225.60 GPS ELEVATION: 1154'

The Responsible Party named above has chosen to submit GPS coordinates in lieu of preparing a new well location plat for a plugging permit or assigned API number on the above well. The Office of Oil and Gas will not accept GPS coordinates that do not meet the following requirements:

- Datum: NAD 1983, Zone: 17 North, Coordinate Units: meters, Altitude: height above mean sea level (MSL) – meters.
- Accuracy to Datum – 3.05 meters
- Data Collection Method:

Survey grade GPS  : Post Processed Differential \_\_\_\_\_

Real-Time Differential

Mapping Grade GPS \_\_\_\_\_ : Post Processed Differential \_\_\_\_\_

Real-Time Differential \_\_\_\_\_

RECEIVED  
Office of Oil and Gas  
MAY 28 2021  
WV Department of  
Environmental Protection


- Letter size copy of the topography map showing the well location.**

I the undersigned, hereby certify this data is correct to the best of my knowledge and belief and shows all the information required by law and the regulations issued and prescribed by the Office of Oil and Gas.

Brittany Nbody  
Signature

Senior Regulatory Analyst  
Title

5/27/21  
Date

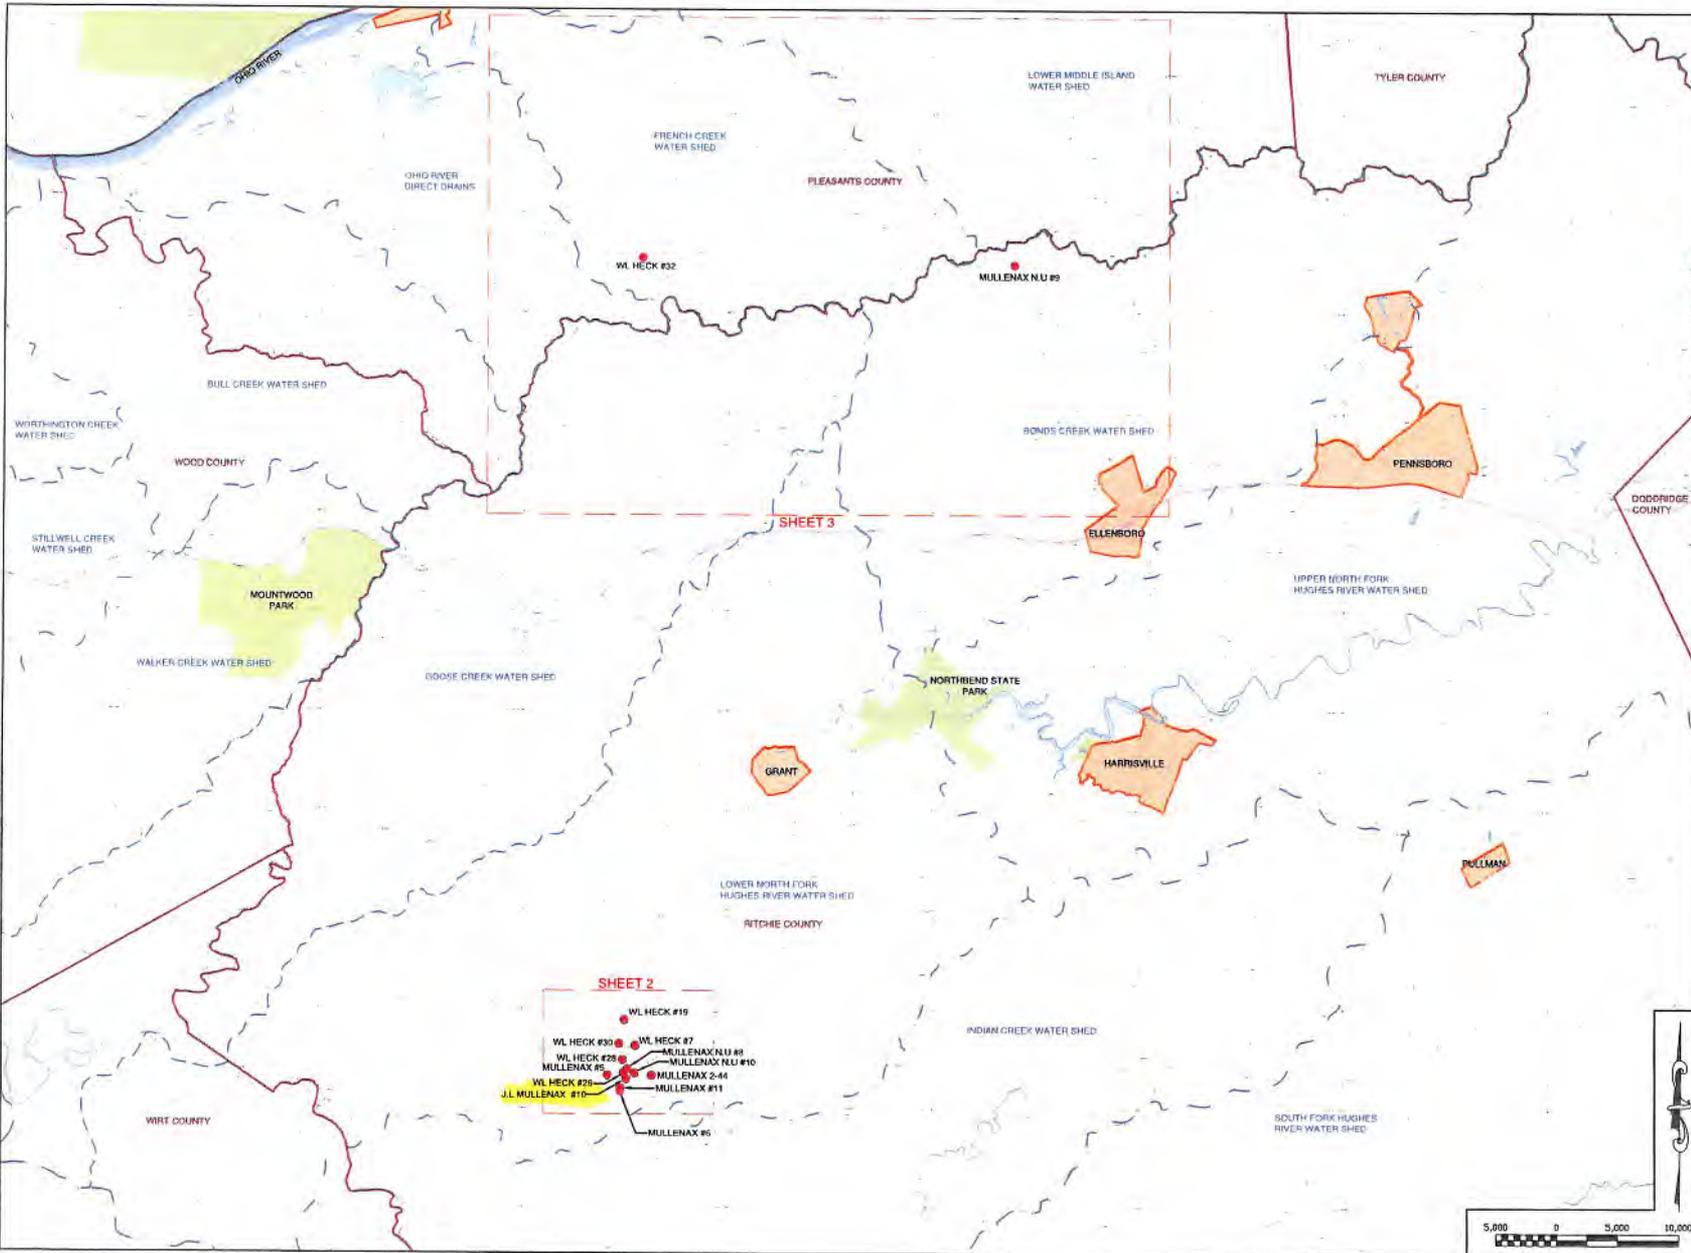

LOCATION MAP NOT TO SCALE

6	
5	
4	
3	
2	
1	

NO.	DATE	DESCRIPTION
PREPARED FOR:		

SEAL:


PREPARED BY:

2361 DAWSON RUN ROAD, SUITE 133  
CLARKSBURG, WV 26301  
WWW.ASCENTCONSULTINGENGINEERS.COM  
(204) 293-3453

PROJECT NUMBER:	2412	DRAWN:	CMK
DATE:	4-13-21	DESIGN:	ZLA
SCALE:	AS SHOWN	CHECKED:	MRN

TITLE: **OVERALL PLUGGING MAP**

PLAN STATUS: SHEET NO. **1**

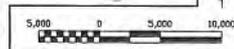

C:\P\15.9\Project 2412\Project Map SW\Drawings\2412-PLUGGING MAP.dwg  
 PLOT DATE/TIME: 4/21/2021 10:42 AM

47-085-09139P