

WW-7
8-30-06



West Virginia Department of Environmental Protection
Office of Oil and Gas
WELL LOCATION FORM: GPS

API: 47-085-09891 WELL NO.: 3

FARM NAME: Heartwood Forestland Fund

RESPONSIBLE PARTY NAME: SWN Production Company, LLC

COUNTY: Ritchie DISTRICT: Murphy

QUADRANGLE: Harrisville

SURFACE OWNER: State of WV, Department of Commerce/Division of Natural Resources

ROYALTY OWNER: State of WV, Department of Commerce/Division of Natural Resources

UTM GPS NORTHING: 4331135.92

UTM GPS EASTING: 491167.92 GPS ELEVATION: 907'

The Responsible Party named above has chosen to submit GPS coordinates in lieu of preparing a new well location plat for a plugging permit or assigned API number on the above well. The Office of Oil and Gas will not accept GPS coordinates that do not meet the following requirements:

1. Datum: NAD 1983, Zone: 17 North, Coordinate Units: meters, Altitude: height above mean sea level (MSL) – meters.
2. Accuracy to Datum – 3.05 meters
3. Data Collection Method:

Survey grade GPS : Post Processed Differential _____
Real-Time Differential

Mapping Grade GPS _____ : Post Processed Differential _____
Real-Time Differential _____

4. Letter size copy of the topography map showing the well location.

I the undersigned, hereby certify this data is correct to the best of my knowledge and belief and shows all the information required by law and the regulations issued and prescribed by the Office of Oil and Gas.

Brittany Woady
Signature

Senior Regulatory Analyst
Title



11/18/21
Date

RECEIVED
Office of Oil and Gas

NOV 19 2021

WV Department of
Environmental Protection

4708509891P

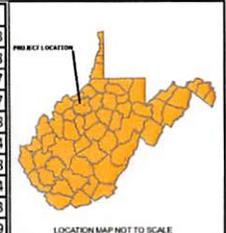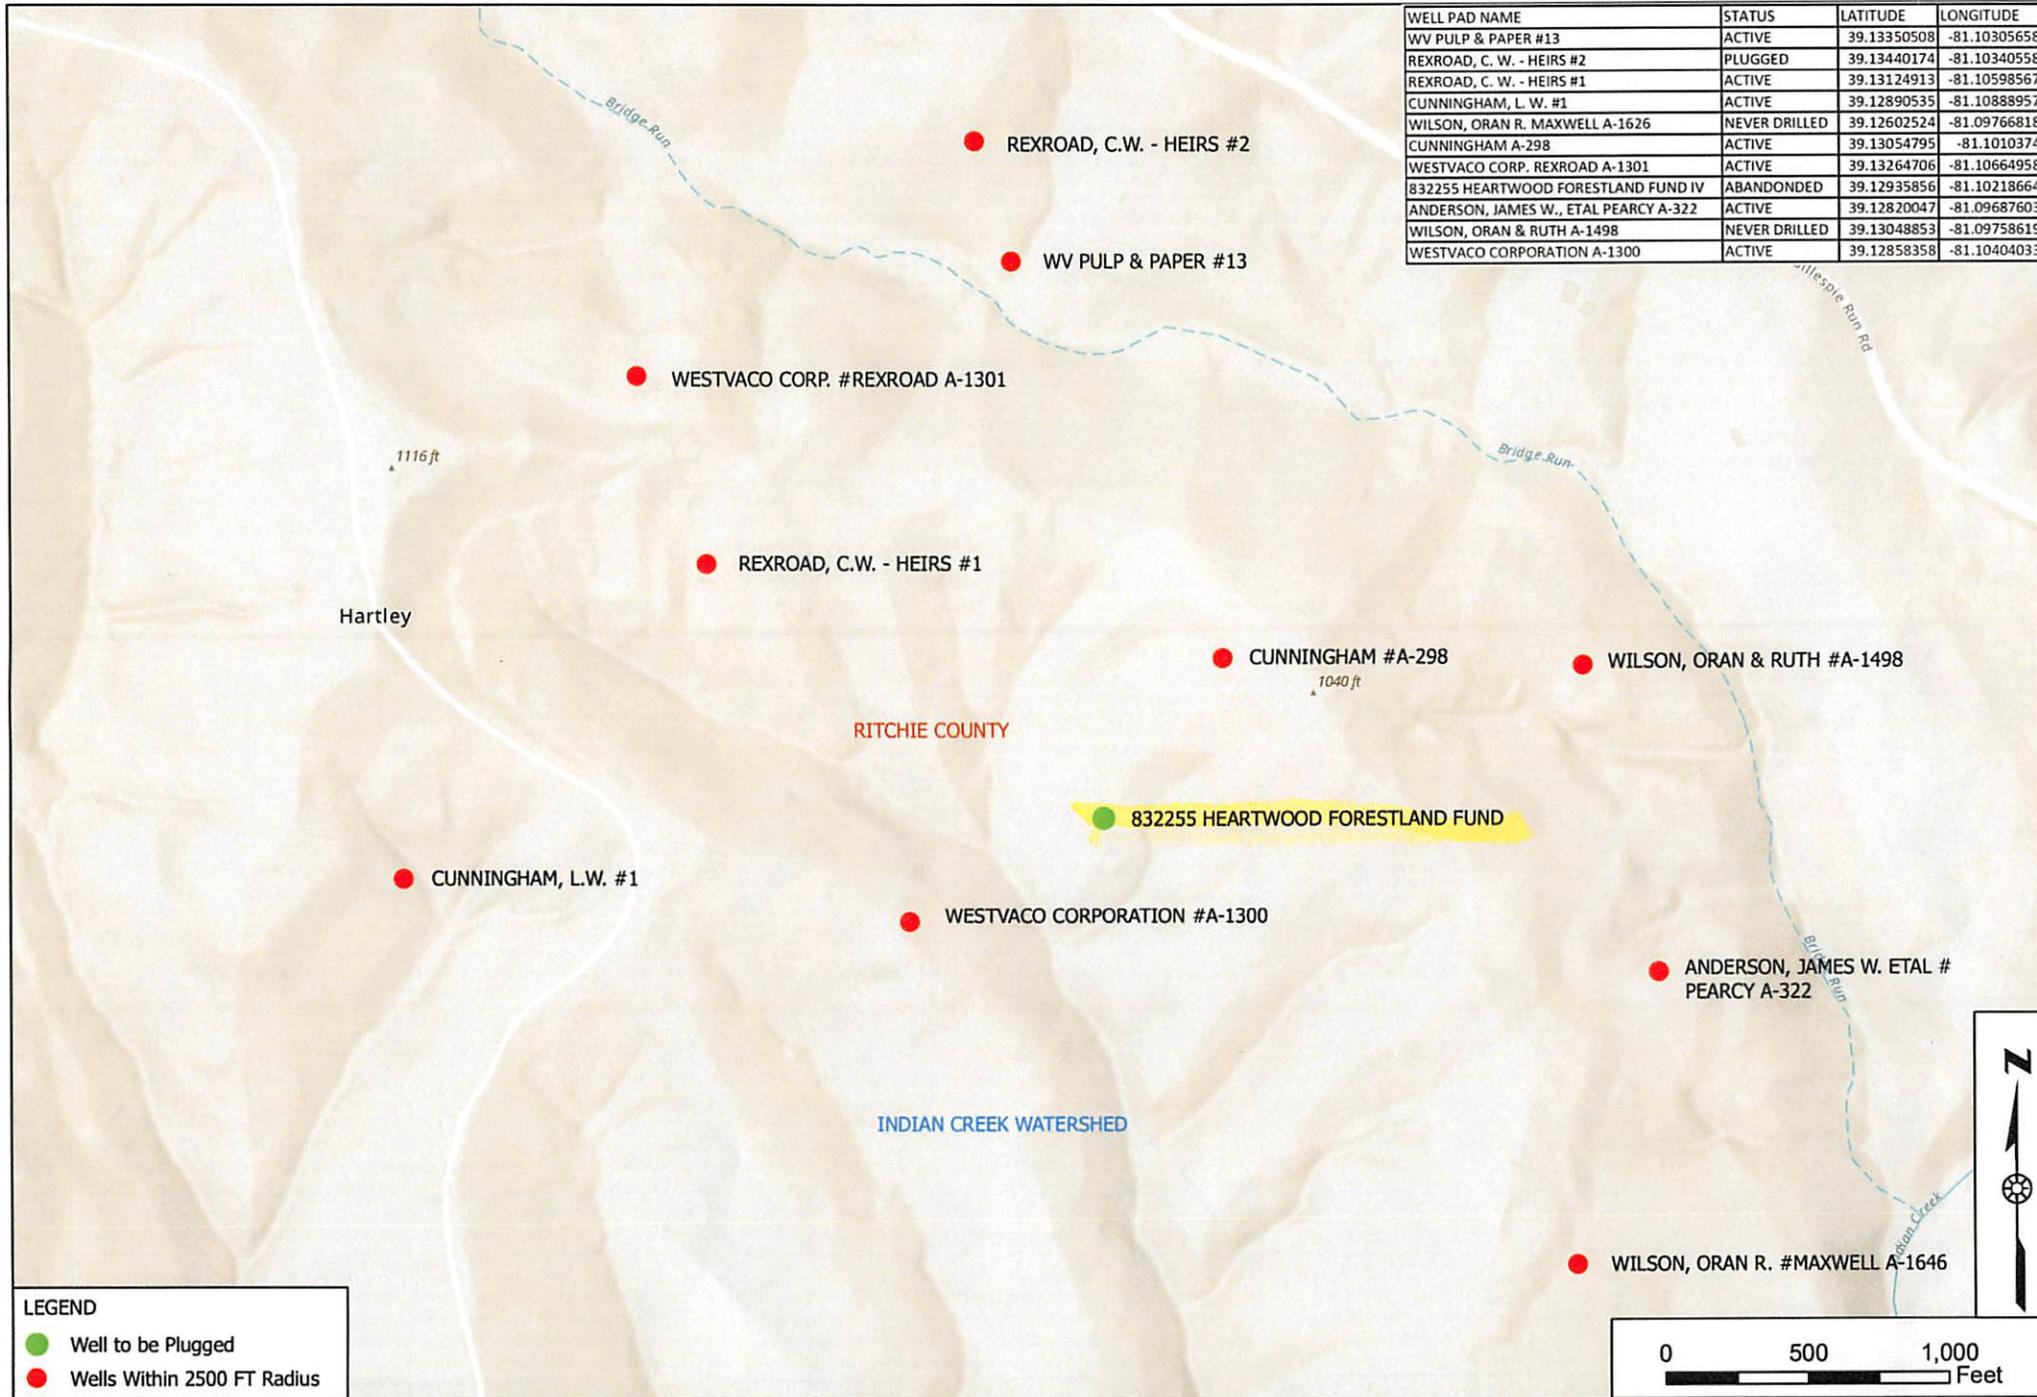

WELL PAD NAME	STATUS	LATITUDE	LONGITUDE
WV PULP & PAPER #13	ACTIVE	39.13350508	-81.10305658
REXROAD, C. W. - HEIRS #2	PLUGGED	39.13440174	-81.10340558
REXROAD, C. W. - HEIRS #1	ACTIVE	39.13124913	-81.10598567
CUNNINGHAM, L. W. #1	ACTIVE	39.12890535	-81.10888957
WILSON, ORAN R. MAXWELL A-1626	NEVER DRILLED	39.12602524	-81.09766818
CUNNINGHAM A-298	ACTIVE	39.13054795	-81.1010374
WESTVACO CORP. REXROAD A-1301	ACTIVE	39.13264706	-81.10664958
832255 HEARTWOOD FORESTLAND FUND IV	ABANDONED	39.12935856	-81.10218664
ANDERSON, JAMES W., ETAL PEARCY A-322	ACTIVE	39.12820047	-81.09687603
WILSON, ORAN & RUTH A-1498	NEVER DRILLED	39.13048853	-81.09758619
WESTVACO CORPORATION A-1300	ACTIVE	39.12858358	-81.10404033

6		
5		
4		
3		
2		
1		

NO. DATE DESCRIPTION

PREPARED FOR:

SEAL:

PREPARED BY:

2361 DAVENSON RUN ROAD
CLARKSBURG, WV 26301
WWW.ASCENTCONSULTINGENGINEERS.COM
(304) 933-2462

PROJECT NUMBER:	2699	DRAWN:	MVW
DATE:	11/8/2021	CHECKED:	AW
SCALE:	1:6,000	APPROVED:	

TITLE: **WELL PLUGGING MAP**

PLAN STATUS: Sheet No. **1**

LEGEND

- Well to be Plugged
- Wells Within 2500 FT Radius

RECEIVED
Office of Oil and Gas

NOV 19 2021

WV Department of
Environmental Protection