

WW-7  
8-30-06



West Virginia Department of Environmental Protection  
Office of Oil and Gas  
WELL LOCATION FORM: GPS

API: 47-085-09995P WELL NO.: M2  
FARM NAME: D. Filippo, Dennis N. & Debra  
RESPONSIBLE PARTY NAME: \_\_\_\_\_  
COUNTY: Ritchie DISTRICT: Murphy  
QUADRANGLE: Smithville 7.5'  
SURFACE OWNER: Dennis N. & Debra, D. Filippo  
ROYALTY OWNER: W. E. Cox Etal  
UTM GPS NORTHING: 432,0073.9  
UTM GPS EASTING: 496,001.5 GPS ELEVATION: 1148

The Responsible Party named above has chosen to submit GPS coordinates in lieu of preparing a new well location plat for a plugging permit or assigned API number on the above well. The Office of Oil and Gas will not accept GPS coordinates that do not meet the following requirements:

1. Datum: NAD 1983, Zone: 17 North, Coordinate Units: meters, Altitude: height above mean sea level (MSL) – meters.
2. Accuracy to Datum – 3.05 meters
3. Data Collection Method:  
Survey grade GPS \_\_\_\_\_: Post Processed Differential \_\_\_\_\_  
Real-Time Differential \_\_\_\_\_

Mapping Grade GPS X: Post Processed Differential X  
Real-Time Differential \_\_\_\_\_

4. Letter size copy of the topography map showing the well location.

I the undersigned, hereby certify this data is correct to the best of my knowledge and belief and shows all the information required by law and the regulations issued and prescribed by the Office of Oil and Gas.

Kalvin Black EVP 8/27/13  
Signature Title Date


Received  
AUG 27 2013  
Office of Oil and Gas  
WV Dept. of Environmental Protection

85.09995P

FORM WW-9

page 7 of 9

# Cox Lease Well No. M2

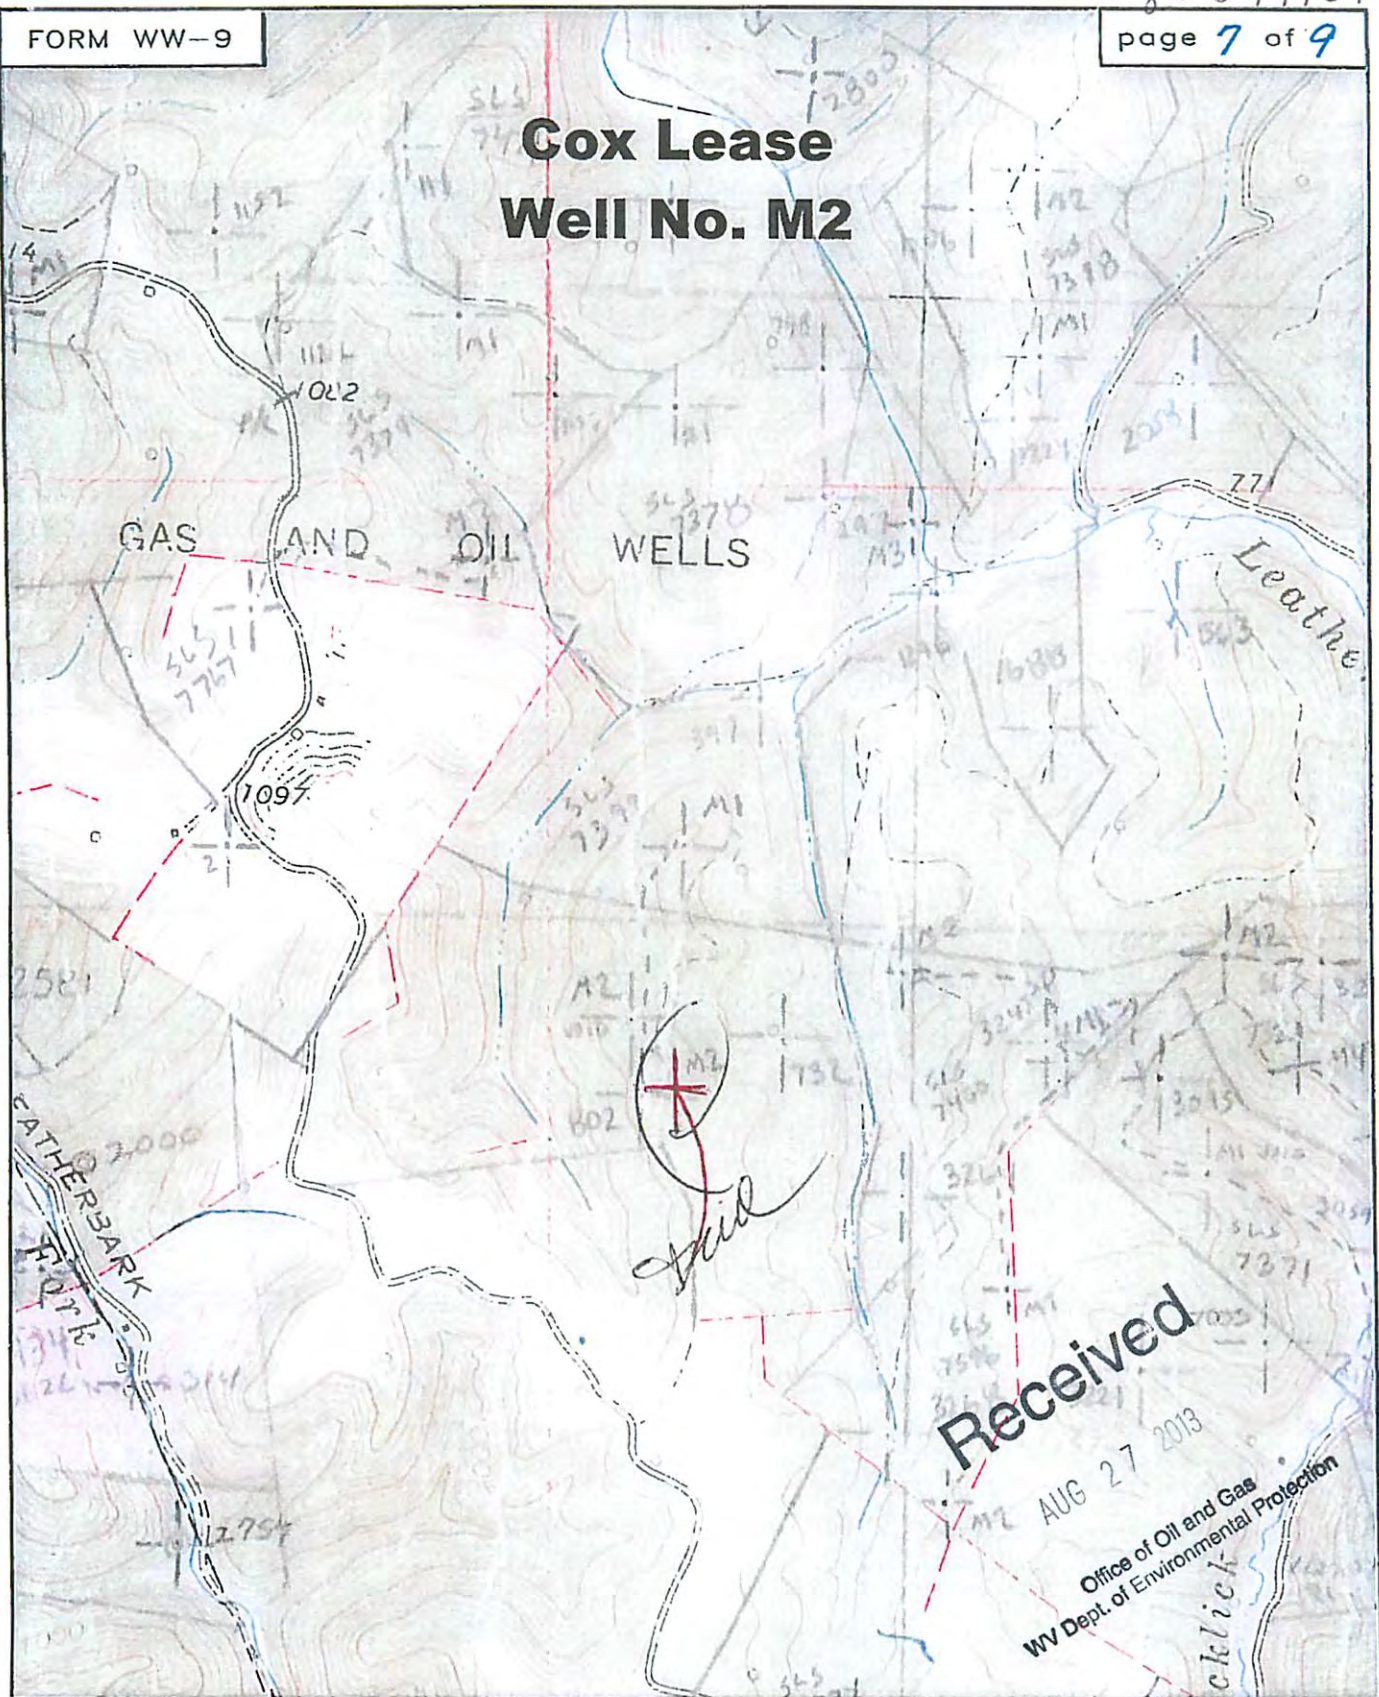

**Received**  
AUG 27 2013

Office of Oil and Gas  
WV Dept. of Environmental Protection  
*click*



SMITH LAND SURVEYING  
P.O. BOX 150 GLENVILLE, WV. 26351

TOPO SECTION OF SMITHVILLE 7.5'

FILE NO. 7398 DATE 12/22/11 SCALE 1"=1000'