

UTM NAD 83
top hole
N: 4345258.9
E: 491686.3

I certify that the Ritchie Hunter 2 well location is +400' from a lease line and +3000' for any existing deep well

FILE NO. _____
DRAWING NO. _____
SCALE 1" = 500'
MINIMUM DEGREE OF ACCURACY 1:200
PROVEN SOURCE OF ELEVATION GPS
OBSERVATION

I, THE UNDERSIGNED, HEREBY CERTIFY THAT THIS PLAT IS CORRECT TO THE BEST OF MY KNOWLEDGE AND BELIEF AND SHOWS ALL THE INFORMATION REQUIRED BY LAW AND THE REGULATIONS ISSUED AND PRESCRIBED BY THE DEPARTMENT OF ENERGY.

(SIGNED) _____
PROFESSIONAL SURVEYOR: 551



STATE OF WEST VIRGINIA
DEPARTMENT OF ENERGY
DIVISION OF OIL AND GAS

DATE OCTOBER 2ND, 2015
OPERATORS WELL NO. RITCHIE HUNTER 2

API 47 - 085 - 10142B
STATE COUNTY PERMIT

WELL TYPE: OIL ___ GAS ___ LIQUID INJECTION ___ WASTE DISPOSAL
(IF GAS) PRODUCTION ___ STORAGE ___ DEEP SHALLOW ___

LOCATION: ELEVATION 1014' WATER SHED HUSHERS RUN
DISTRICT GRANT COUNTY RITCHIE QUADRANGLE ELLENBORO

SURFACE OWNER PEARL EVERETT MASON & NATHANAEL LYLE MASON ACREAGE 84.27
OIL & GAS ROYALTY HAUGHT FAMILY TRUST LEASE AC 99

PROPOSED WORK: DRILL ___ CONVERT DRILL DEEPER ___ REDRILL ___
FRACTURE OR STIMULATE ___ PLUG OFF OLD FORMATION ___
PERFORATE NEW FORMATION ___
OTHER PHYSICAL CHANGE IN WELL ___
PLUG AND ABANDON ___ CLEAN OUT AND REPLUG ___


TARGET FORMATION ORISKANY ESTIMATED DEPTH 6270'

WELL OPERATOR HAUGHT ENERGY CORP. DESIGNATED AGENT WARREN HAUGHT
ADDRESS 12864 STAUNTON TURNPIKE ADDRESS 12864 STAUNTON TURNPIKE
SMITHVILLE, WV 26178 SMITHVILLE, WV 26178

FORM WW - 6

10/09/2015

COUNTY NAME
PREMIT

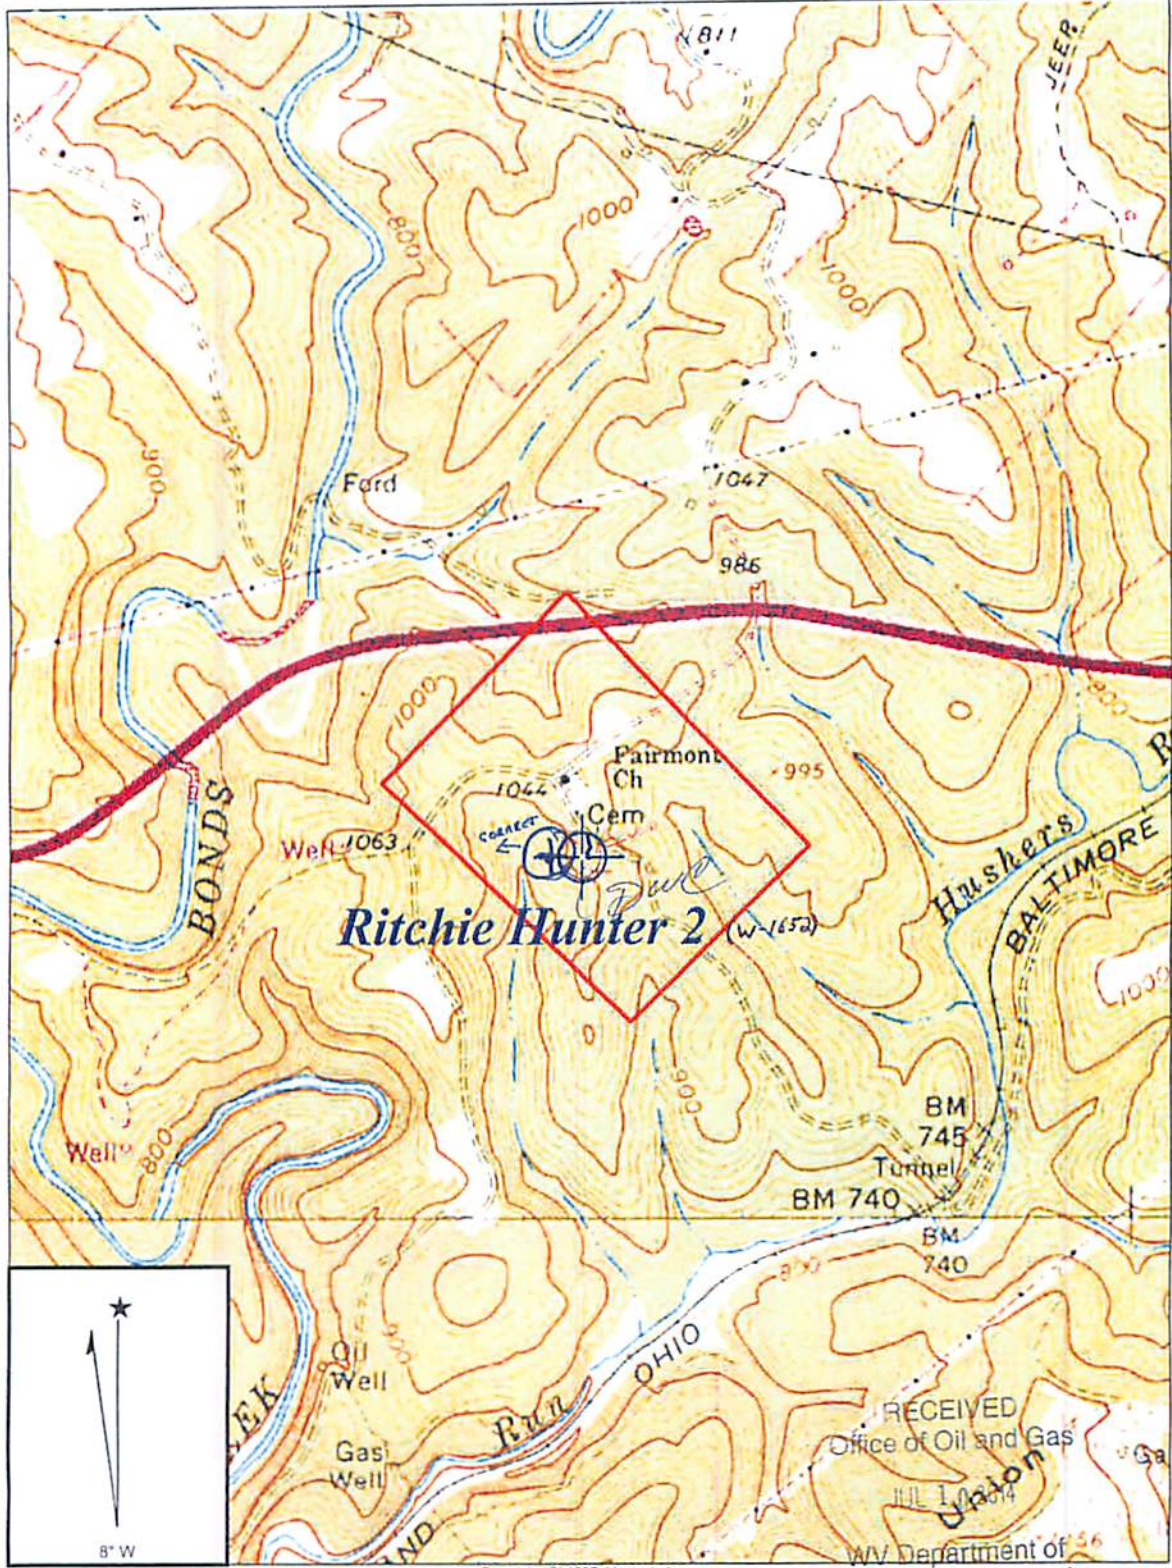

Copyright (C) 1997, Maptech, Inc

Environmental Protection

ELLENBORO QUADRANGLE

SCALE 1" = 1000'

HAUGHT ENERGY CORP.

WELL: RITCHIE HUNTER 2
HAUGHT FAMILY TRUST 99 ACRE LEASE

GRANT DISTRICT RITCHIE COUNTY WEST VIRGINIA

10/09/2015