

4708510312P

WW-7  
8-30-06



West Virginia Department of Environmental Protection  
Office of Oil and Gas  
**WELL LOCATION FORM: GPS**

API: 47-085-10312 WELL NO.: Raines 2H

FARM NAME: Bachelor

RESPONSIBLE PARTY NAME: Antero Resources Corporation

COUNTY: Ritchie DISTRICT: Clay

QUADRANGLE: Ellenboro & Pennsboro

SURFACE OWNER: Marion E. Bachelor, et al

ROYALTY OWNER: Frankie Bachelor et al; Donzil Leroy Baker; Donzil Leroy Baker et al; Donzil Leroy Baker et ux; Ann Anderson al; Gina M. Fielding; James E. Raines et al

UTM GPS NORTHING: 4351354.05 m

UTM GPS EASTING: 498697.69 m GPS ELEVATION: 1192.9 ft

The Responsible Party named above has chosen to submit GPS coordinates in lieu of preparing a new well location plat for a plugging permit or assigned API number on the above well. The Office of Oil and Gas will not accept GPS coordinates that do not meet the following requirements:

- Datum: NAD 1983, Zone: 17 North, Coordinate Units: meters, Altitude: height above mean sea level (MSL) – meters.
- Accuracy to Datum – 3.05 meters
- Data Collection Method:

Survey grade GPS X : Post Processed Differential \_\_\_\_\_  
Real-Time Differential X \_\_\_\_\_

Mapping Grade GPS X : Post Processed Differential \_\_\_\_\_  
Real-Time Differential X \_\_\_\_\_

RECEIVED  
Office of Oil and Gas

APR 26 2022

WV Department of  
Environmental Protection

- Letter size copy of the topography map showing the well location.


I the undersigned, hereby certify this data is correct to the best of my knowledge and belief and shows all the information required by law and the regulations issued and prescribed by the Office of Oil and Gas.

May SM  
Signature

Permitting Manager  
Title

4/14/22  
Date

06/17/2022

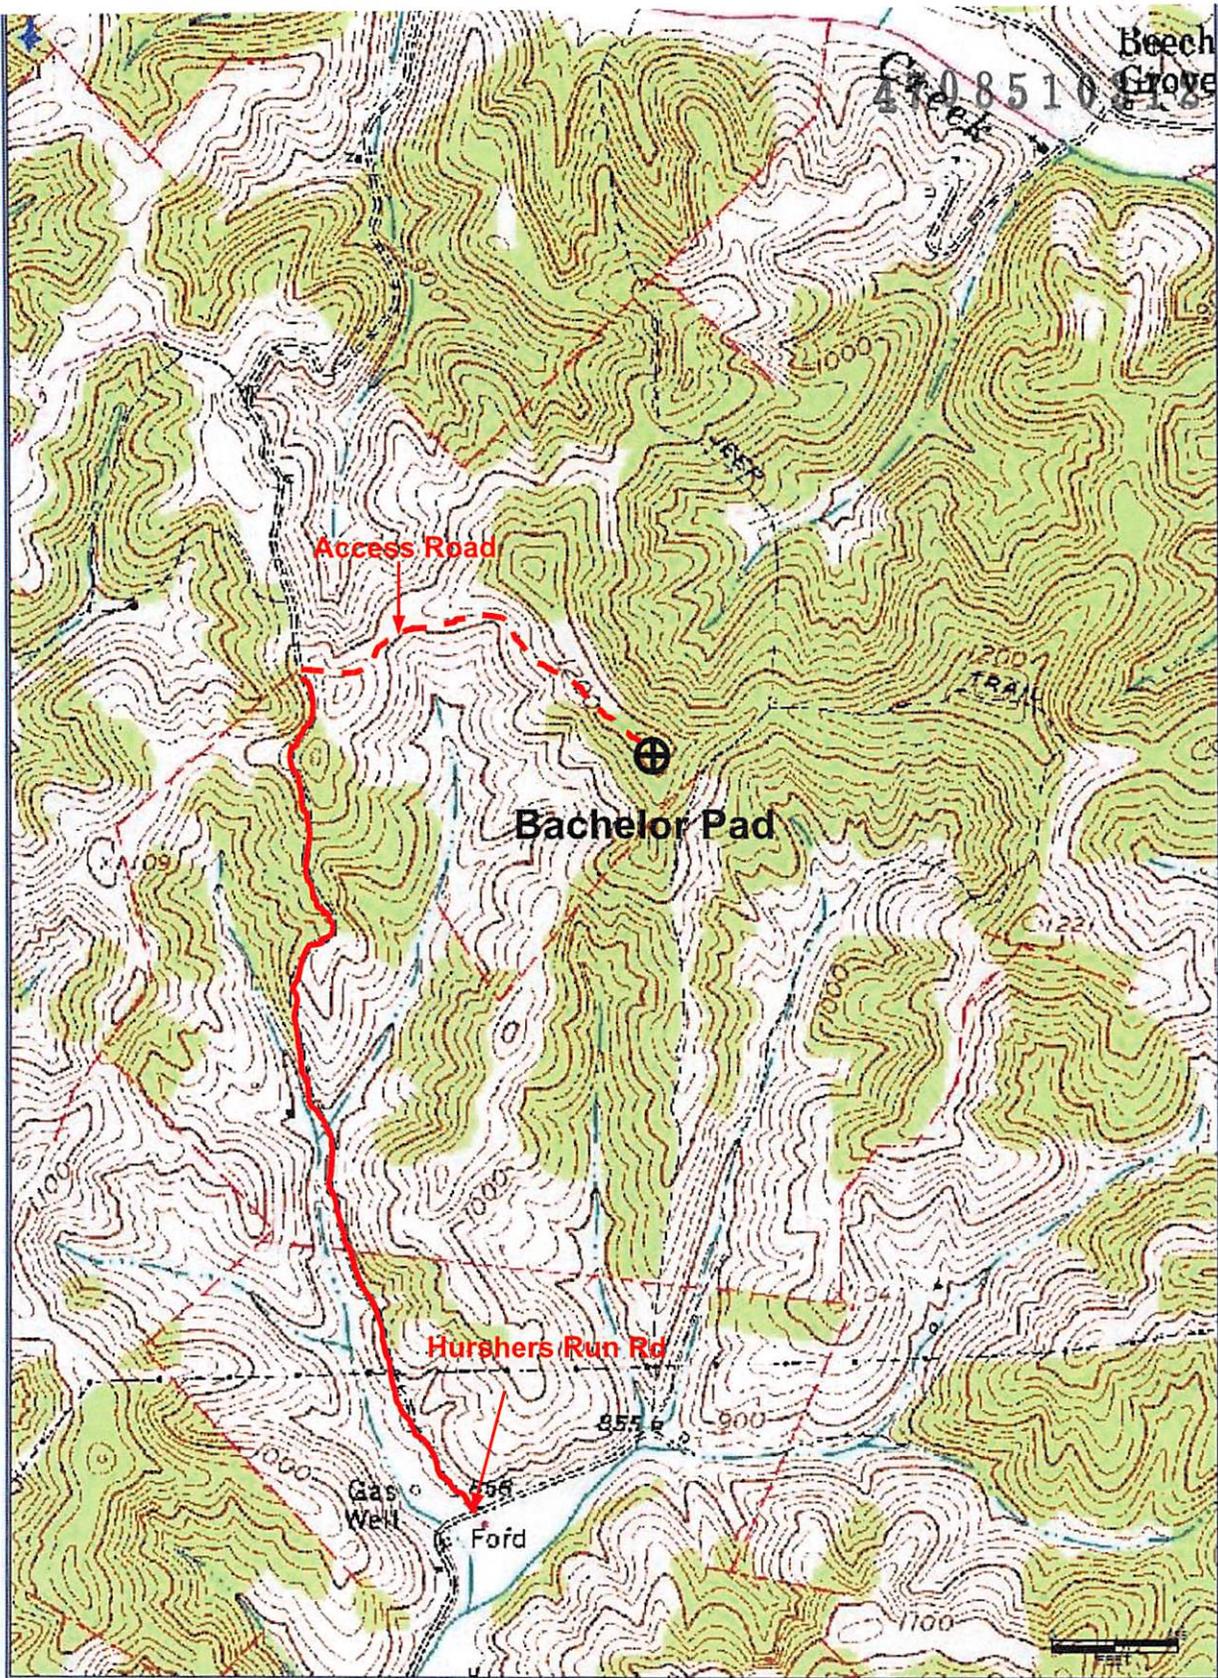

**Antero Resources Corporation**  
Appalachian Basin  
Bachelor Pad  
Ritchie County

Quadrangle: Ellenboro  
Watershed: North Fork Hughes River  
District: Clay

06/17/2022