

WW-7  
8-30-06



West Virginia Department of Environmental Protection  
Office of Oil and Gas

**WELL LOCATION FORM: GPS**

API: 4708510446 WELL NO.: Jones 1  
 FARM NAME: Mike Jones  
 RESPONSIBLE PARTY NAME: DEP Paid Plugging Contract  
 COUNTY: Ritchie DISTRICT: Grant  
 QUADRANGLE: Shultz  
 SURFACE OWNER: Mike Jones  
 ROYALTY OWNER: Andrew Lowther  
 UTM GPS NORTHING: 4 88 237  
 UTM GPS EASTING: 43 50 083 GPS ELEVATION: 936'

The Responsible Party named above has chosen to submit GPS coordinates in lieu of preparing a new well location plat for a plugging permit or assigned API number on the above well. The Office of Oil and Gas will not accept GPS coordinates that do not meet the following requirements:

1. Datum: NAD 1983, Zone: 17 North, Coordinate Units: meters, Altitude: height above mean sea level (MSL) – meters.
2. Accuracy to Datum – 3.05 meters
3. Data Collection Method:  
Survey grade GPS \_\_\_\_ : Post Processed Differential \_\_\_\_

Real-Time Differential \_\_\_\_

Mapping Grade GPS  : Post Processed Differential \_\_\_\_

Real-Time Differential \_\_\_\_

4. **Letter size copy of the topography map showing the well location.**

I the undersigned, hereby certify this data is correct to the best of my knowledge and belief and shows all the information required by law and the regulations issued and prescribed by the Office of Oil and Gas.

Bryan Harris

Inspector Specialist


Dec 15, 2022

Signature

Title

Date

4708510446

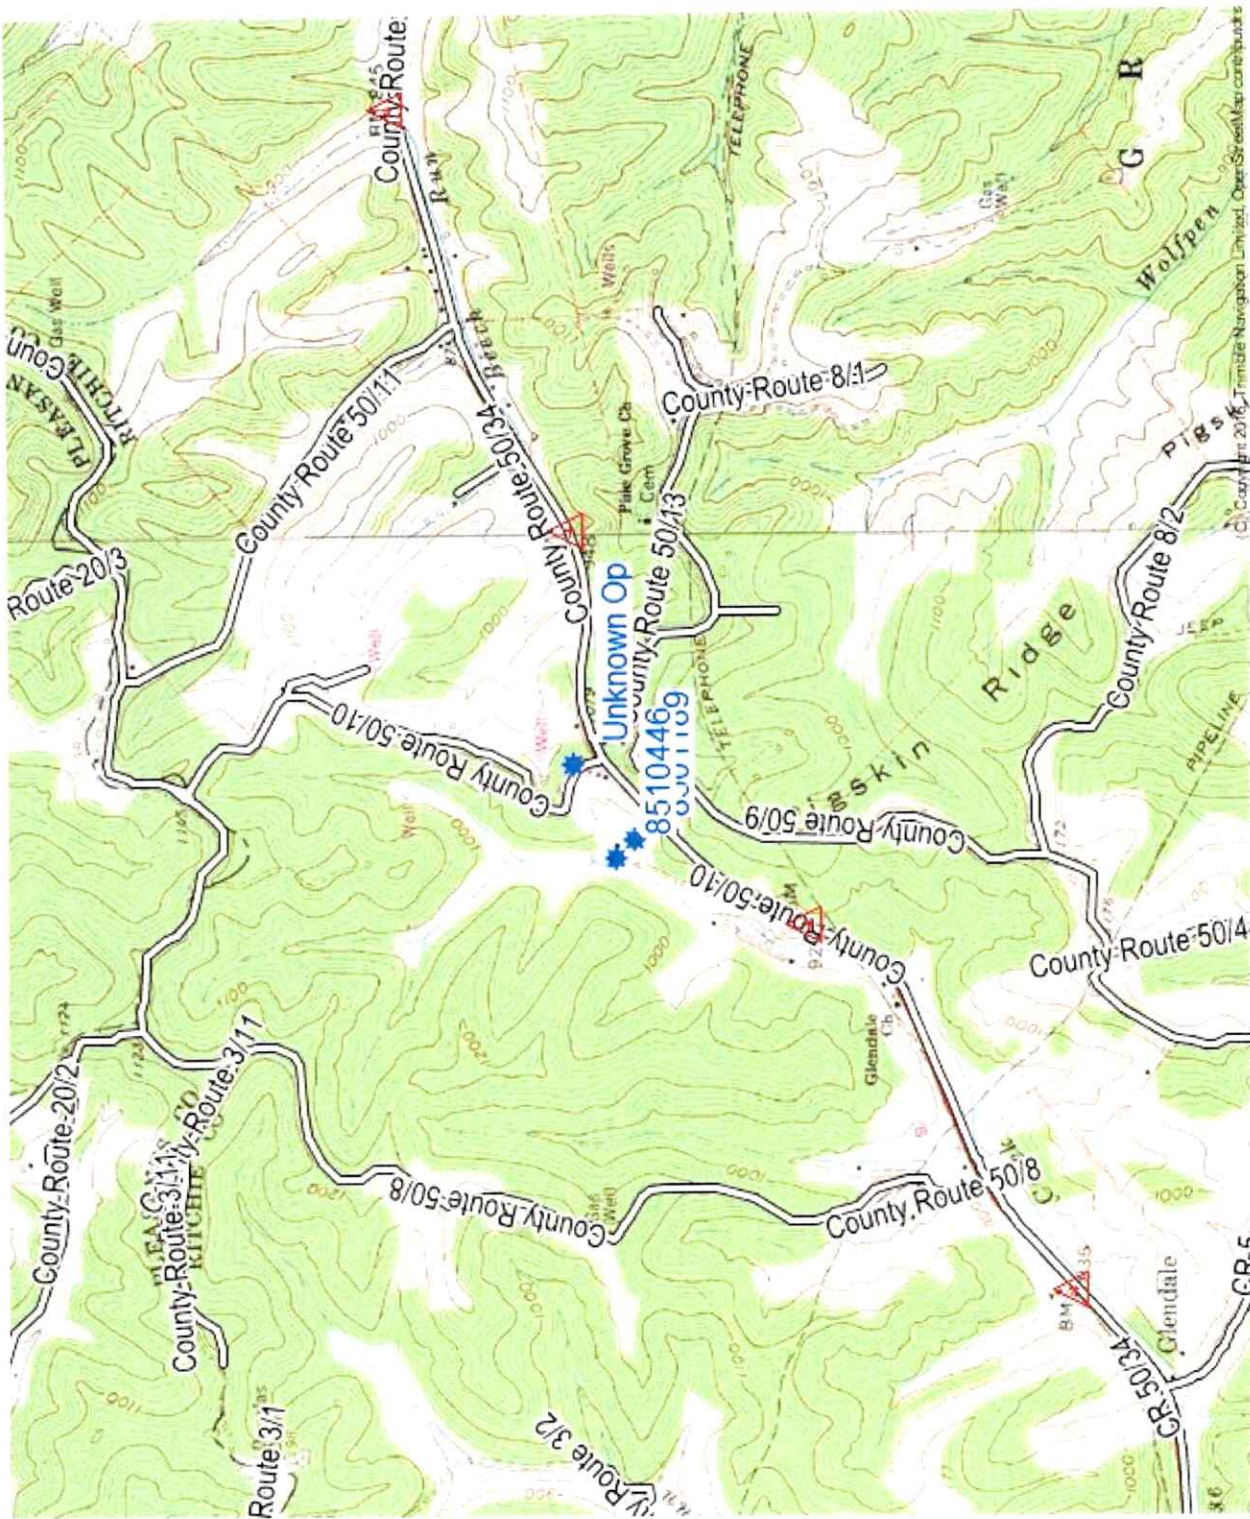

03/17/2023