


LATITUDE 39° 25'

LONGITUDE 80° 50'

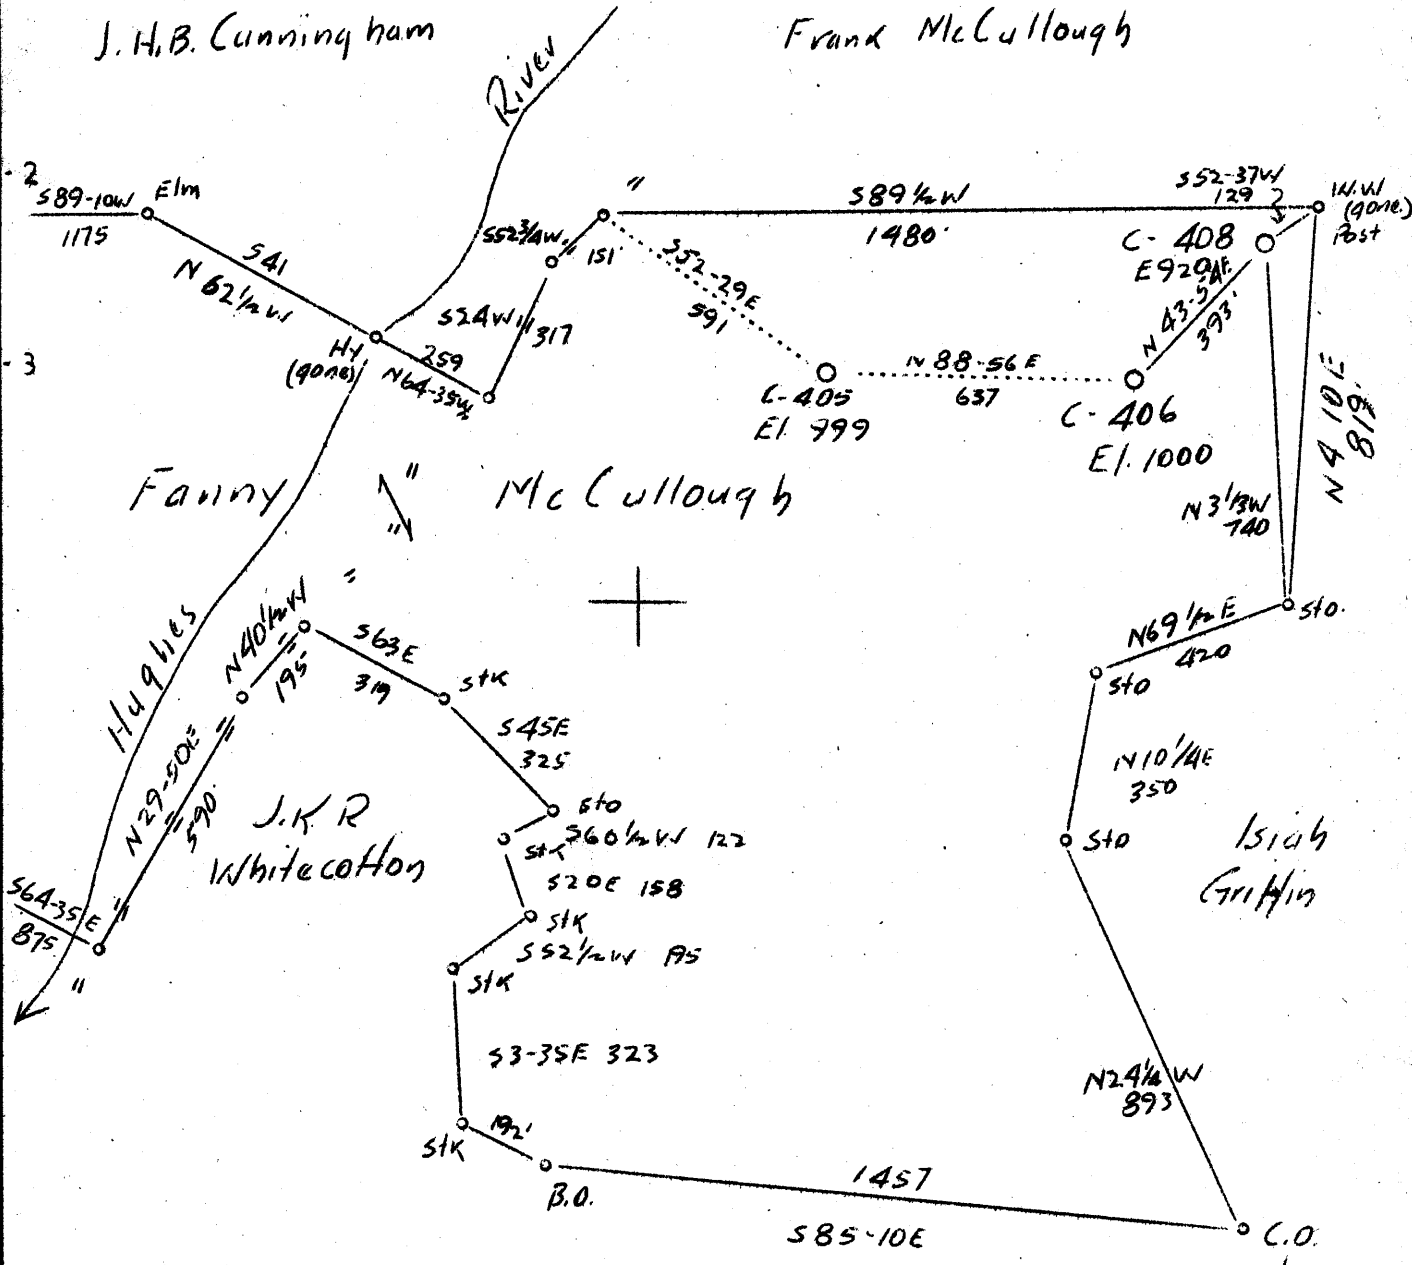

4.21 W
4.39 S

Abd. C-405

Company	Hope Const. & Ref. Co.
Address	Clarksburg, W.Va.
Farm	Fanny McCullough
Tract	Acres 153 Lease No. 23970
Well (Farm) No.	Serial No. C-405
	C-406
	C-408
Elevation (Spirit Level)	999', 1000', 920'
Quadrangle	West Union
County	Ritchie District Clay
Engineer	J.A. Clark
Engineer's Registration No.	744
File No.	Drawing No.
Date	Nov. 22, 1937 Scale 1"=400'

STATE OF WEST VIRGINIA
 Department of Mines
 OIL AND GAS DIVISION
 CHARLESTON

WELL LOCATION MAP

File No. RIT-335A

+ Denotes location of well on United States Topographic Maps, scale 1 to 62,500, latitude and longitude lines being represented by border lines as shown.

— Denotes one inch spaces on border line of original tracing.

