


LATITUDE 39° 10'

LONGITUDE 81° 10'

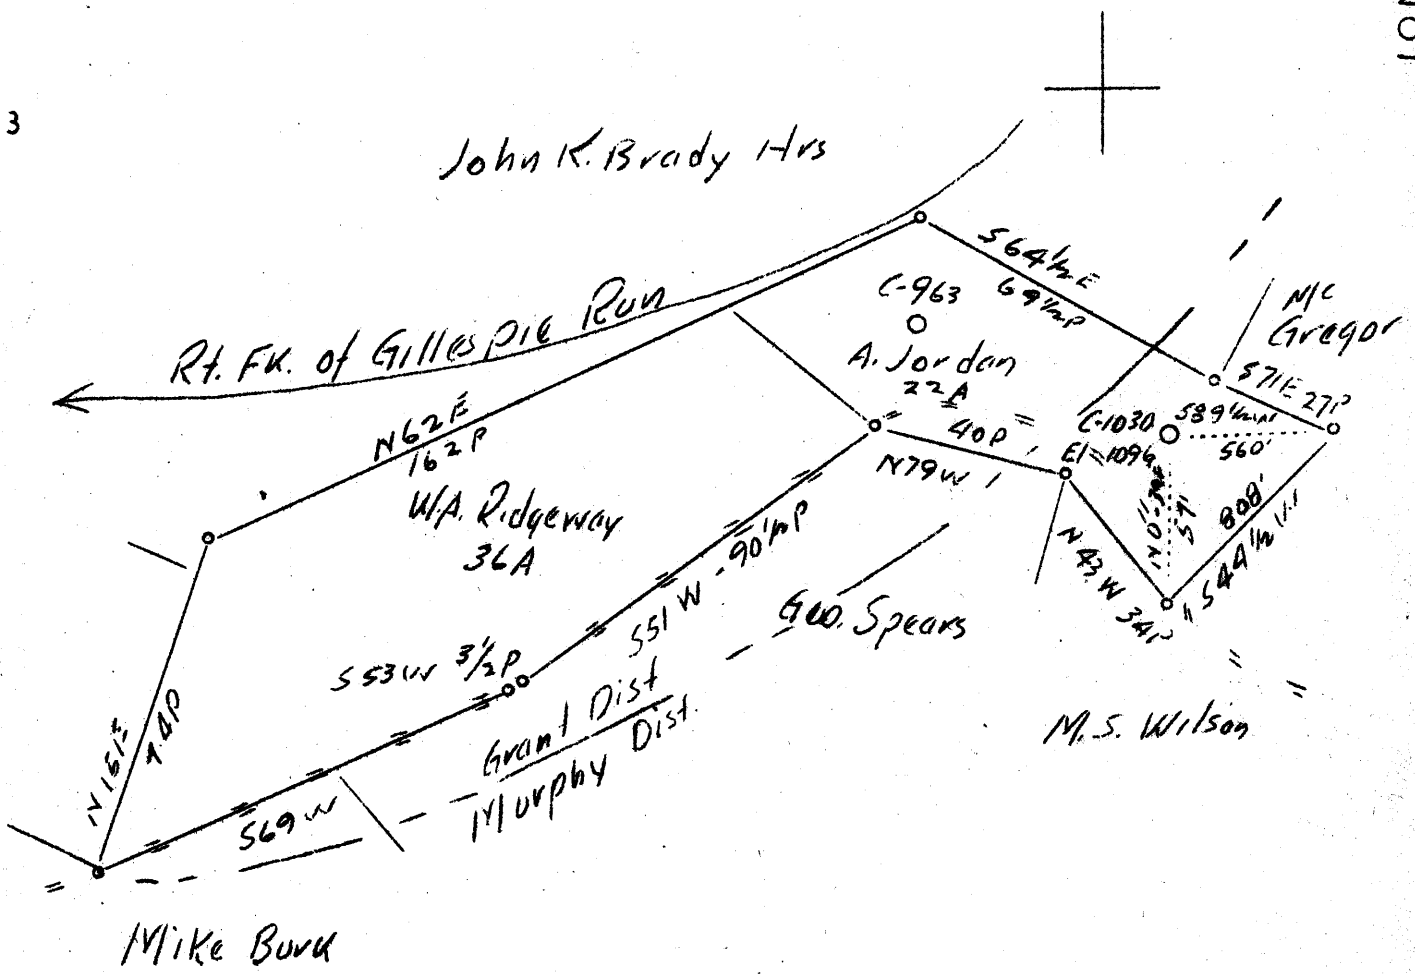

1.7 W
3.0 \$

Abd.

Company	Hope Constr. & Ref. Co.
Address	Clarksburg, W.Va.
Farm	Andrew Jordan
Tract	Acres 22 Lease No. 3540
Well (Farm) No.	2 Serial No. C-1030
Elevation (Spirit Level)	1096'
Quadrangle	Harrisville W 6
County	Ritchie District Murphy
Engineer	J.A. Clark
Engineer's Registration No.	744
File No.	Drawing No.
Date	12-9-37 Scale 1"=40 P.

STATE OF WEST VIRGINIA
Department of Mines
OIL AND GAS DIVISION
CHARLESTON

WELL LOCATION MAP
File No. RIT-338A

+ Denotes location of well on United States Topographic Maps, scale 1 to 62,500, latitude and longitude lines being represented by border lines as shown.

— Denotes one inch spaces on border line of original tracing.

