

0 1 2 3 LATITUDE 39° 15'


1

2

3

LONGITUDE 81° 00'

5
4

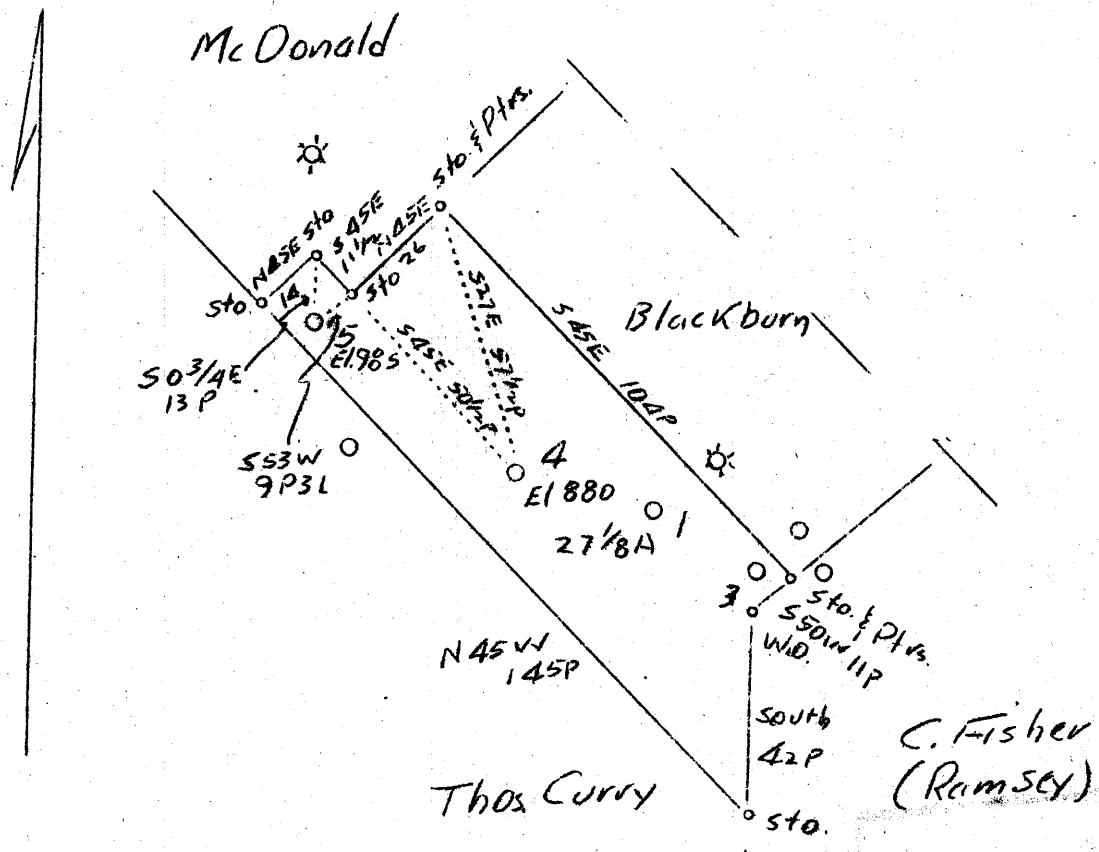

C. Fisher
(Ramsey)

No. 4	2.58W
	1.06S
No. 5	2.69W
	0.98S

Abds.

Company	Reno Oil Co.
Address	Sistersville, W.Va.
Farm	John Keith
Tract	Acres 27 1/8 Lease No.
Well (Farm) No.	No. 4 & 5 Serial No.
Elevation (Spirit Level)	880', 985'
Quadrangle	Harrisville NE.
County	Ritchie District Clay
Engineer	O.W. Barnhart
Engineer's Registration No.	
File No.	Drawing No.
Date	Feb. 2, 1938 Scale 1"=40 P.

STATE OF WEST VIRGINIA
Department of Mines
OIL AND GAS DIVISION
CHARLESTON

WELL LOCATION MAP
File No. **RIT-341A-342A**

+ Denotes location of well on United States Topographic Maps, scale 1 to 62,500, latitude and longitude lines being represented by border lines as shown.

— Denotes one inch spaces on border line of original tracing.

RECEIVED
FEB 22 1938
STATE OF VIRGINIA
GEOLOGICAL SURVEY